



PLAN
 DATE 11/1/30
 SHEET NO. 6 OF 6
 PROJECT NO. 17#125
 CONTRACTOR
 LOCATION

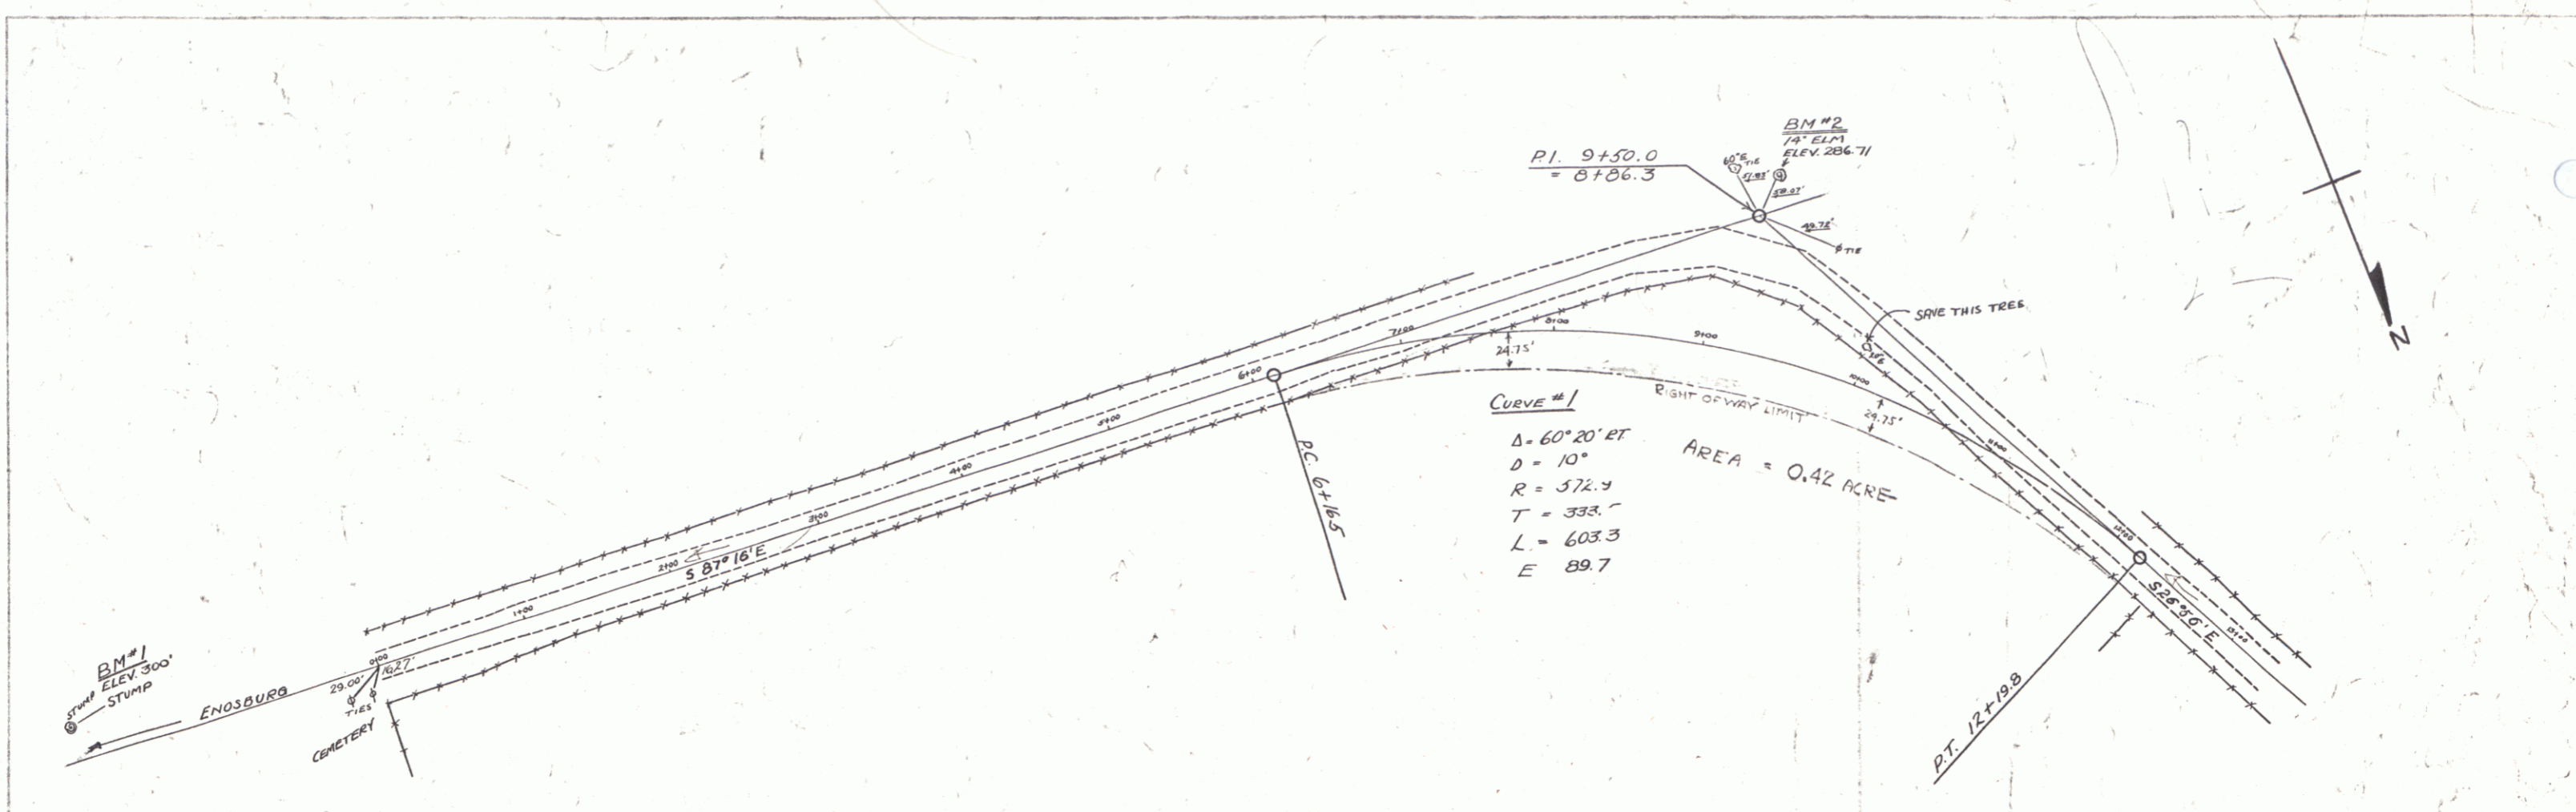

MP 7.460-6.835

Pin# 00R191
 Town: Sheldon
 Project No. Spooner Curve
 Rte VT 105
 Date: 1/1/30

PROJECT NUMBER	LENGTH	MI.
Sheldon		
TYPE		
CONTRACTOR		
LOCATION		

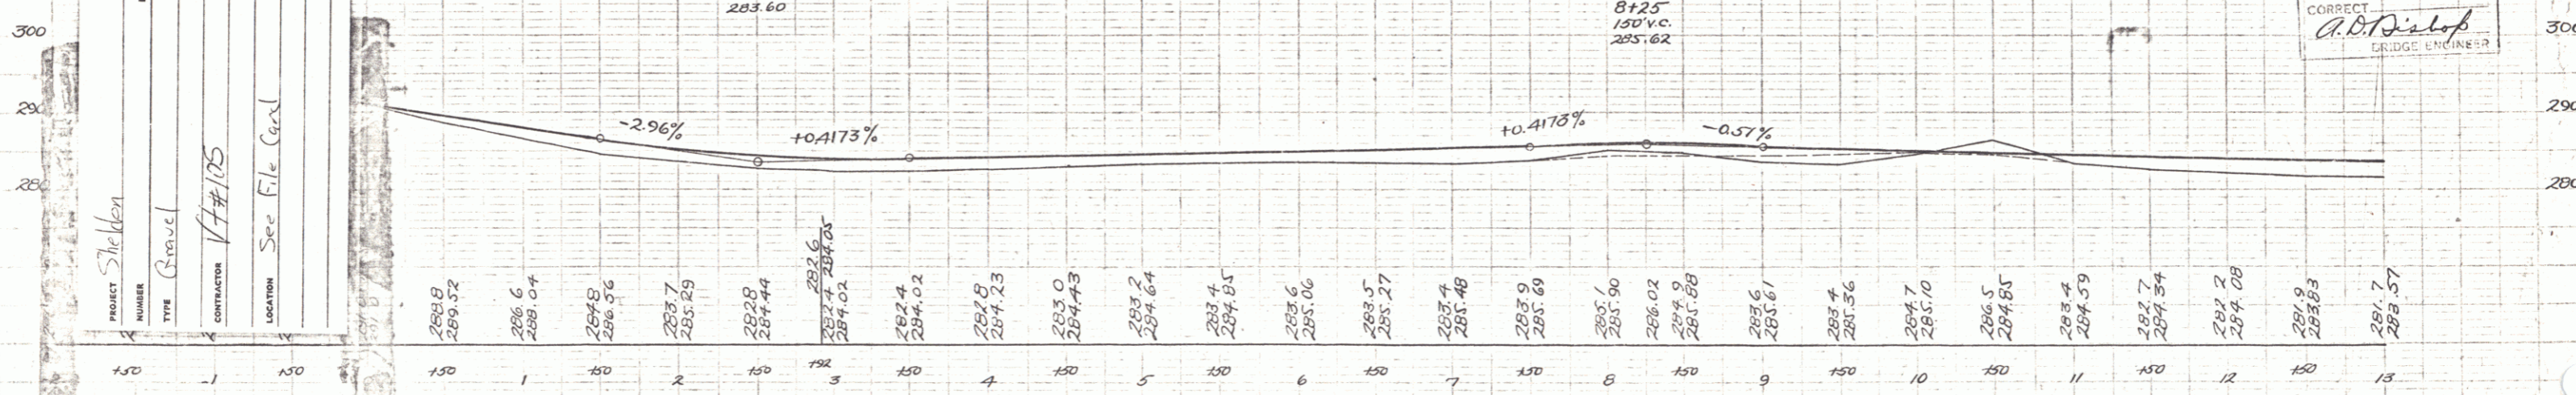

CORRECT
 A.B. Dialop
 BRIDGE ENGINEER

BM #1 STUMP 23' LEFT STATION ELEV. 300.0'
 BM #2 74" ELM. 25' LEFT STATION 25, ELEV. 286.71'

SCALE 1" = 50 FT.

TOWN OF SHELDON
 SPOONER CURVE
 NORTH SHELDON
 SHEET 6 OF 6