


PLAN
 DATE 3/23/00
 DRAWN BY [Signature]

BASE
 DATE 3/23/00
 DRAWN BY [Signature]

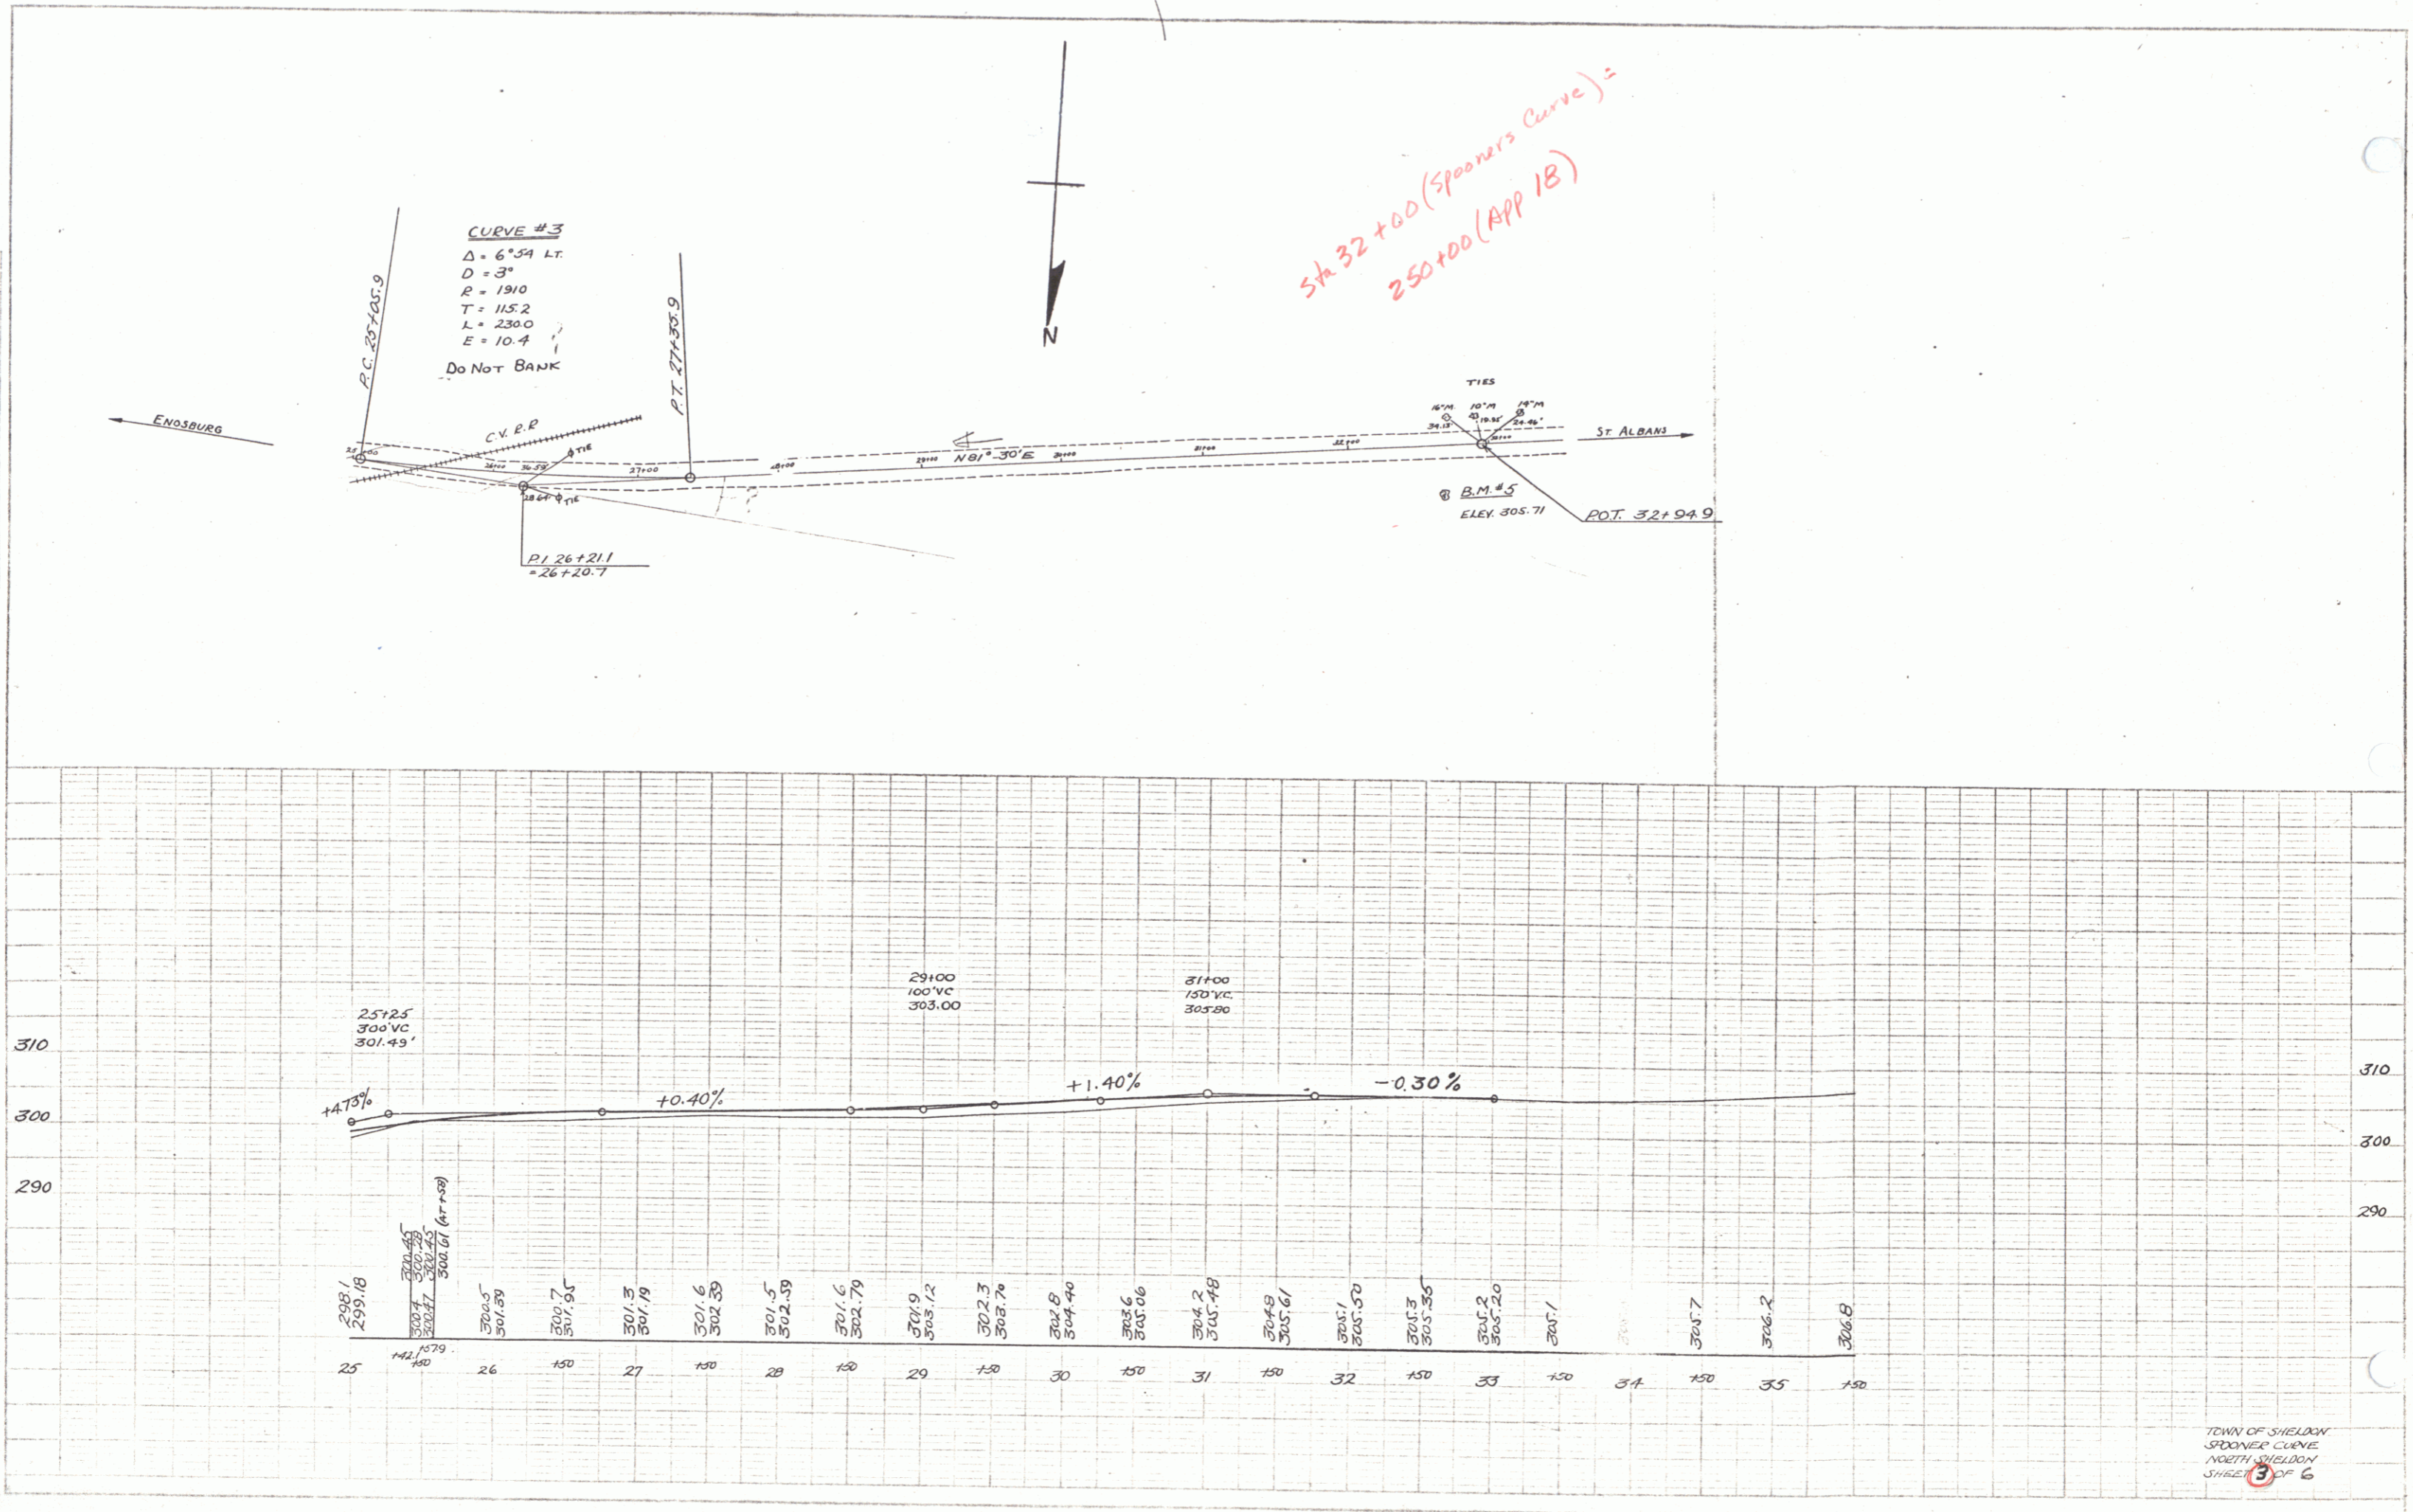

Sta 32+00 (Spooner's Curve) =
 250+00 (APP 1B)

TOWN OF SHELDON
 SPONNER CURVE
 NORTH SHELDON
 SHELDON 3 OF 6