

POOR ORIGINAL COPY

Contract Draw  
1190.21


Rev Ramp  
Δ 142°34'14" RI  
D 10"  
R 6174.96  
T 83.46  
L 105.71  
E 116.94

Surv  
Ramp  
Δ 17°52'21"  
D 10"

Bituminous Concrete Surface for Outer of Tule Islands Item 504  
070-100 Dms. (Horizontal)

2600  
En+Project

VT 105  
Δ 96°52'22"  
D 13"  
R 44074  
T 194.00  
L 742.56  
E 22126

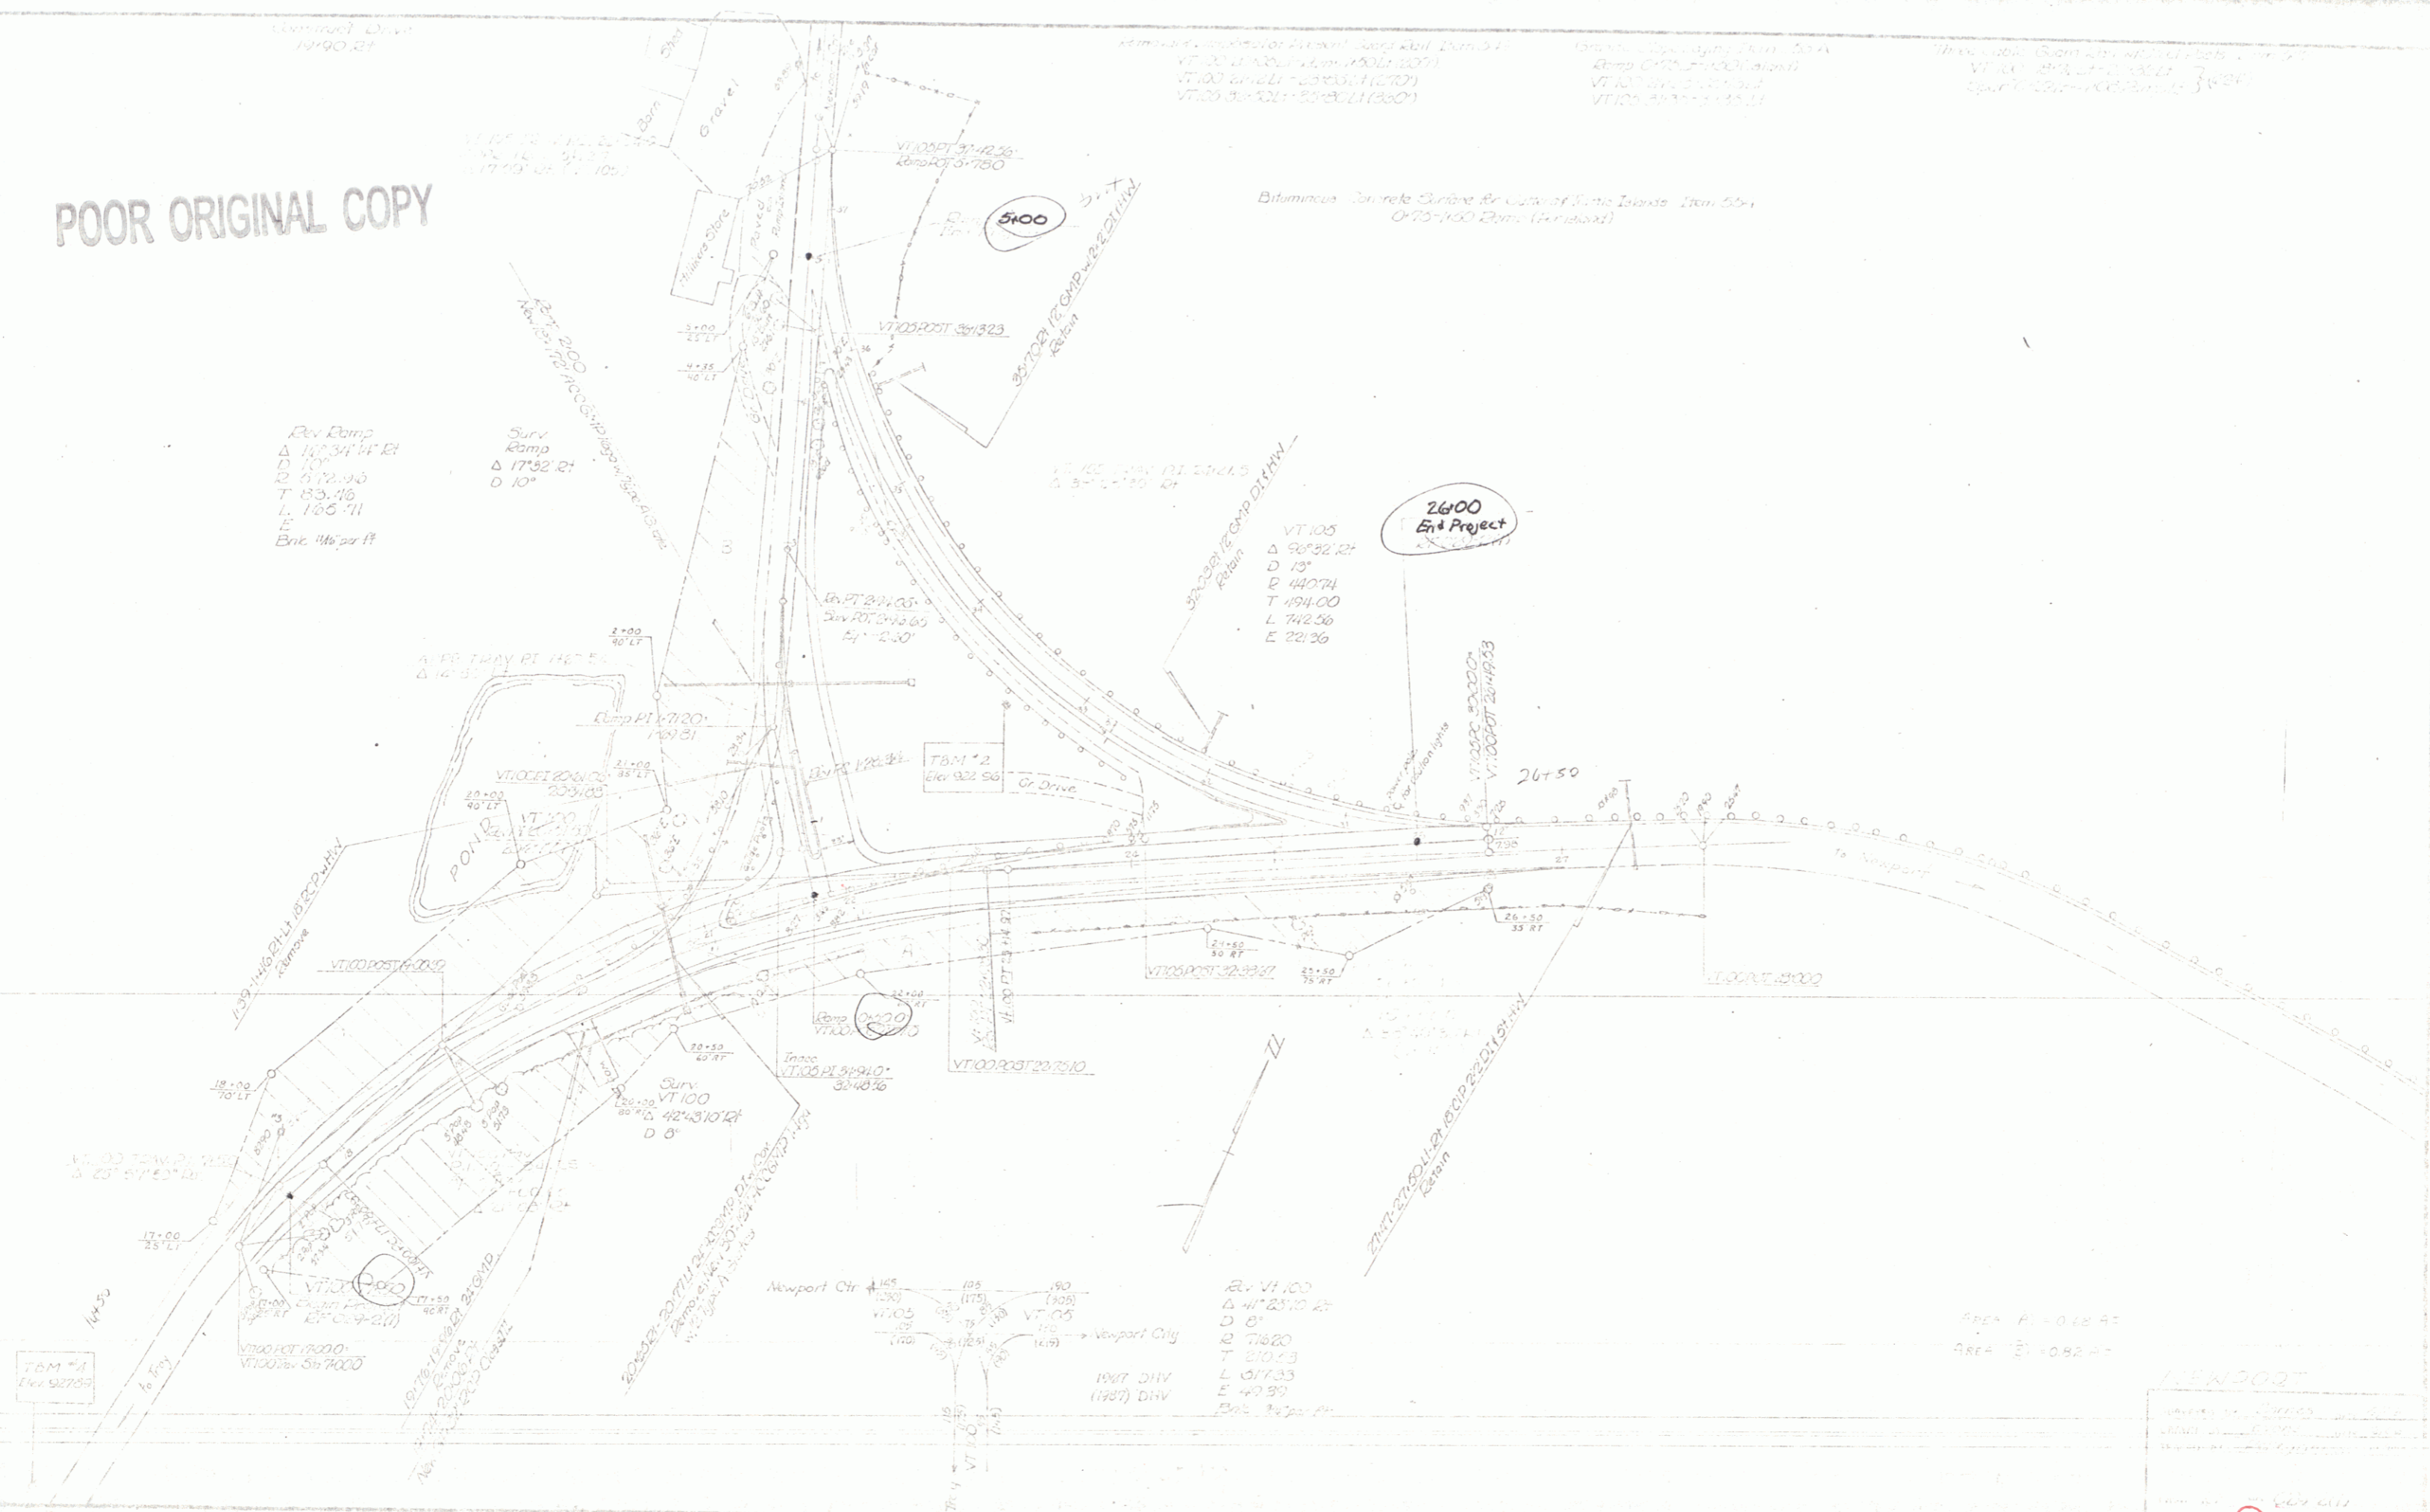

TBM #4  
Elev 927.95

Newport Ctr  
1185

Newport City  
1185

261 VT 100  
Δ 41°25'10" RI  
D 8"  
R 71820  
T 210.63  
L 517.33  
E 49.39  
Elev 927.95

AREA A = 0.62 AC  
AREA B = 0.82 AC

119002  
SHEET 7