
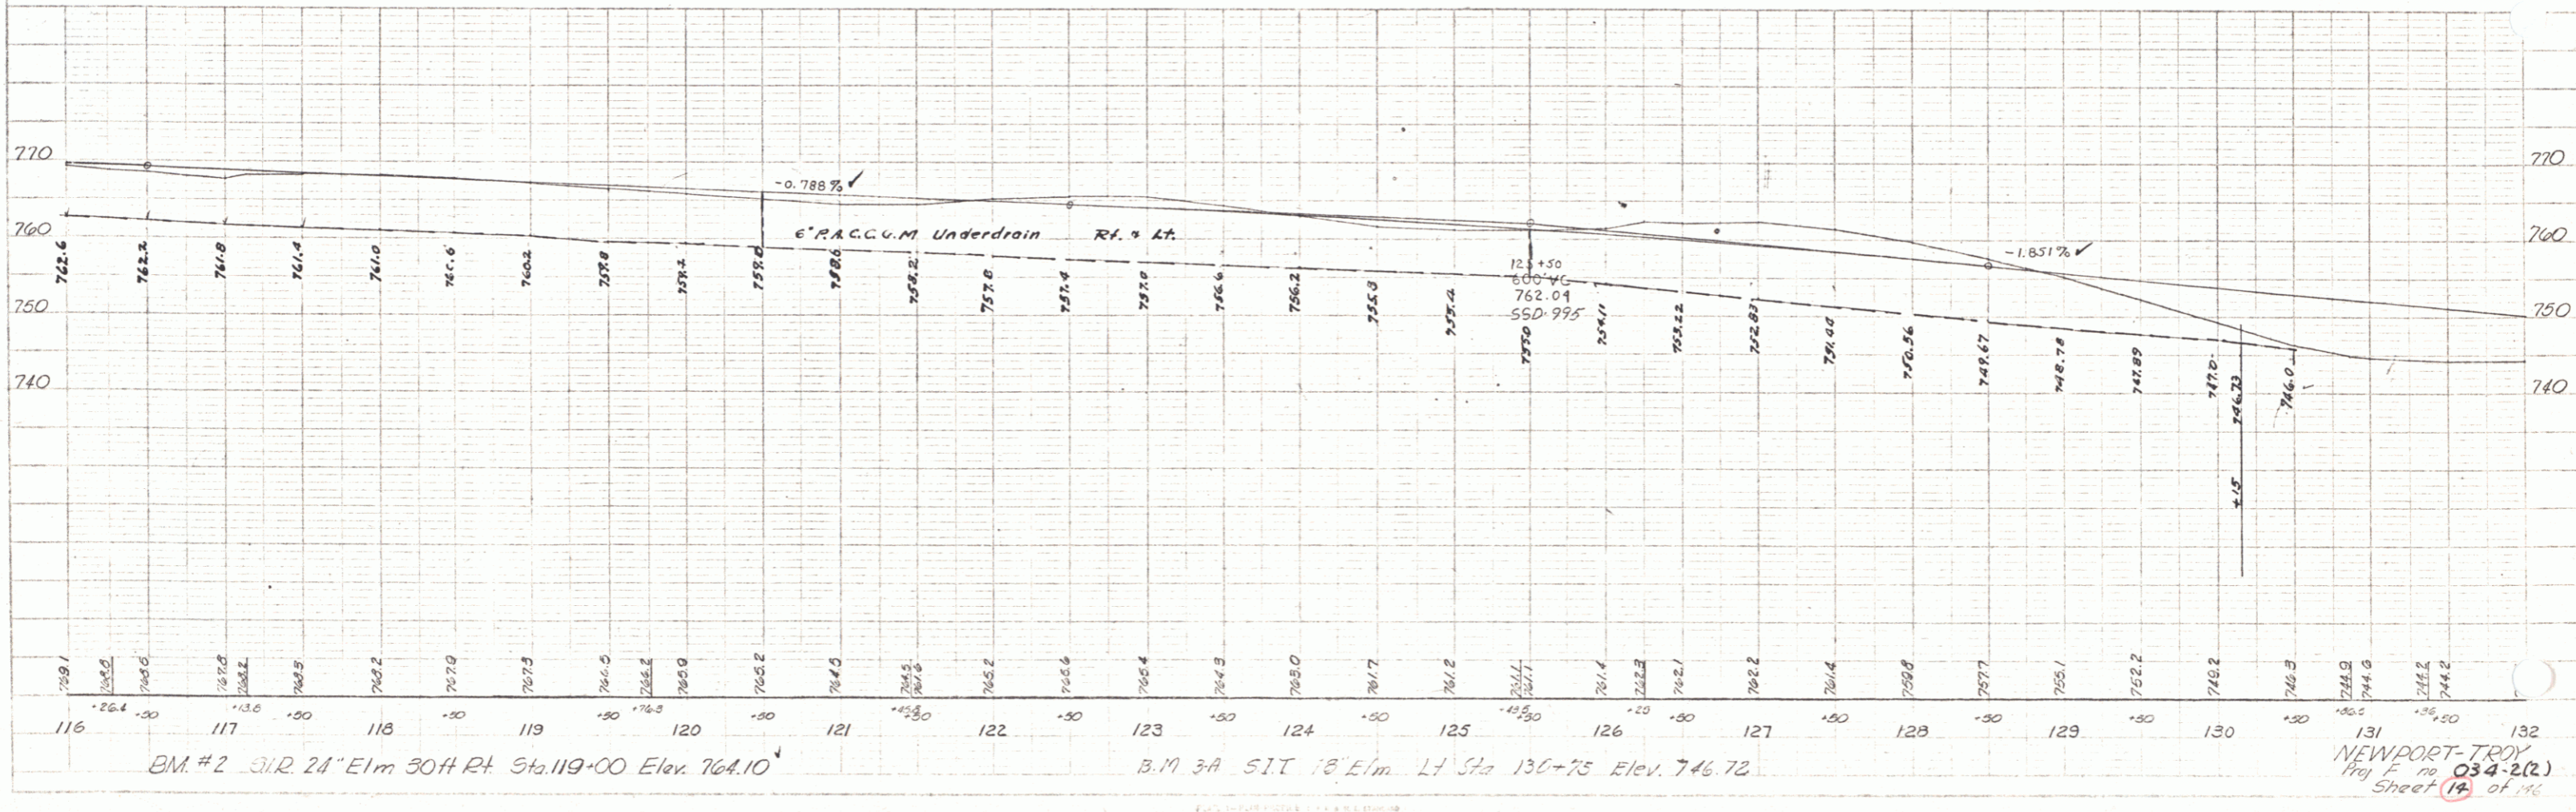


DELAYED
 7-37
 PLM
 NEWPORT-TROY
 PROJECT NO. 034-2(2)
 SHEET 12 OF 14

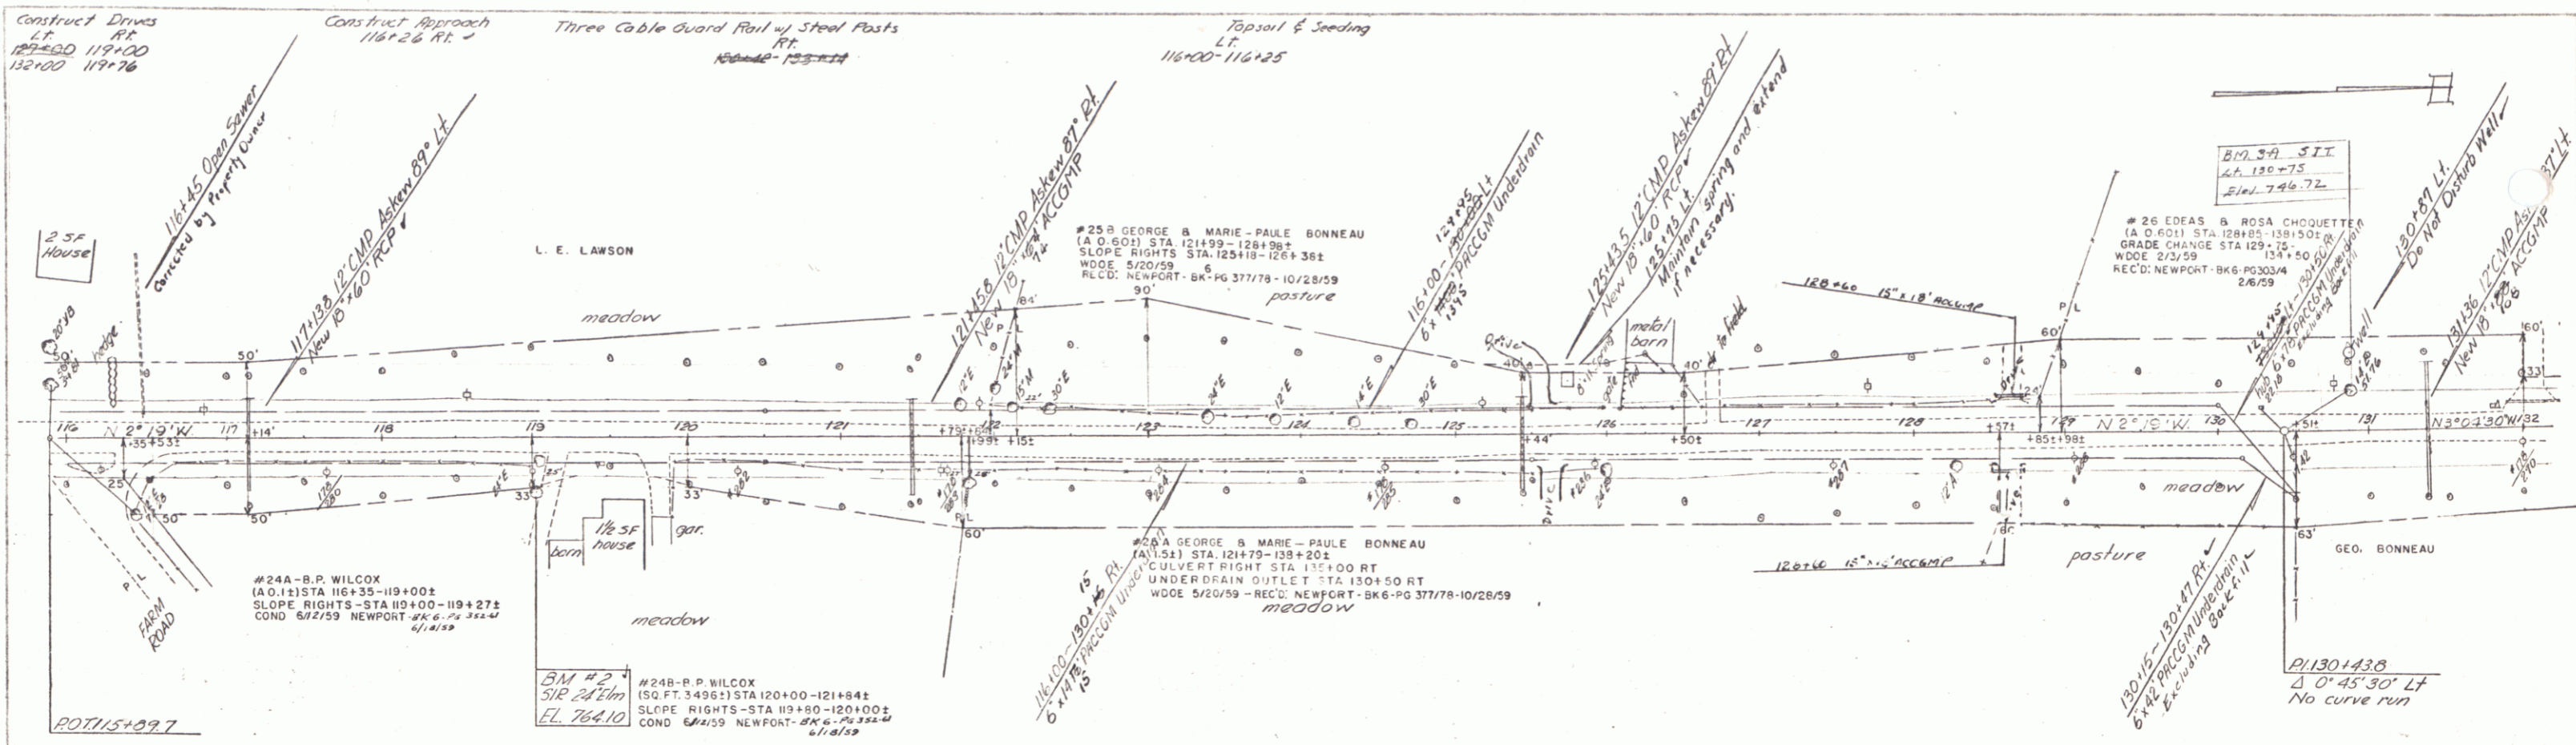

NEWPORT-TROY
 Proj. F. No. 034-2(2)
 Sheet 12 of 14