



PLAN
Dulano
7-57

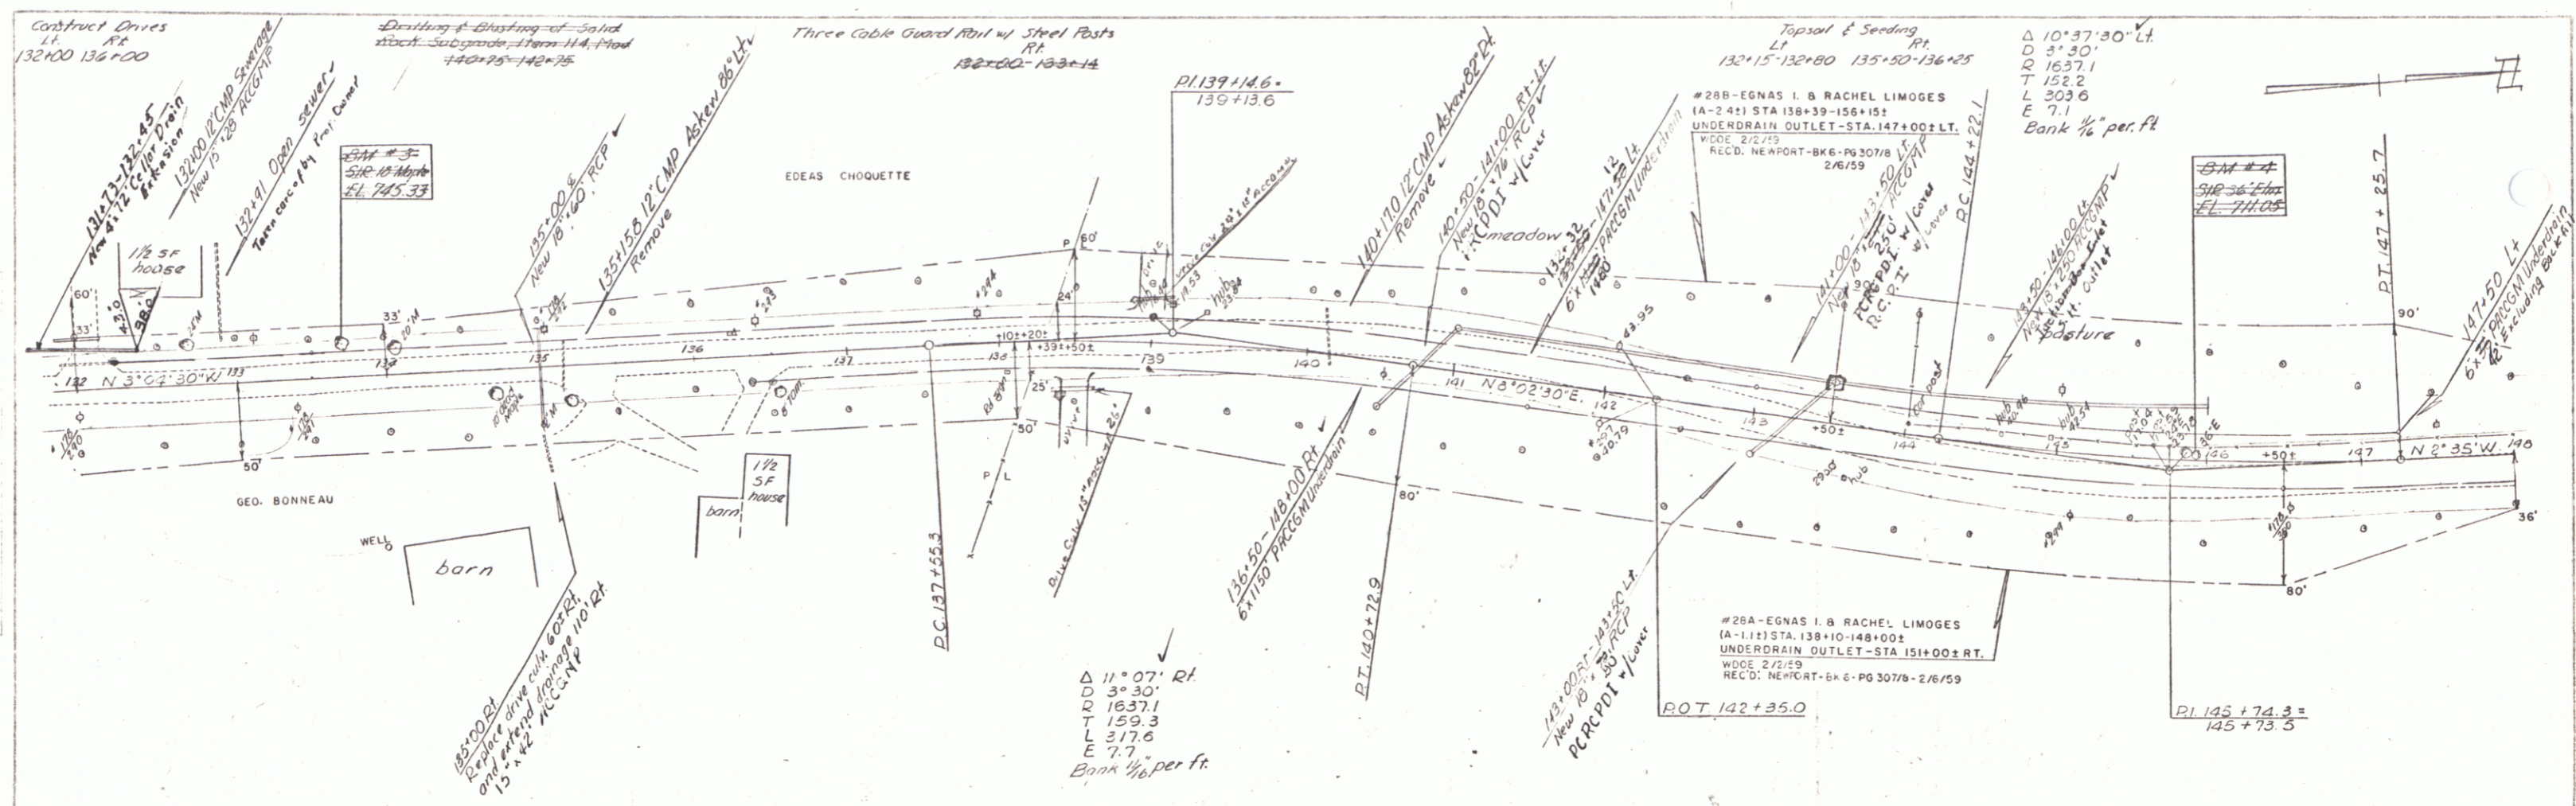

Bryant
7-57

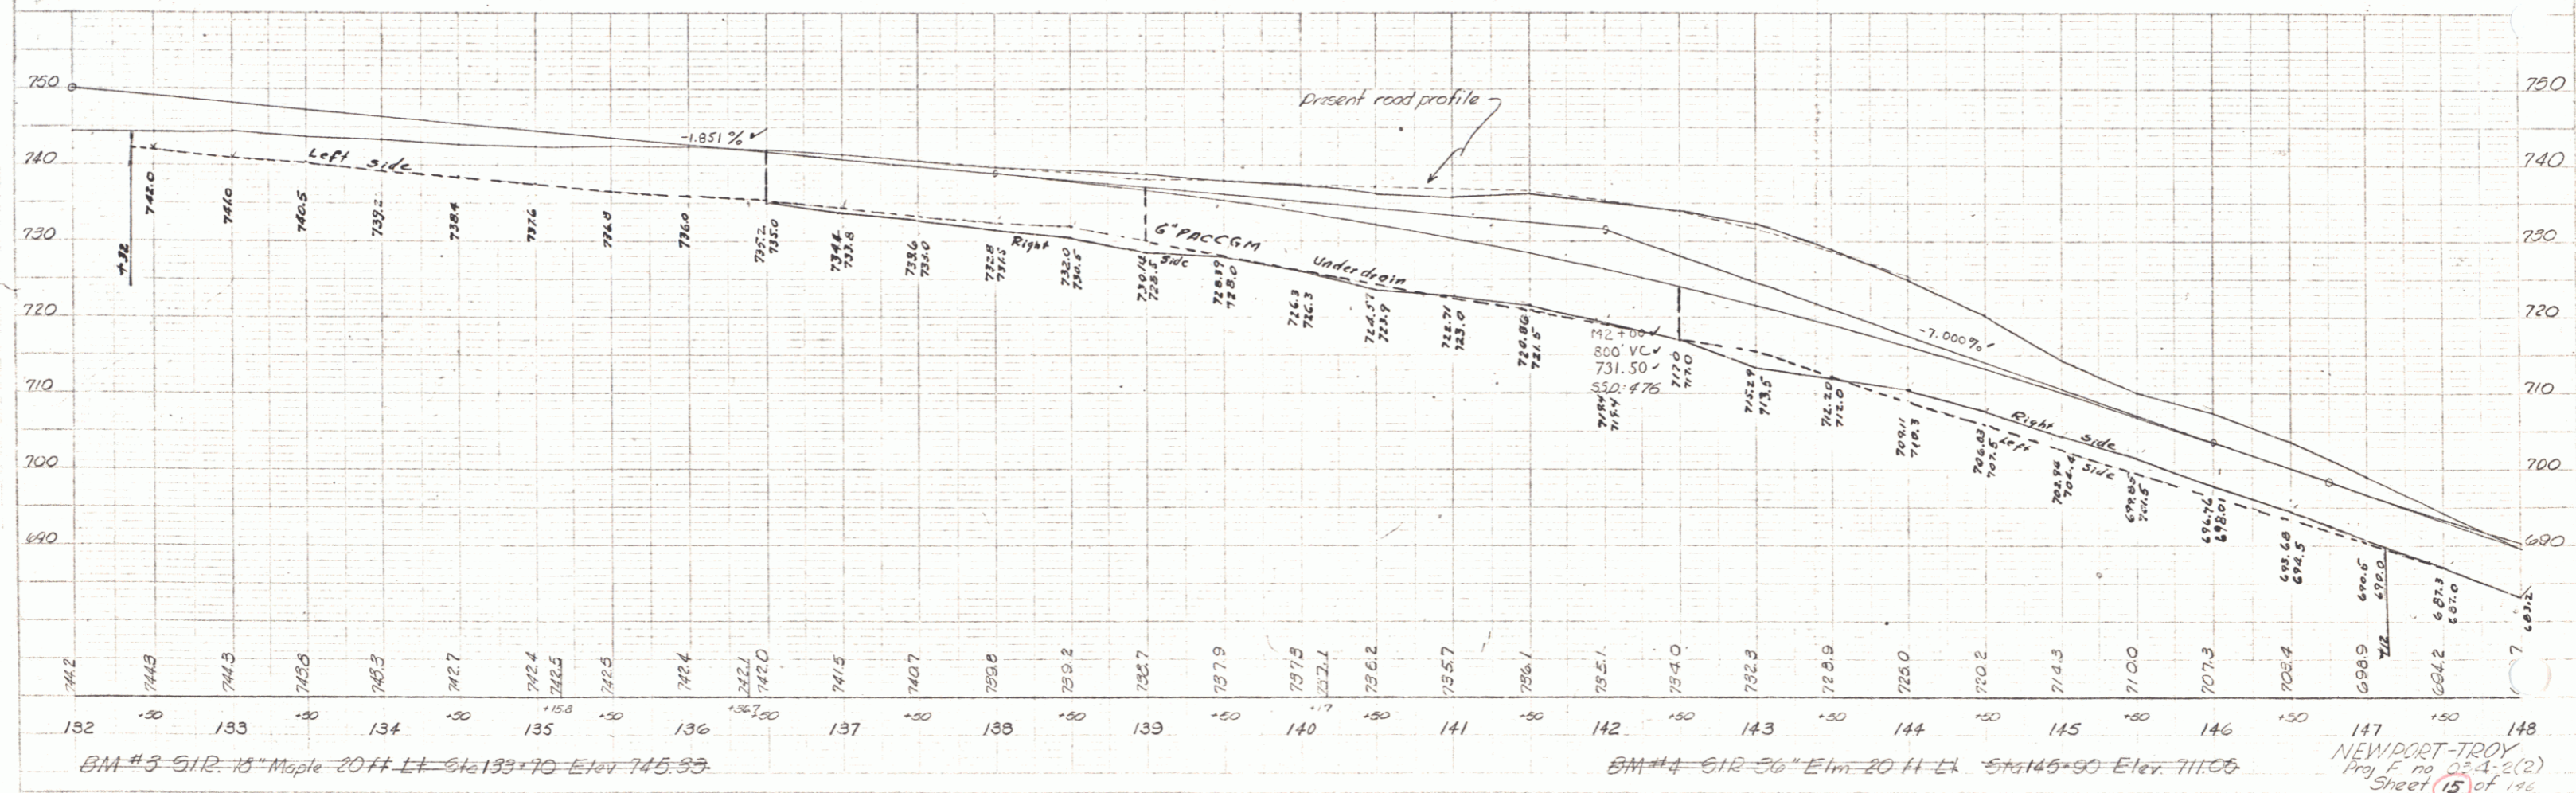

BM #3 512-15 Maple 20 ft Lt Sta 133+70 Elev 745.89

BM #4 612-56 Elm 20 ft Lt Sta 145+90 Elev 711.05

NEWPORT-TROY
Proj F no 02-A-2(2)
Sheet 15 of 16

8