
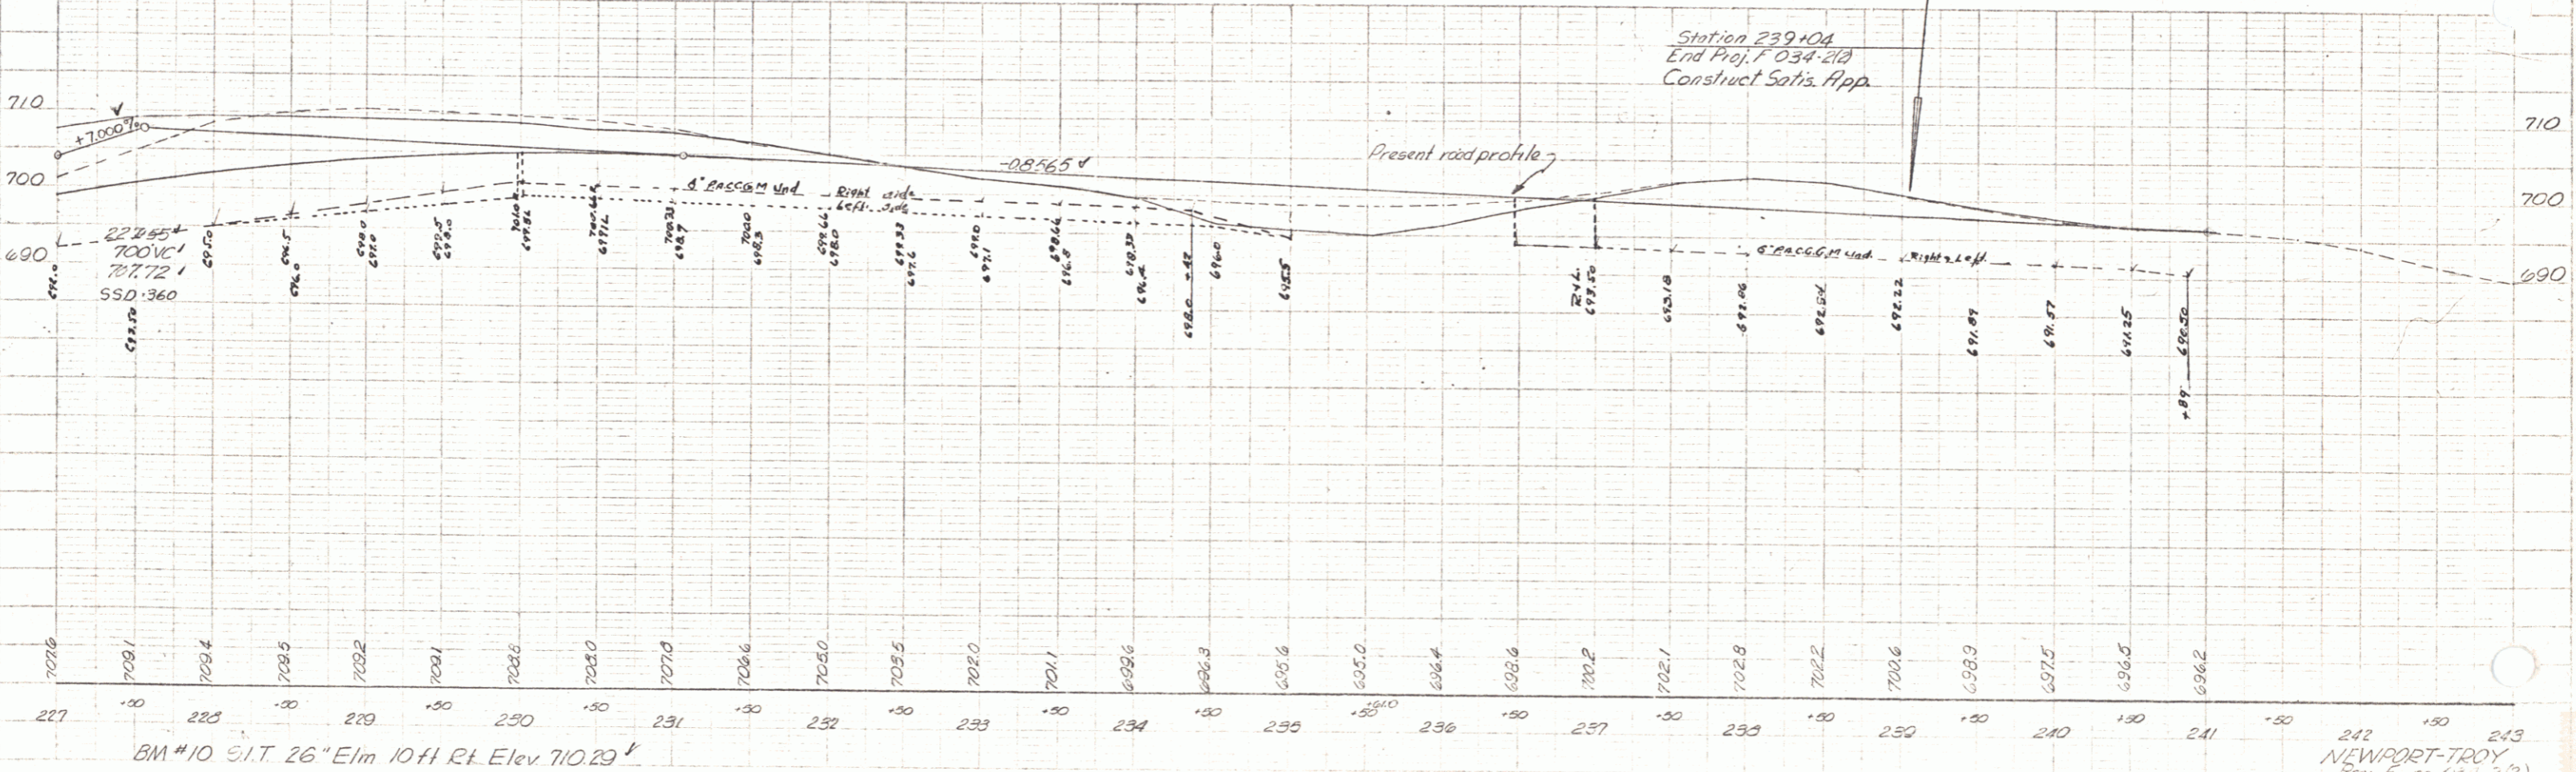


Delano 7-57

Bryant 7-57

Construct Drives
227+20 Rt

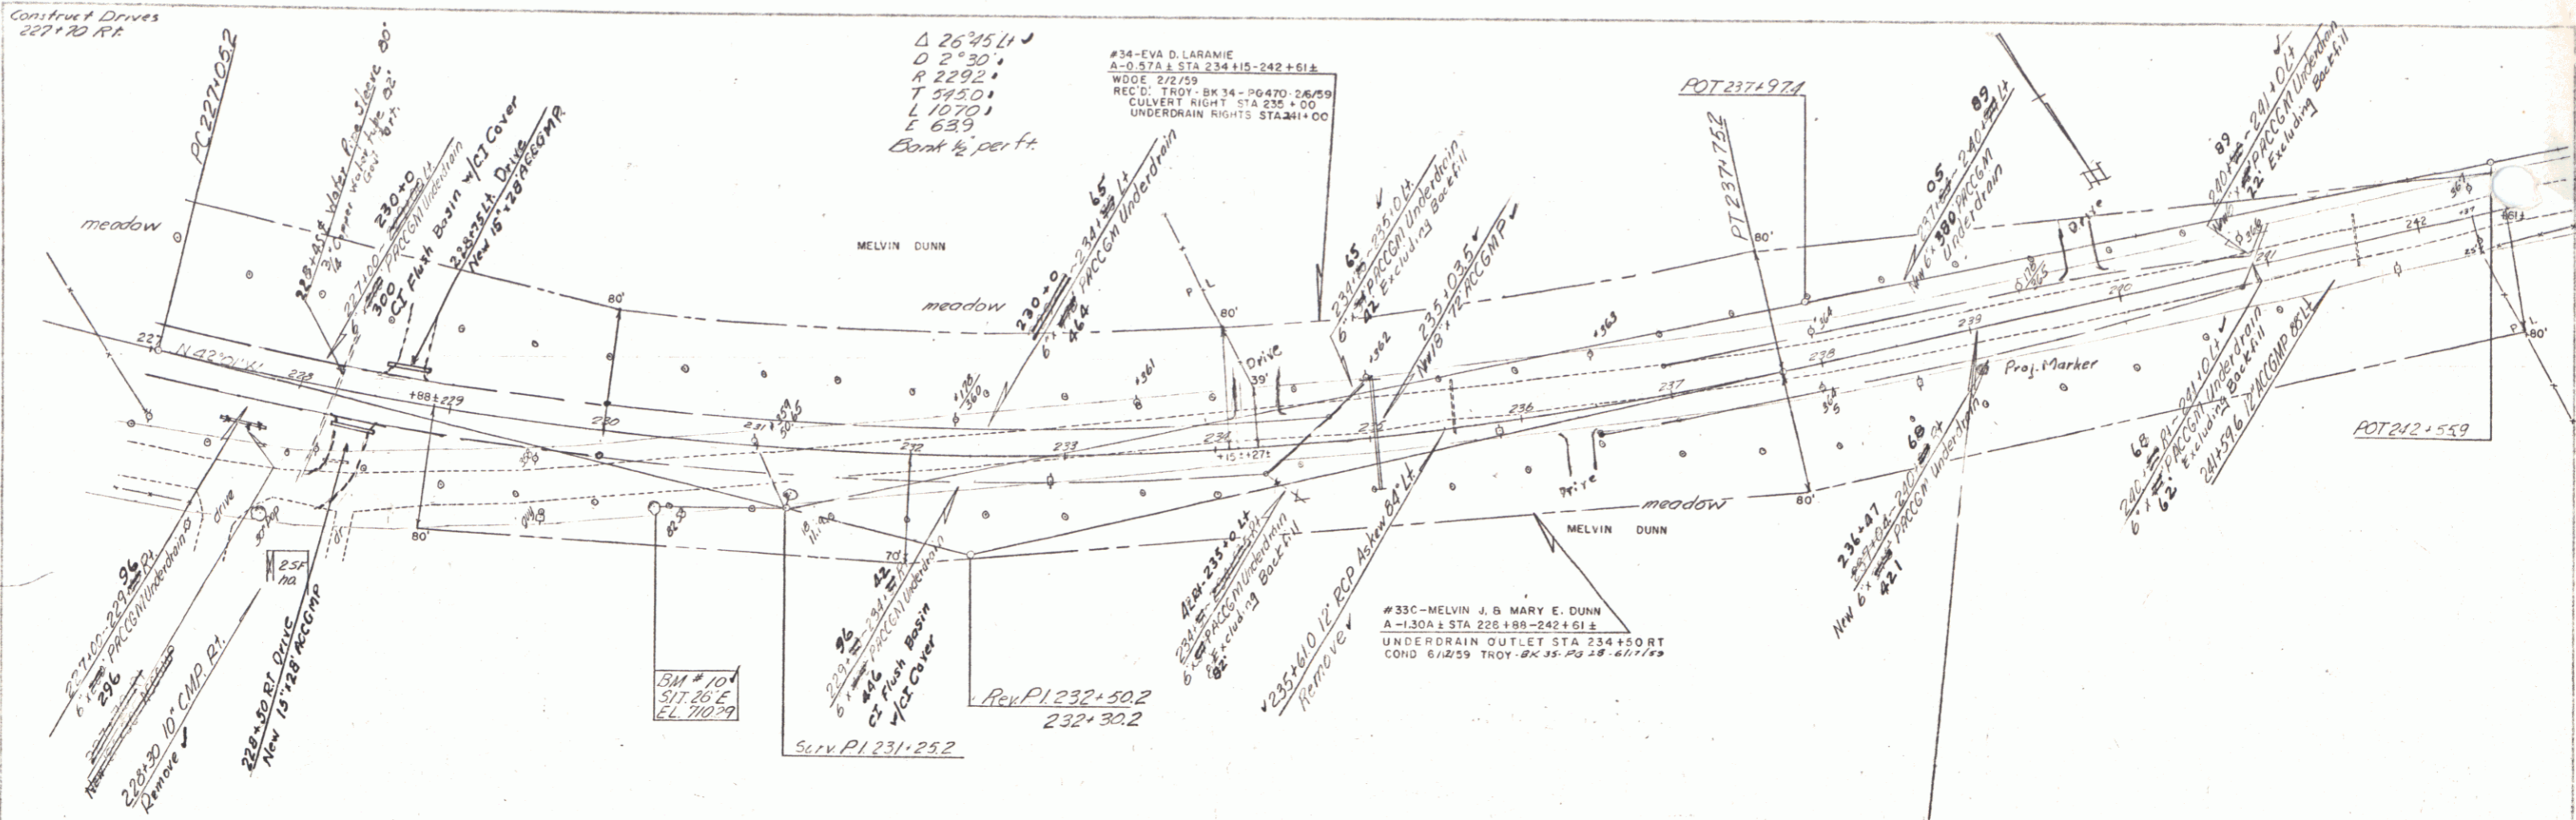

BM #10 S/T 26\" Elm 10 Ft Rt. Elev 710.23

NEWPORT-TROY
Proj. No. 034-213
Sheet 21 of 145