


POTNAM  
D. MACCARI  
TRACED

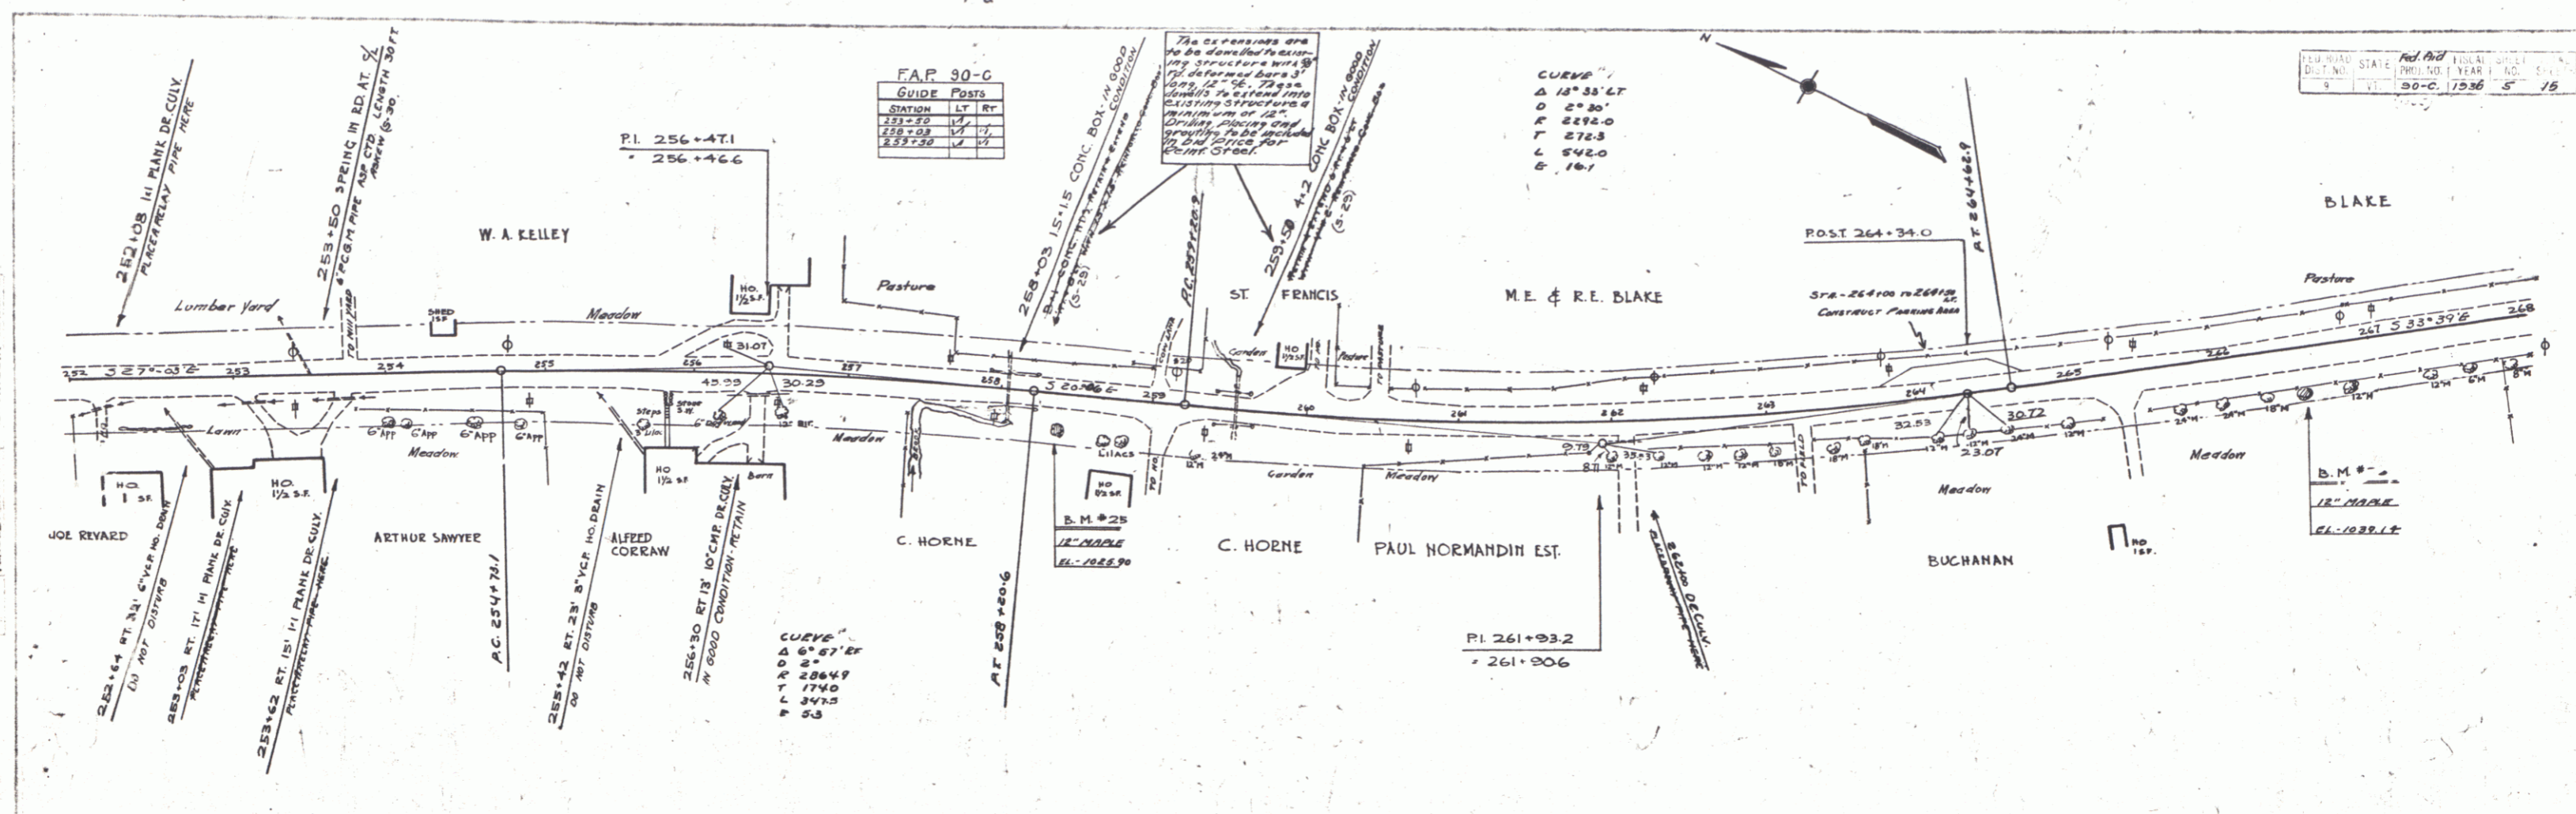

FAP 90-C  
GUIDE POSTS


| STATION | LT | RT |
|---------|----|----|
| 252+25  | ✓  |    |
| 258+03  | ✓  |    |
| 259+50  | ✓  |    |

CURVE

|   |             |
|---|-------------|
| Δ | 18° 33' 47" |
| D | 22.30'      |
| R | 2592.0'     |
| T | 272.3'      |
| L | 542.0'      |
| E | 16.1'       |

REVISIONS  
DATE  
BY  
NO. 1  
30-C, 1936 5' 15'

1936  
DUNHAM  
PROPERTY

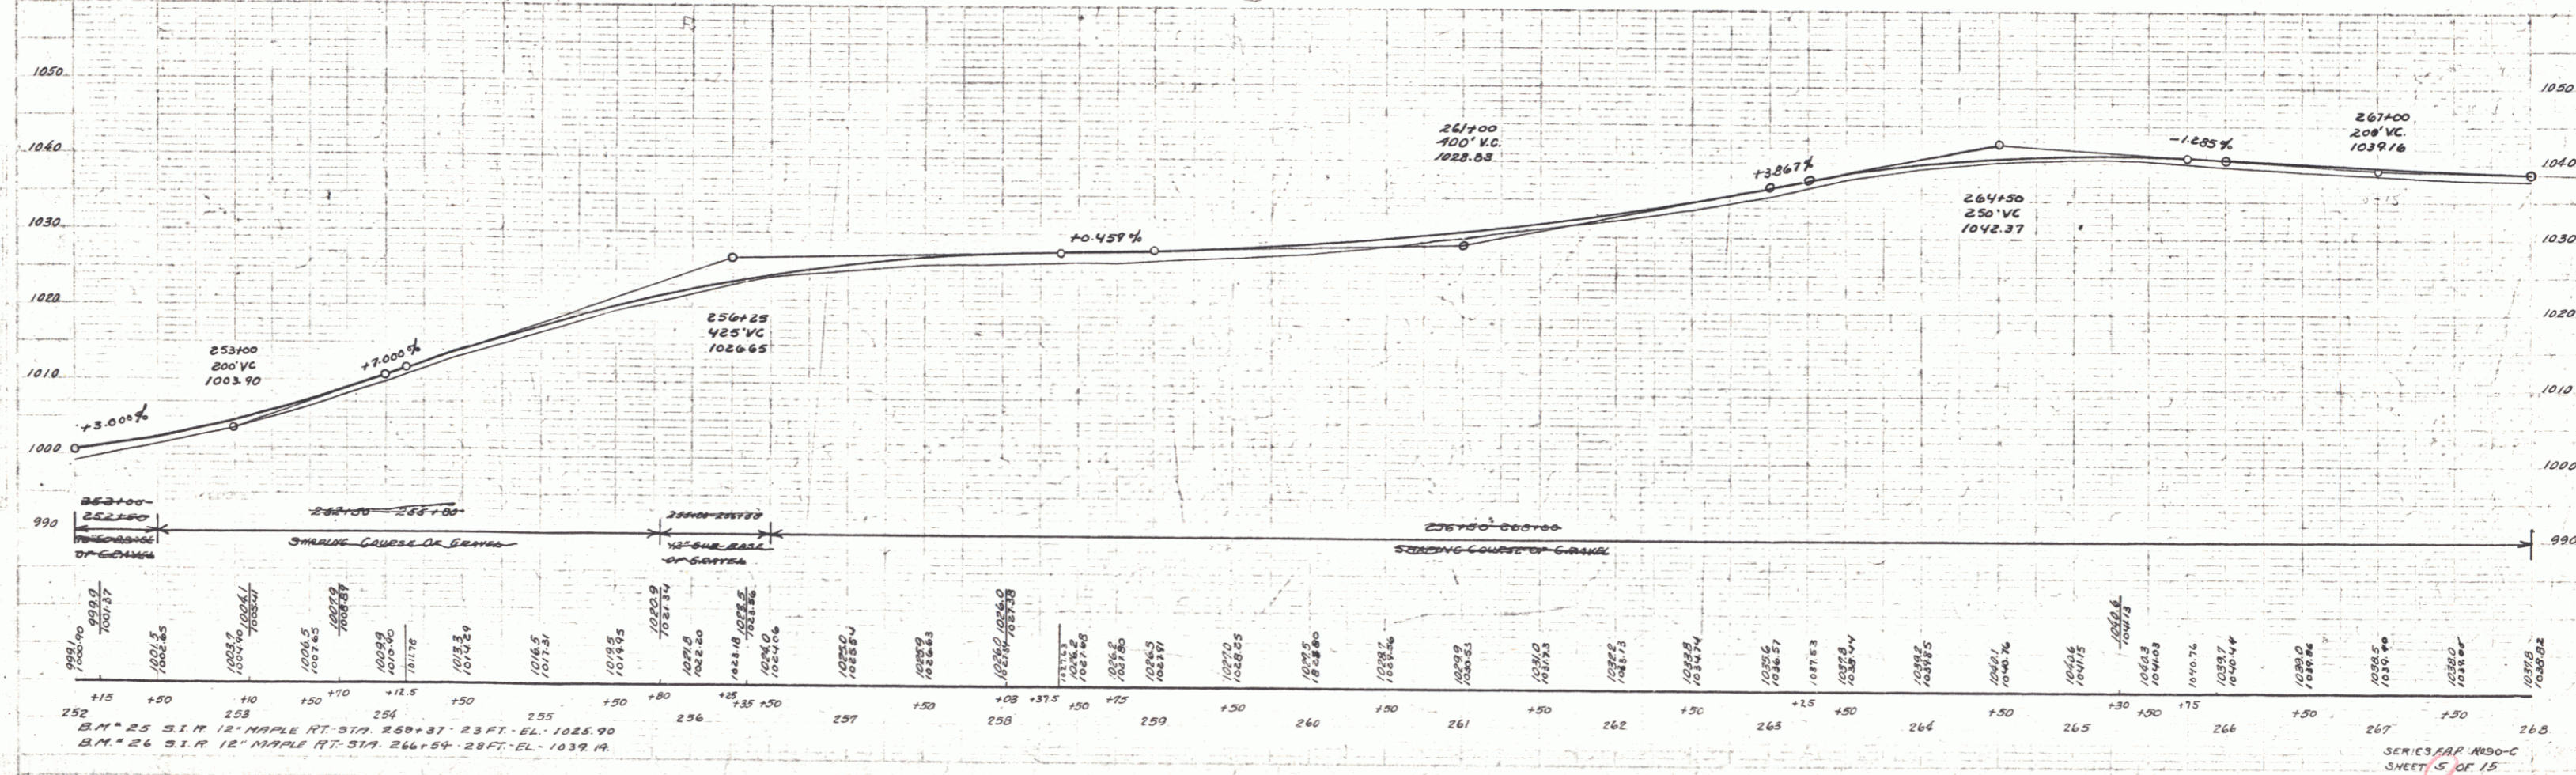

SERIES FAP 90-C  
SHEET 5 OF 15

3