

D. MACCHI
 5/7/04
 TEACED

D. MACCHI
 5/7/04



FAP 90-C
WOOD GUARD RAIL

STATION TO STATION	LT	RT
34200	344+28	349
	345100	346

FAP 90-C
GUIDE POSTS

STATION	LT	RT
339+77		1
339+79		1
341+78		1
342+78		1

50-C 1936 11 18

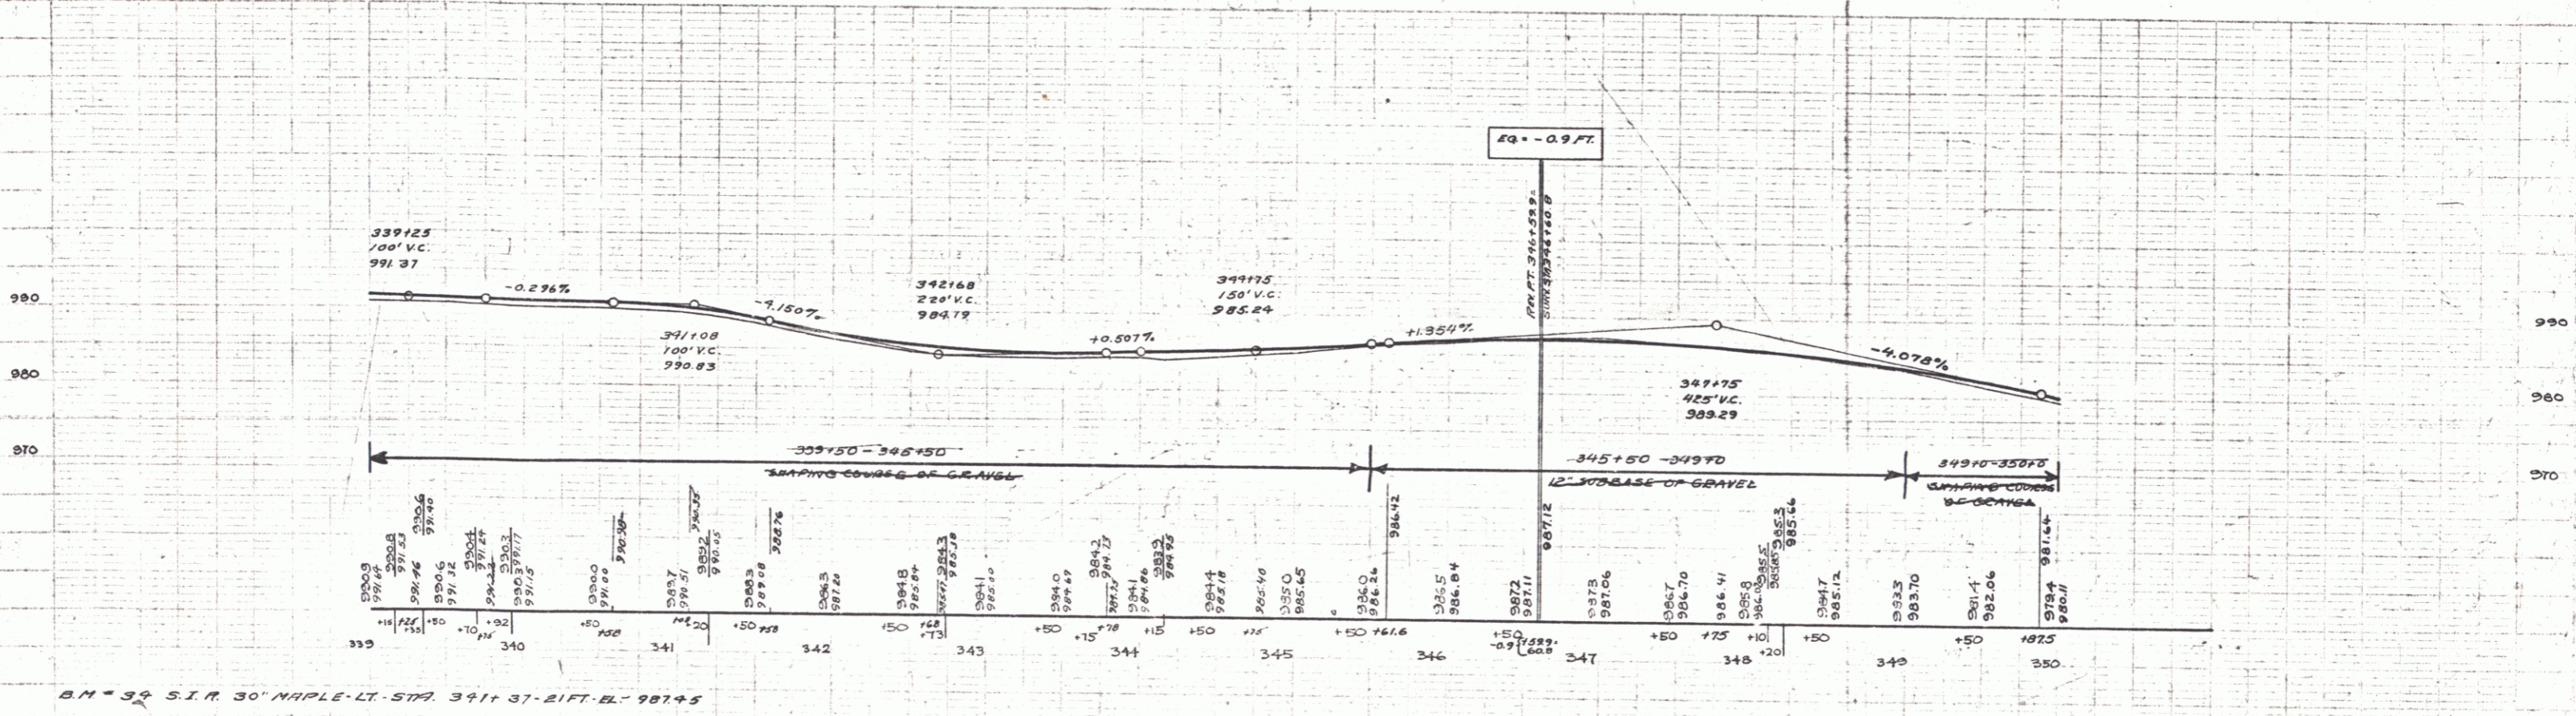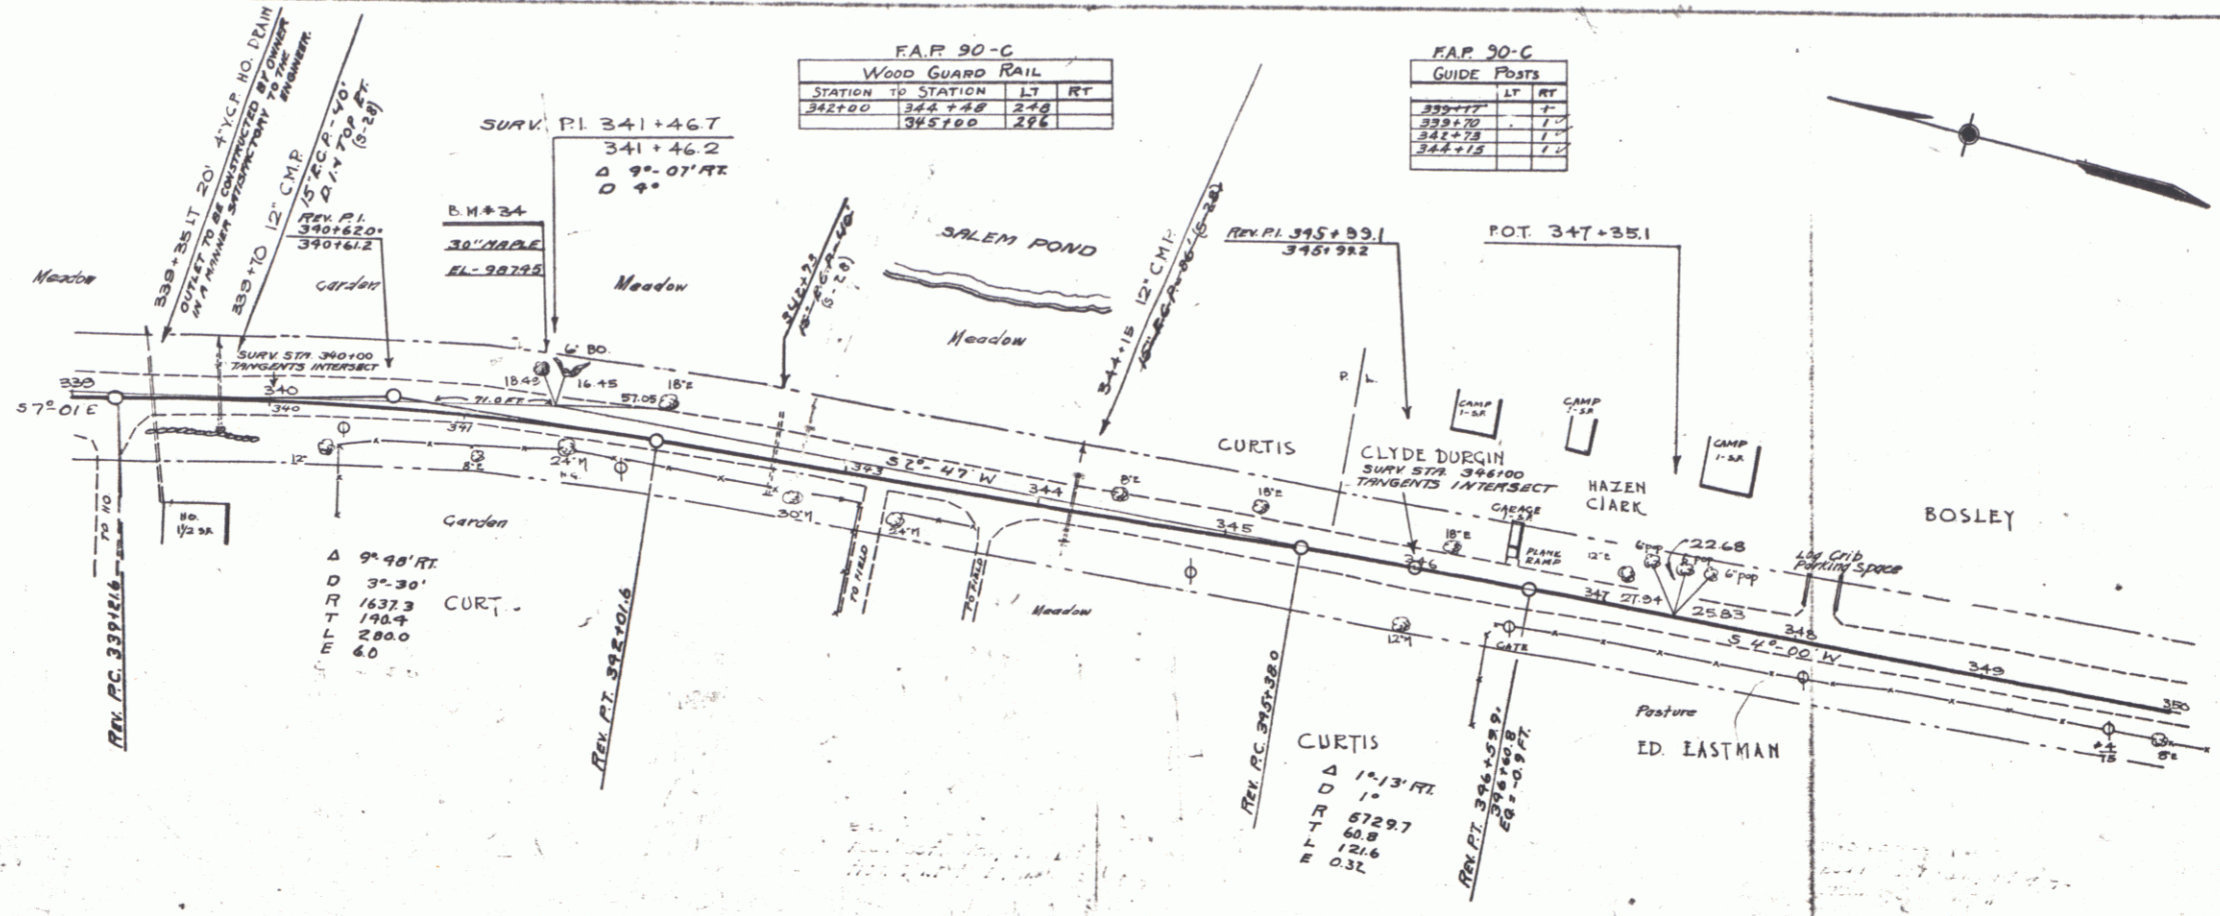

B.M. #34 S.I.R. 30' MAPLE LI. STA. 391+37-21 FT. EL. 987.95