
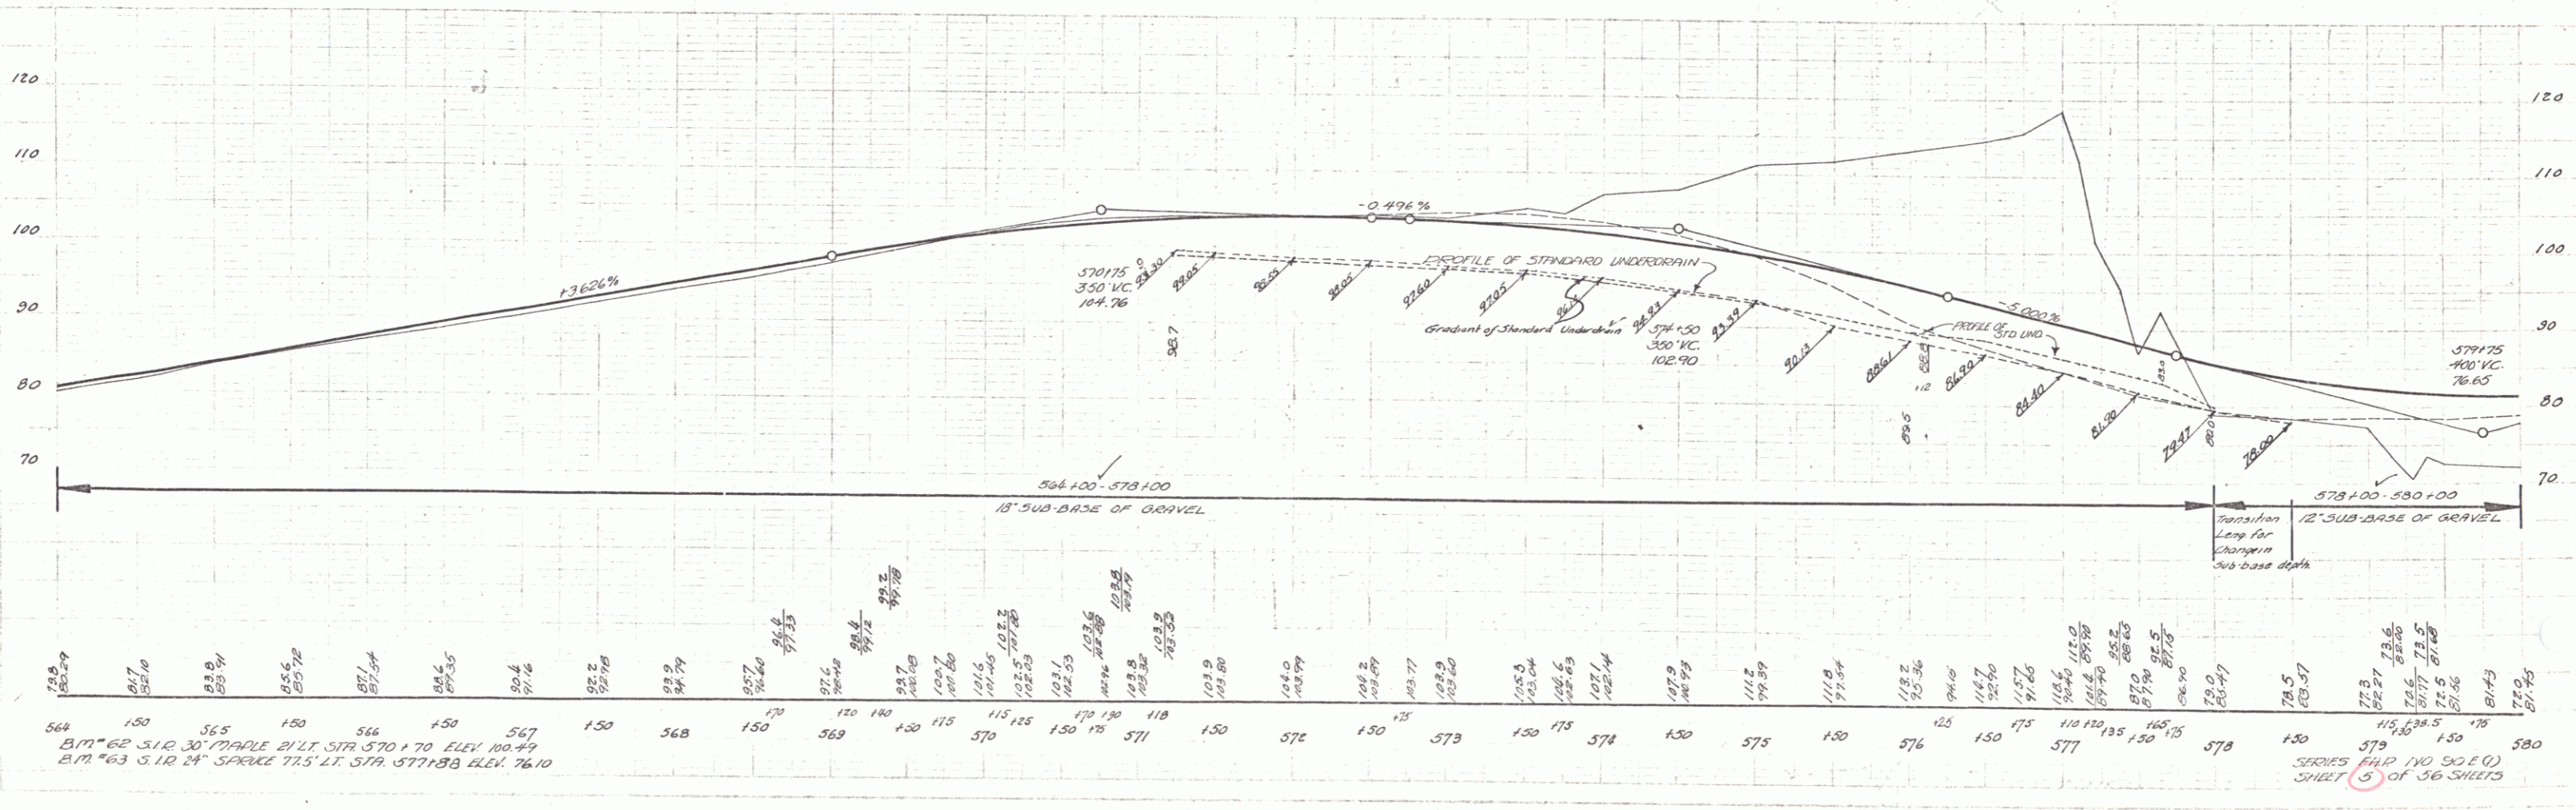


PARCEL	INSTRUMENT	DATE	GRANTOR	GRANTEE	RECORDED	REMARK
C	Q.C.D.	10-13-39	EARL WILLIS	17' OF IT	BOOK PAGE DATE 23 448 12-15-39	
A	Q.C.D.	10-13-39	GEORGE & MARIE GEOFFROY	17' OF IT	23 447 12-15-39	

300(1) 1940 5 36

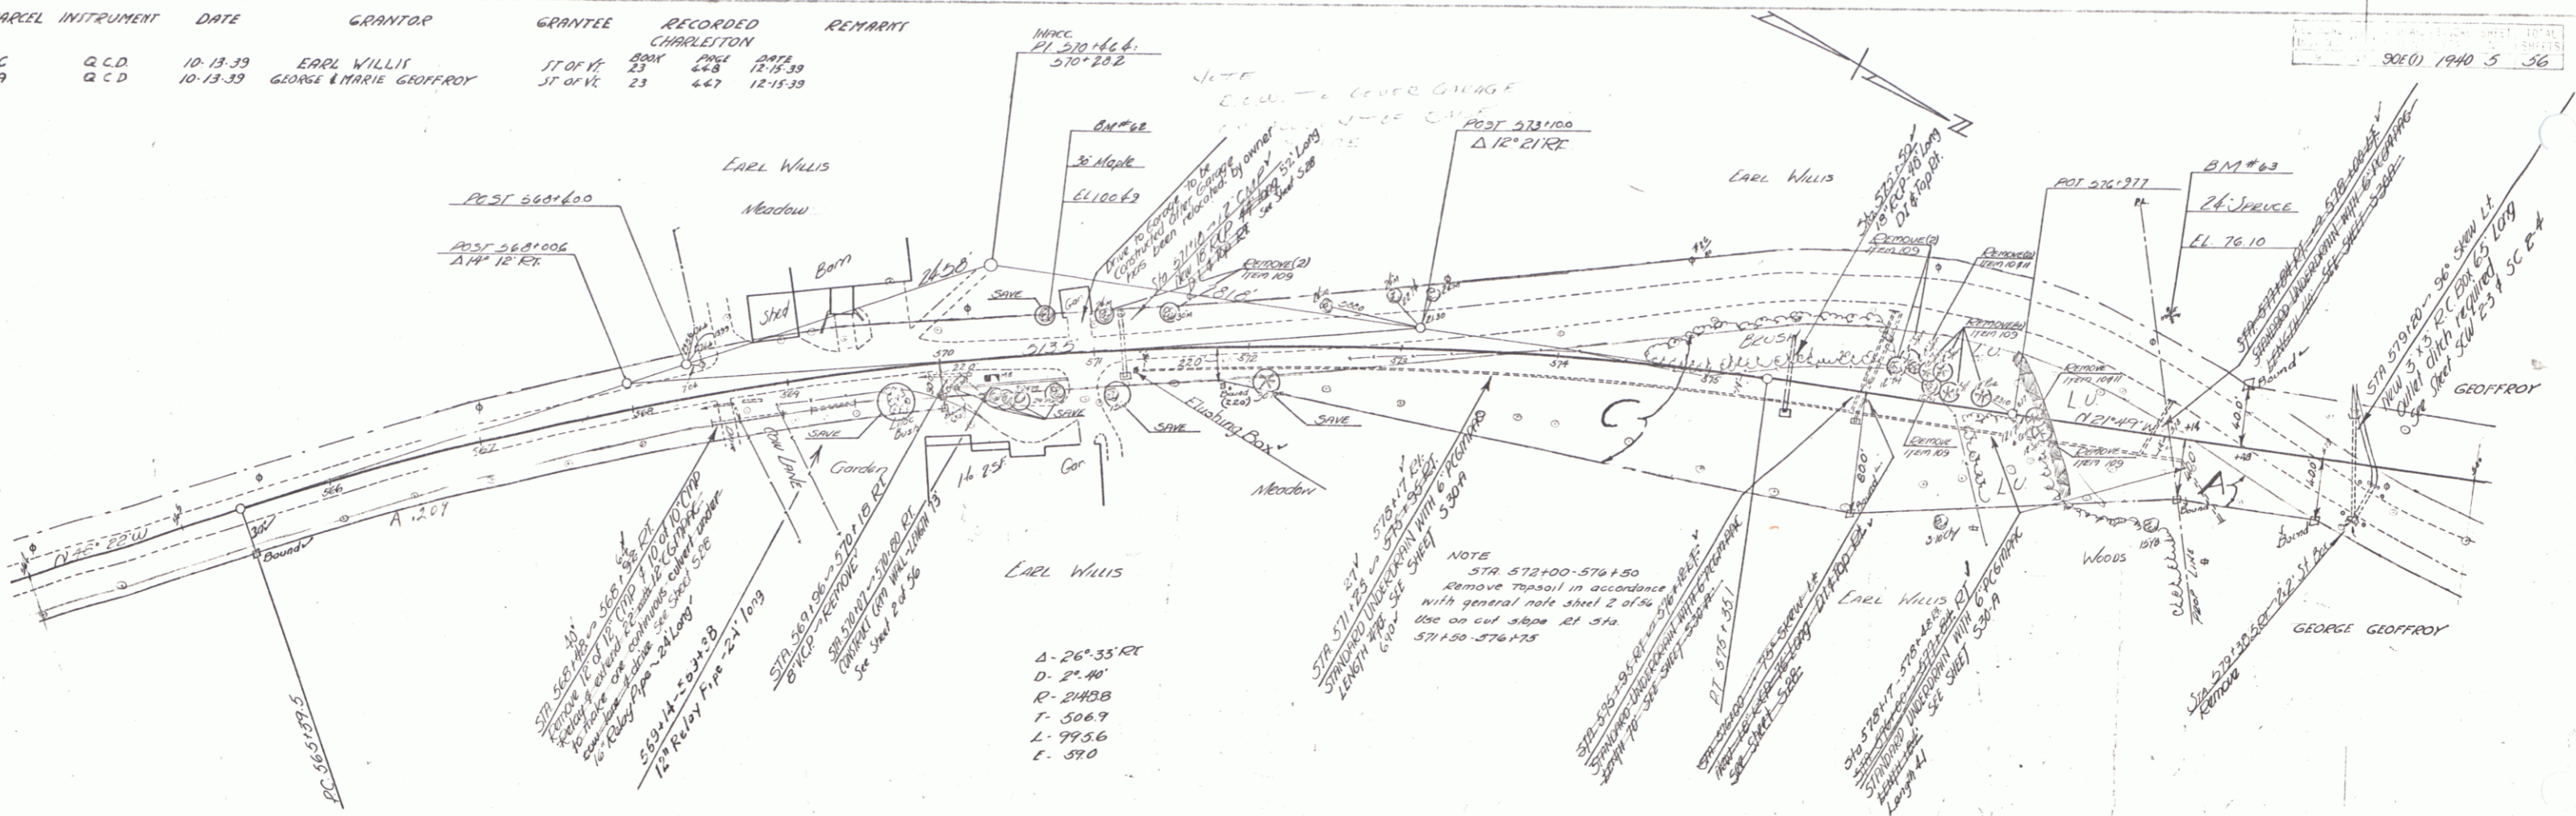

SERIES MAP NO 502(E)
 SHEET 5 OF 36 SHEETS