
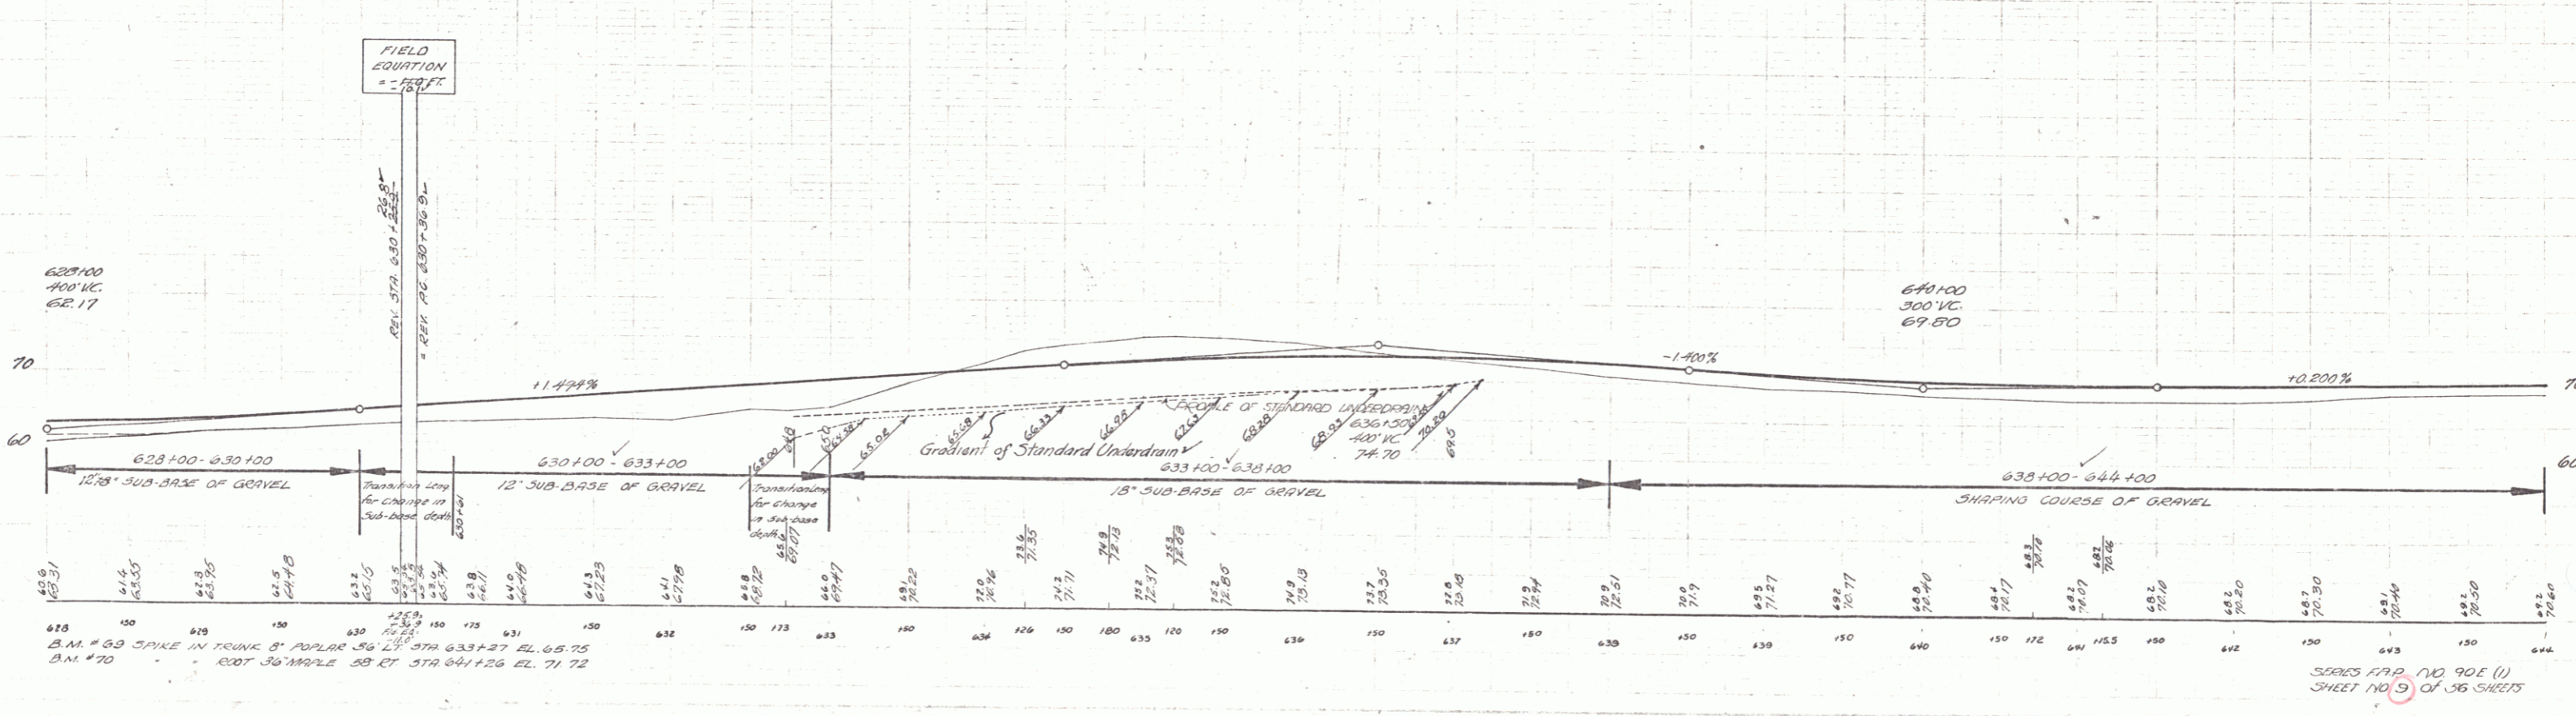


733
 E. Lane
 1. Lane
 7-27
 1. Lane
 7-27

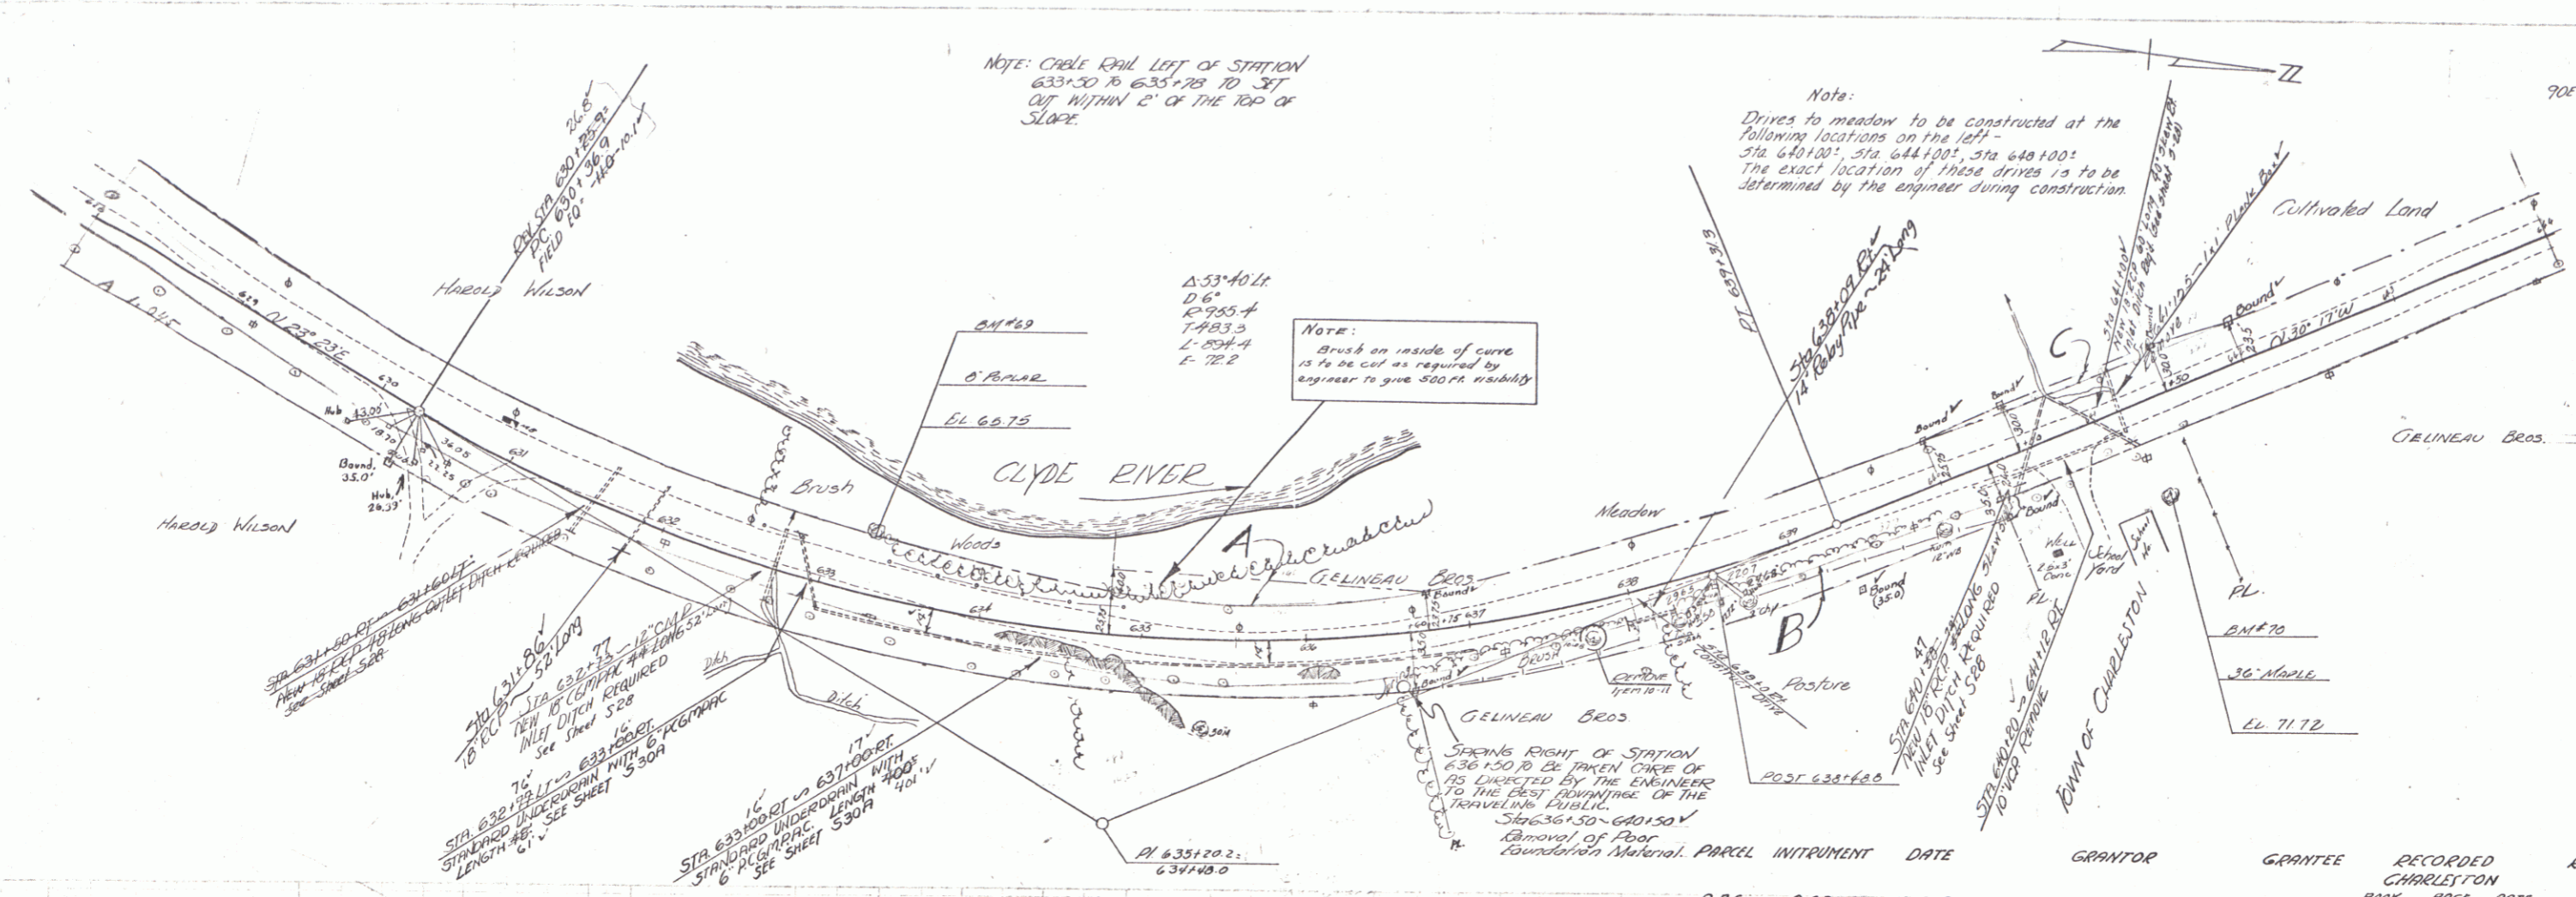

705 (1) 1940 9 36

7