
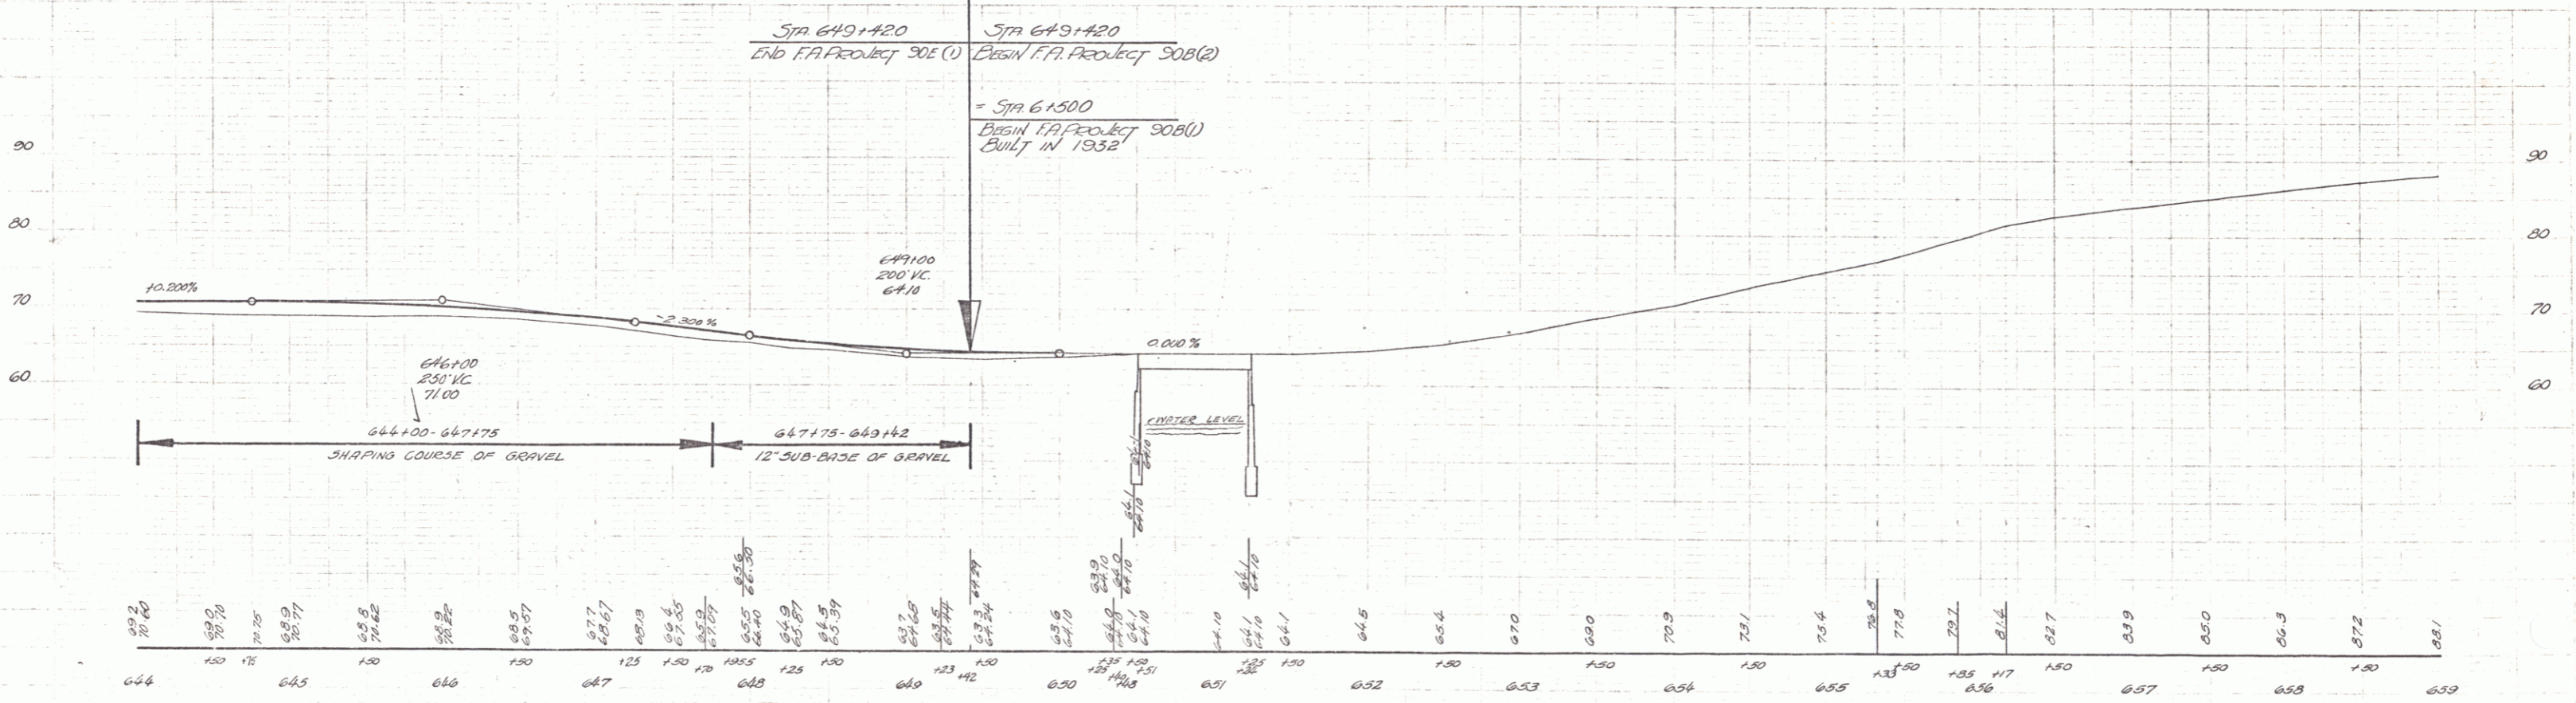


PARCEL	INSTRUMENT	DATE	GRANTOR	GRANTEE	RECORDED	REMARKS
D	Q.C.D.	10-13-39	GELINEAU BROS	ST OF VT	CHARLESTON BOOK PAGE 23 243	DATE 12-13-39

90(1) 1940 10 56

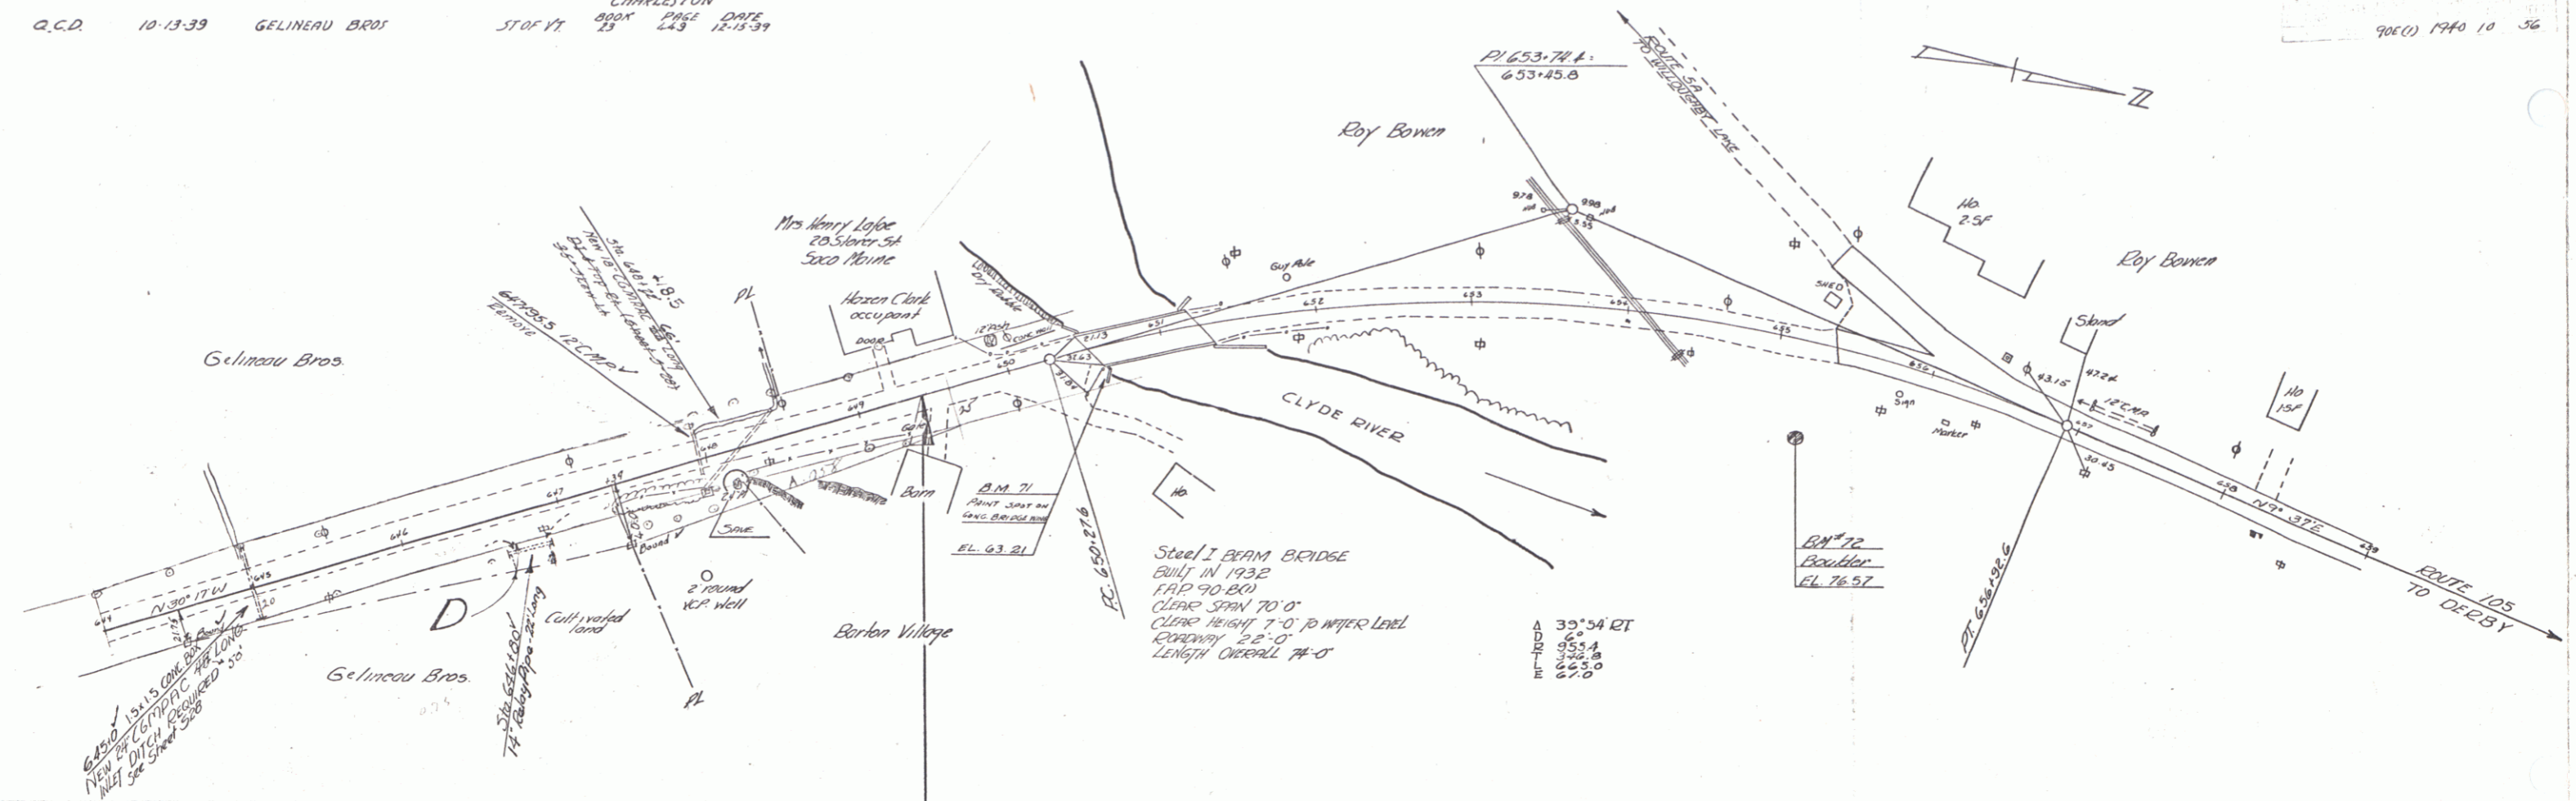

B.M. #71 PRINT SPOT ON CONG. BR. WING 14.5' BT STA 650+84 EL. 63.21
 B.M. #72 " " BOULDER 60' BT STA 655+21 EL. 78.87

SECT'S F.A.P. (NO 90E(1))
 SHEET 110.10 OF 56 SHEETS