
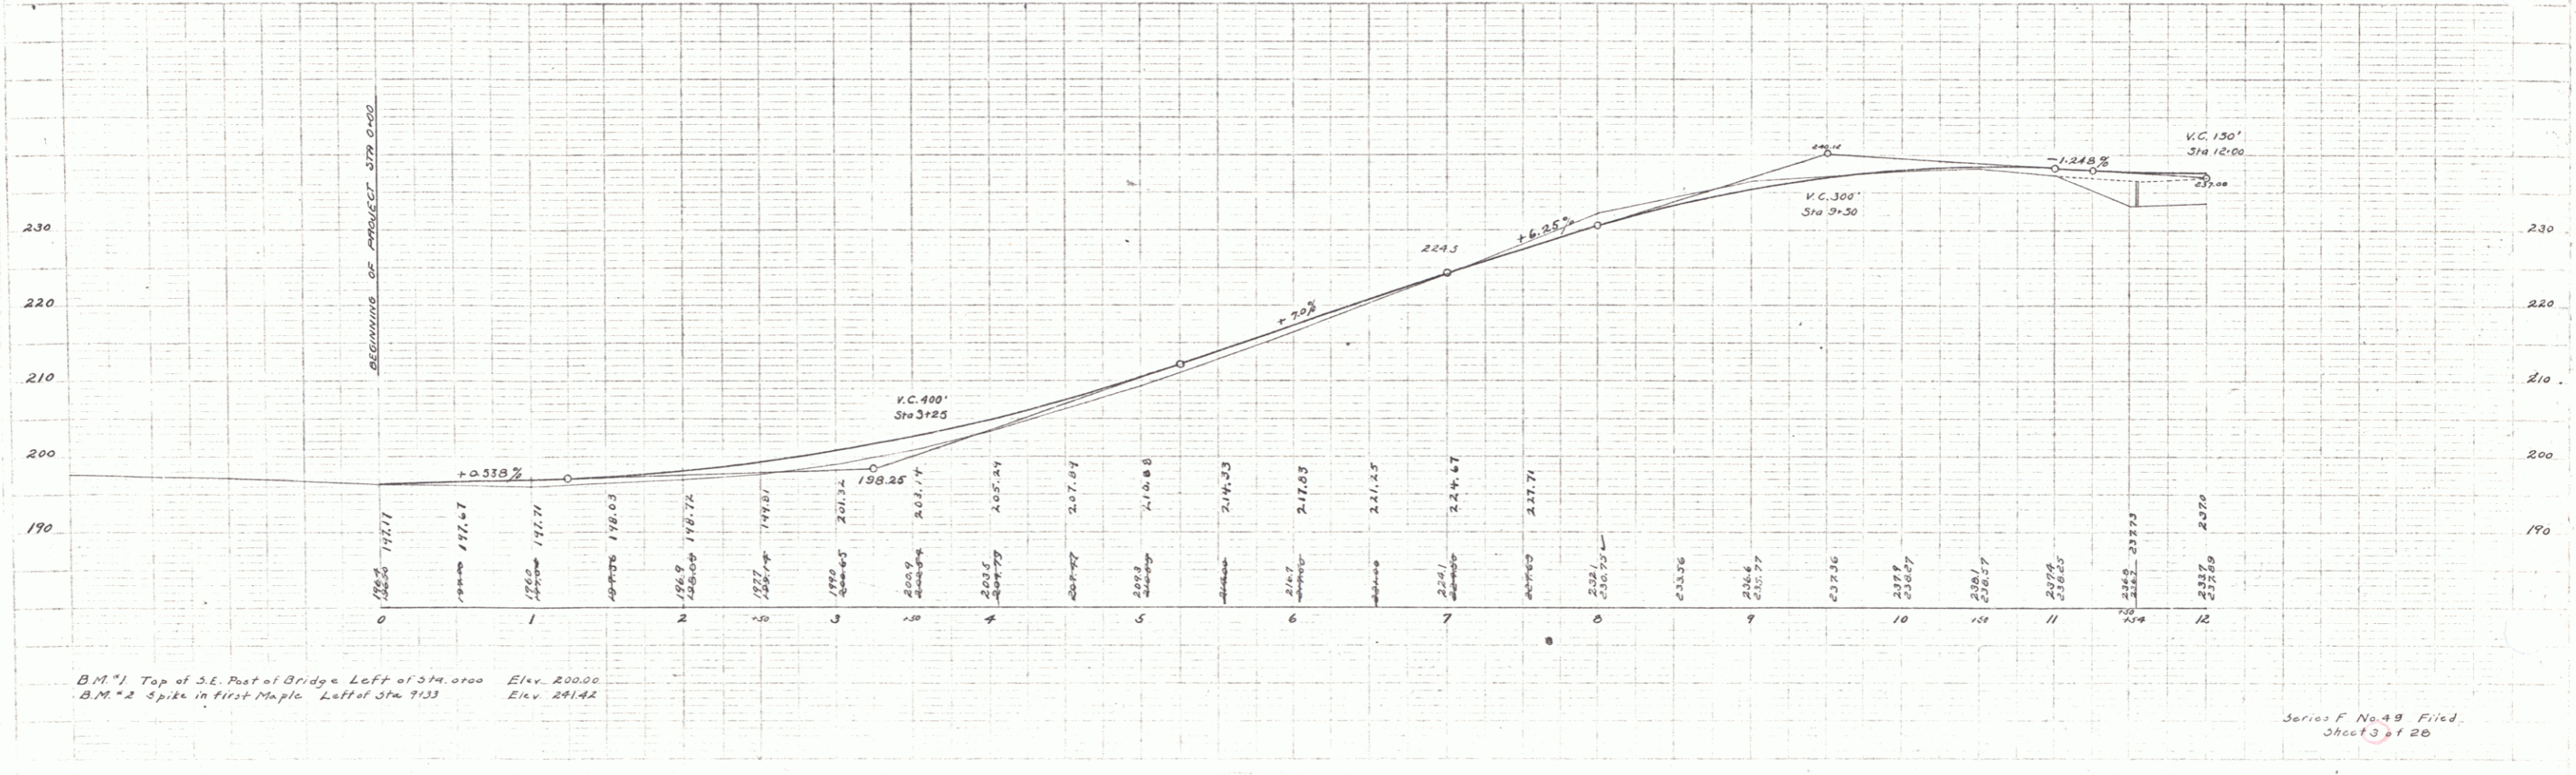


**GUARD RAIL REQUIRED**  
 On Left  
 Sta 11+42 to Sta 11+66 length 24 ft  
 On Right  
 Sta 10+20 to Sta 12+00 length 180 ft  
 Total this sheet 204 ft

**NEW CULVERTS REQUIRED**  
 Sta 11+54 V 3'x3' Concrete 5.2  
 1-2-4 " 11.8 cu yds  
 1-2-5 " 11.8 " "  
 Earth Excav. 34 " "  
 Sta 10+40 14" Cor. I. Pipe 36'  
 1-2-4 Concrete 2.5 cu yds

**SUBBASE REQUIRED**  
 Sta 0+00 to Sta 3+00 length 300 ft  
 Sta 0+50 to Sta 10+50 " 1000 ft  
 Sta 4+00 to Sta 11+50 length 750 ft  
 Total this sheet 2050 ft  
 Sta 10+55 to Sta 11+35 length 80 ft

PER. ROAD	DATE	PER. NO.	PLAN. NO.	SHEET NO.	TOTAL SHEETS
7	7	4.9	1923	3	20

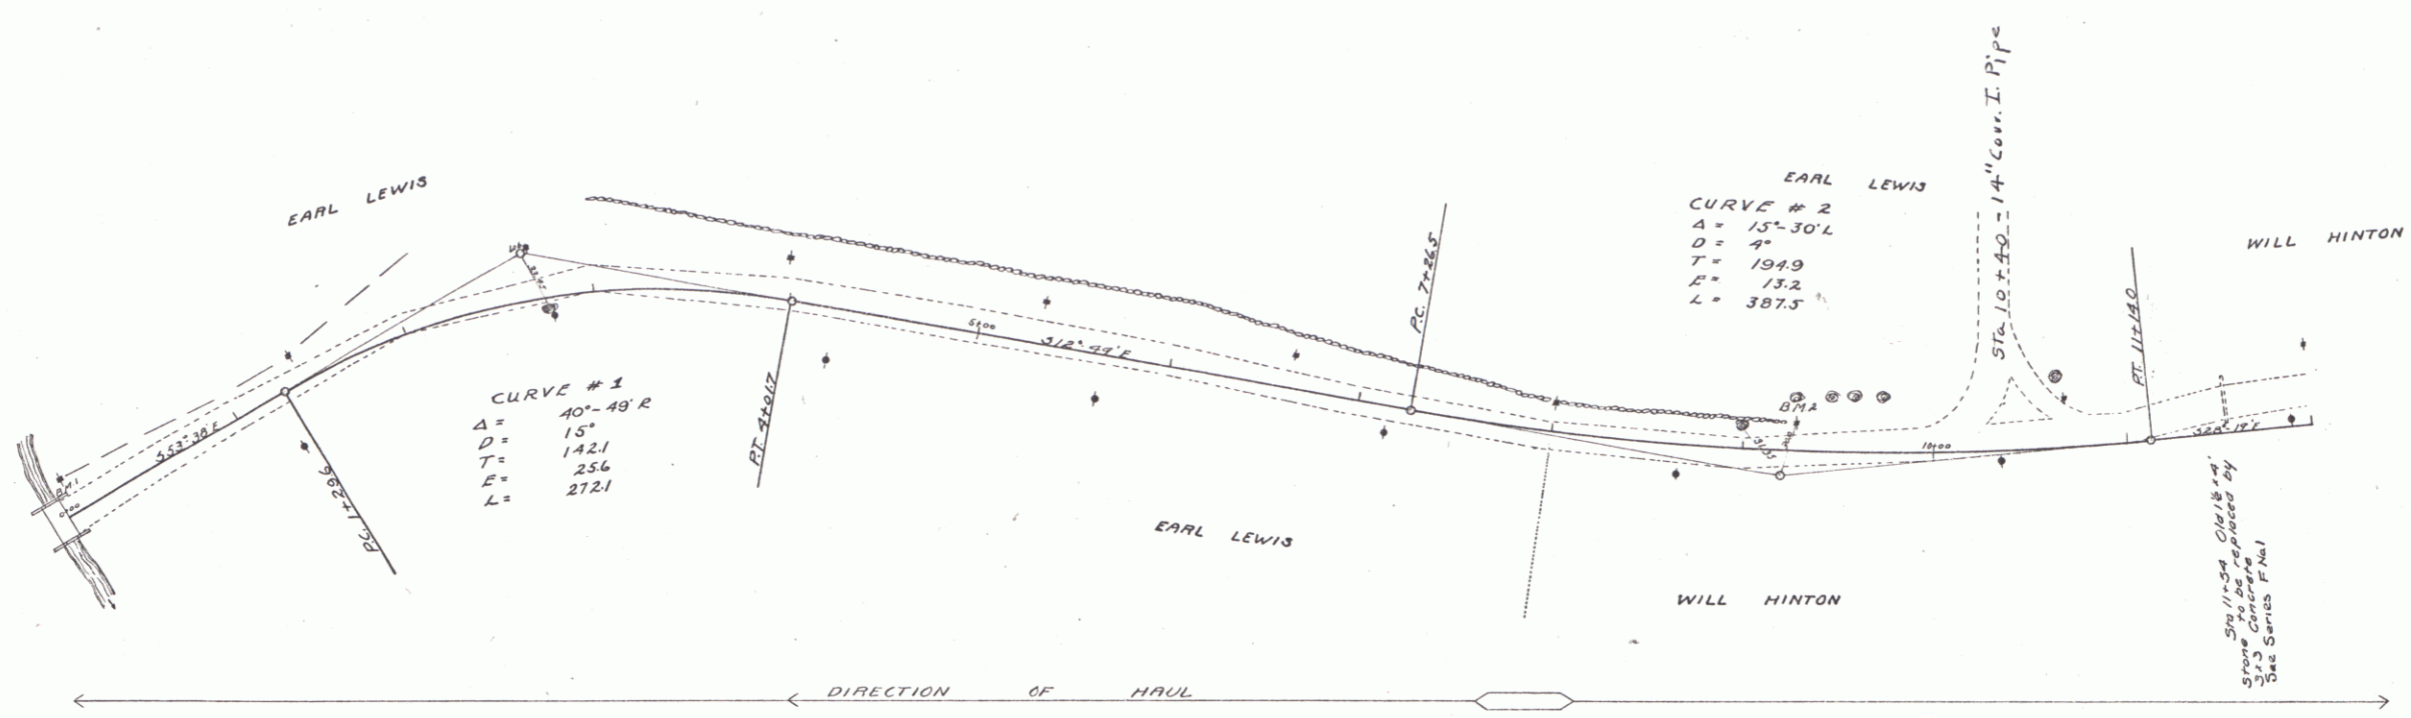

B.M. #1 Top of S.E. Post of Bridge Left of Sta. 0+00 Elev. 200.00  
 B.M. #2 Spike in first Maple Left of Sta 1+33 Elev. 241.42

Series F No. 49 Filed  
 Sheet 3 of 20