

**GUARD RAIL REQUIRED**  
 ON LEFT  
 Sta 62+97 to Sta 63+21 length 24 ft. ✓  
 " 70+10 " " 70+42 " 24 ft. ✓  
 ON RIGHT  
 Sta 62+75 to Sta 63+79 length 104 ft. ✓  
 " 70+10 " " 70+42 " 24 ft. ✓  
 Total this sheet 176 "


**NEW CULVERTS REQUIRED**  
 Sta 63+09 ✓  
 3x3 Concrete  
 1-2-4 " 8.06 cu yds  
 1-2-5 " 10.98 " "  
 EARTH EXC. 26 " "  
 Sta 70+30 ✓  
 3x3 Concrete  
 1-2-4 " 7.0 " "  
 1-2-5 " 10.57 " "  
 EARTH EXC. 44 " "

**SUB BASE REQUIRED**  
 Sta 57+00 to Sta 71+00 length 1400 ft

NO. SHEETS	STATE	FE. DIV.	DESIGN	SHEET NO.	TOTAL SHEETS
9	VT	49	1923	7	20

H.E. Walker  
 G.L. Fraw  
 1/15/23

H.E. Walker  
 G.L. Fraw  
 W.S. Murray  
 1/15/23

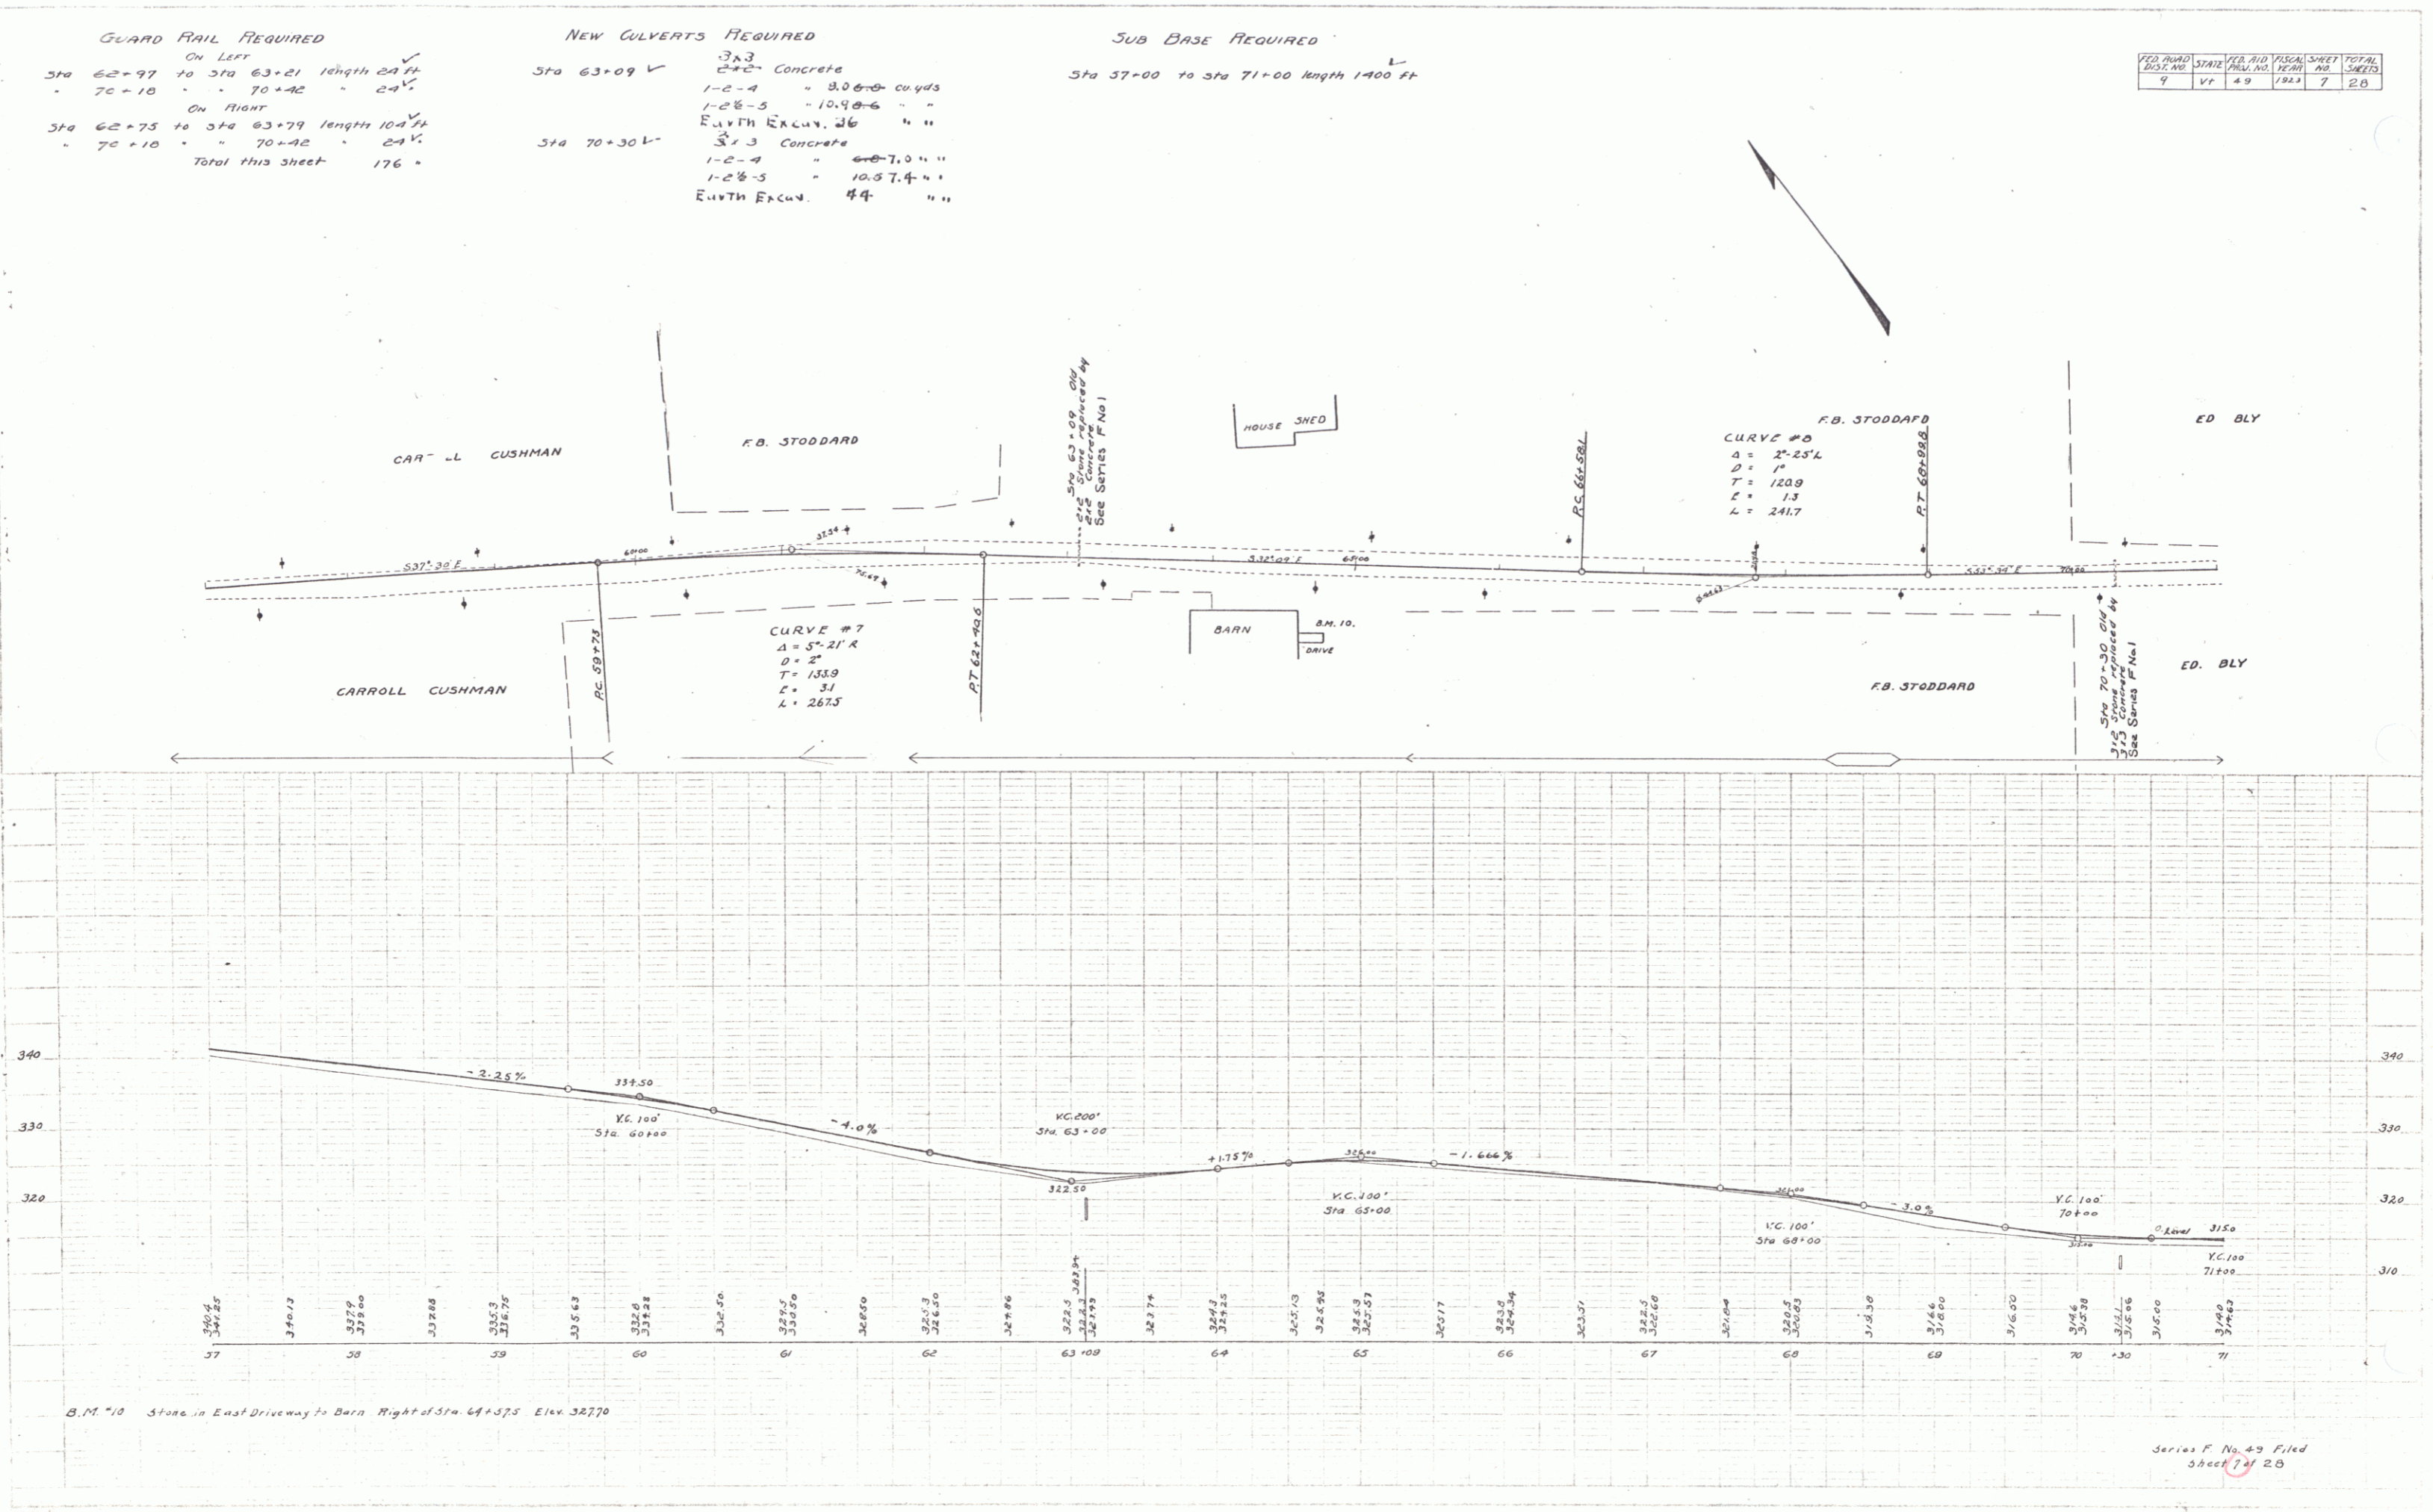

B.M. 10 Stone in East Driveway to Barn Right of Sta 64+37.5 Elev. 327.70

Series F No. 49 Filed  
 Sheet 7 of 20

6