


GUARD RAIL REQUIRED
ON LEFT
Sta 109+00 to Sta 110+12 length 24 ft
111+76 " 113+00 " 124 ft
ON RIGHT
Sta 109+00 to Sta 110+12 length 24 ft

NEW CULVERTS REQUIRED
Sta 110+00 1-1/2' Corrugated Iron Pipe 30 ft
1-2' Conc. Headwalls 15' x 15'
RIP RAP FILL
8" H

SUB BASE REQUIRED
Sta 100+00 to Sta 102+00 length 200 ft
103+00 " " 109+00 " 600 ft
Total this Sheet 850'

NO	DATE	BY	CHKD	DATE	NO	DATE
1	1/15	YF	49	1/13	10	20

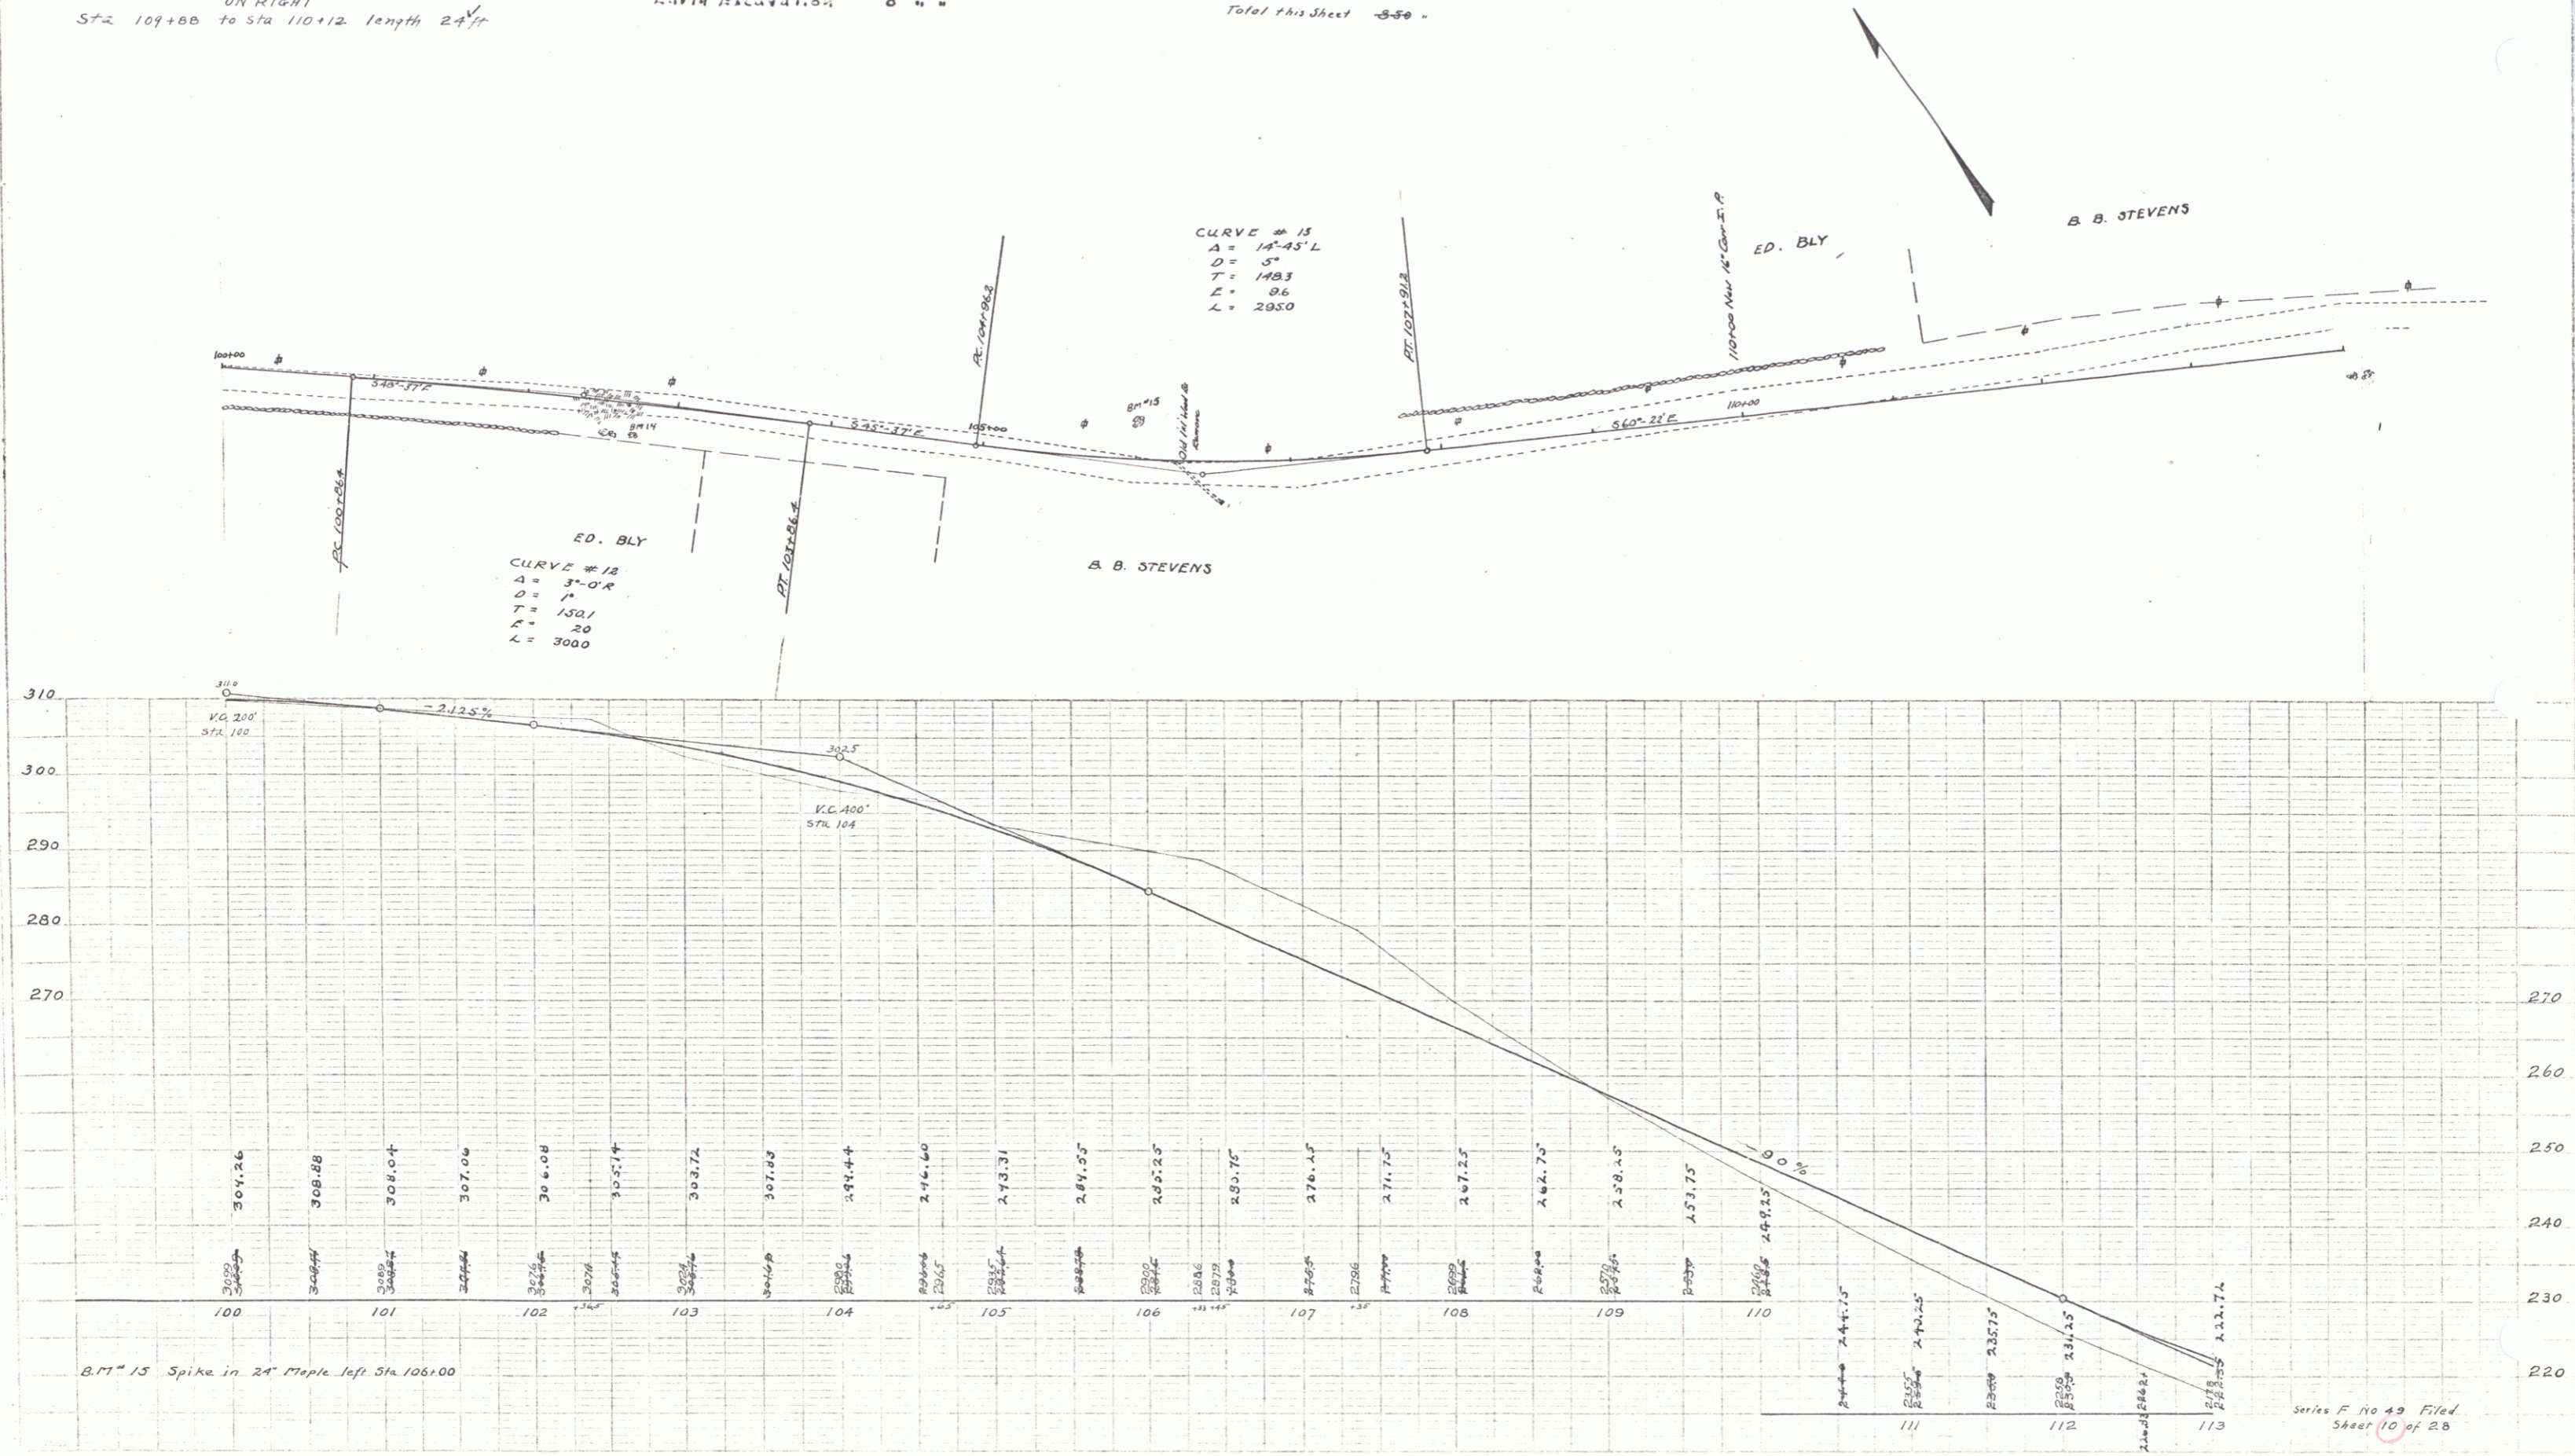

Series F No 49 Filed
Sheet 10 of 28