

GUARD PILE REQUIRED

On LEFT	
Sta 130+00 to Sta 131+12 length 24 ft	✓
- 139+24 - " 139+48 - 24	✓
- 142+36 - " 142+00 - 24	✓
On RIGHT	
Sta 130+00 to Sta 131+12 length 24 ft	✓
- 135+28 - " 136+00 - 72	✓
- 139+24 - " 139+48 - 24	✓
- 142+36 - " 143+00 - 44	✓
Total this sheet	236 ft


NEW CULVERTS REQUIRED

Sta 131+26	2x2 Concrete	5.3 cu yds
Sta 131+00	1-2-4 " "	7.5 " "
	1 2 1/2-5 " "	7.5 " "
	Earth Excavation	37 " "
Sta 139+36	3x2 Concrete	6.87 cu yds
	1-2-4 " "	7.8 " "
	1-2 1/2-5 " "	7.8 " "
	Earth Excav.	70 " "
Sta 142+60	1-2 Cor Iron Pipe	38 ft
	1-2 Conc Headwalls	1-2 cu yd
	Earth Excav	5 " "

SUB BASE REQUIRED

Sta 127+00 to Sta 143+00 length 1600 ft.	700
--	-----

FED. ROAD DIST. NO.	STATE	FED. AID PROJ. NO.	FISCAL YEAR	SHEET NO.	TOTAL SHEETS
9	VA	49	1923	22	20

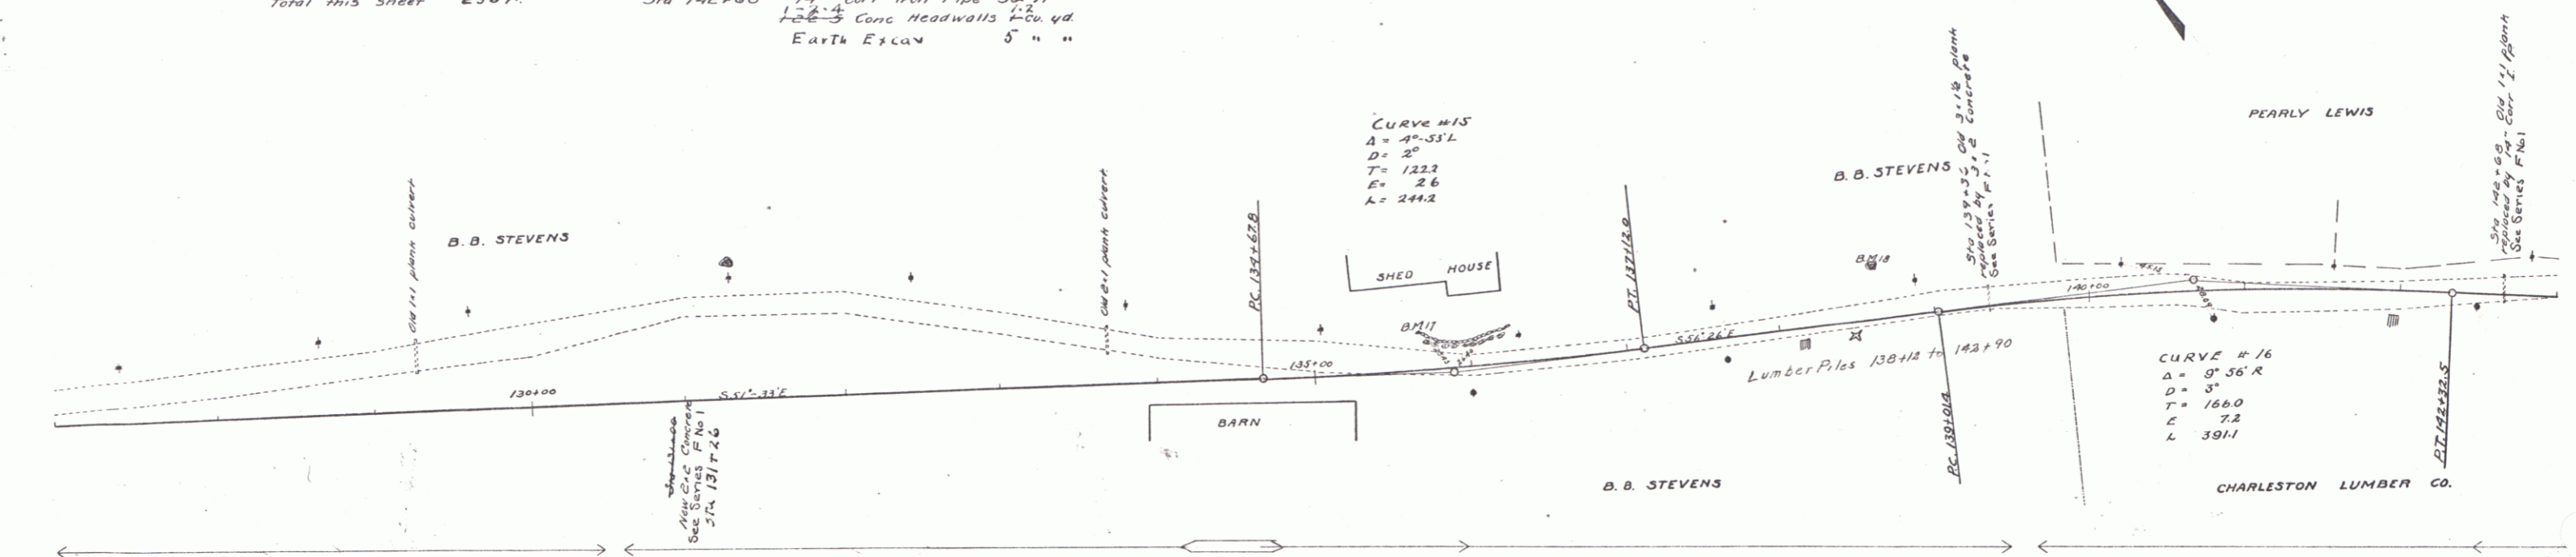

W. E. Hootner
D. L. Hootner
D. F. Hootner
D. F. Hootner

W. E. Hootner
D. L. Hootner
D. F. Hootner
D. F. Hootner

D.M. #12 Top of Stone in Wall Left of Sta 135+65 Elev 211.90
D.M. #10 Spike in Root of 30' Elm Left of Sta 130+63 Elev 200.92

Series F. No. 49 Filed
Sheet 12 of 20