
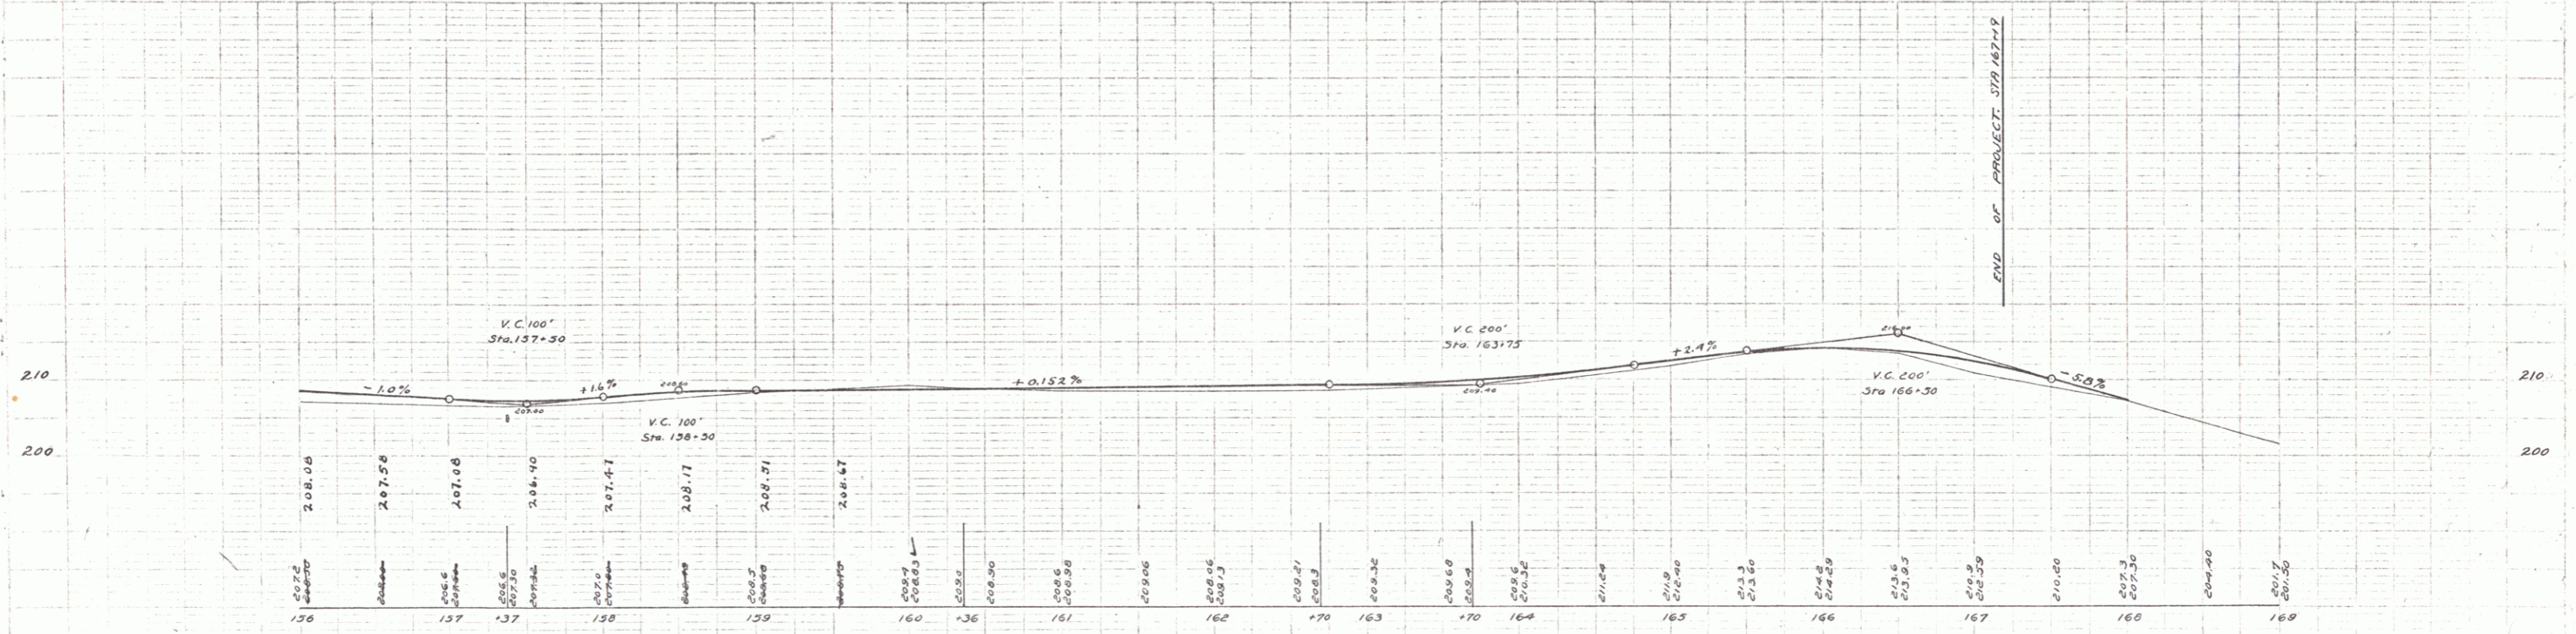


**GUARD RAIL REQUIRED**  
 On Left  
 Sta 153+25 to Sta 153+49 length 24 ft  
 On Right  
 Sta 156+00 to Sta 159+49 length 349 ft  
 158+98 " 163+00 " 41 ft  
 163+38 " " " 62 ft  
 Total This Sheet 445 ft

**NEW CULVERTS REQUIRED**  
 Sta 157+37 1/4" Corr Iron Pipe 30 ft  
 1 1/2" Conc. Headwalls 1/4 cu yd Earth Exc 9 cu yd  
 Sta 163+70 1/4" Corr Iron Pipe 30 ft  
 1 1/2" Conc. Headwalls 1/4 cu yd  
 Earth Excavation 12 cu yd

**SUB BASE REQUIRED**  
 Sta 156+00 to Sta 160+00 length 400 ft

FEED ROAD	STATE	FILE NO	LOCAL YEAR	SHEET NO	TOTAL SHEETS
9	VT	1943	17	20	

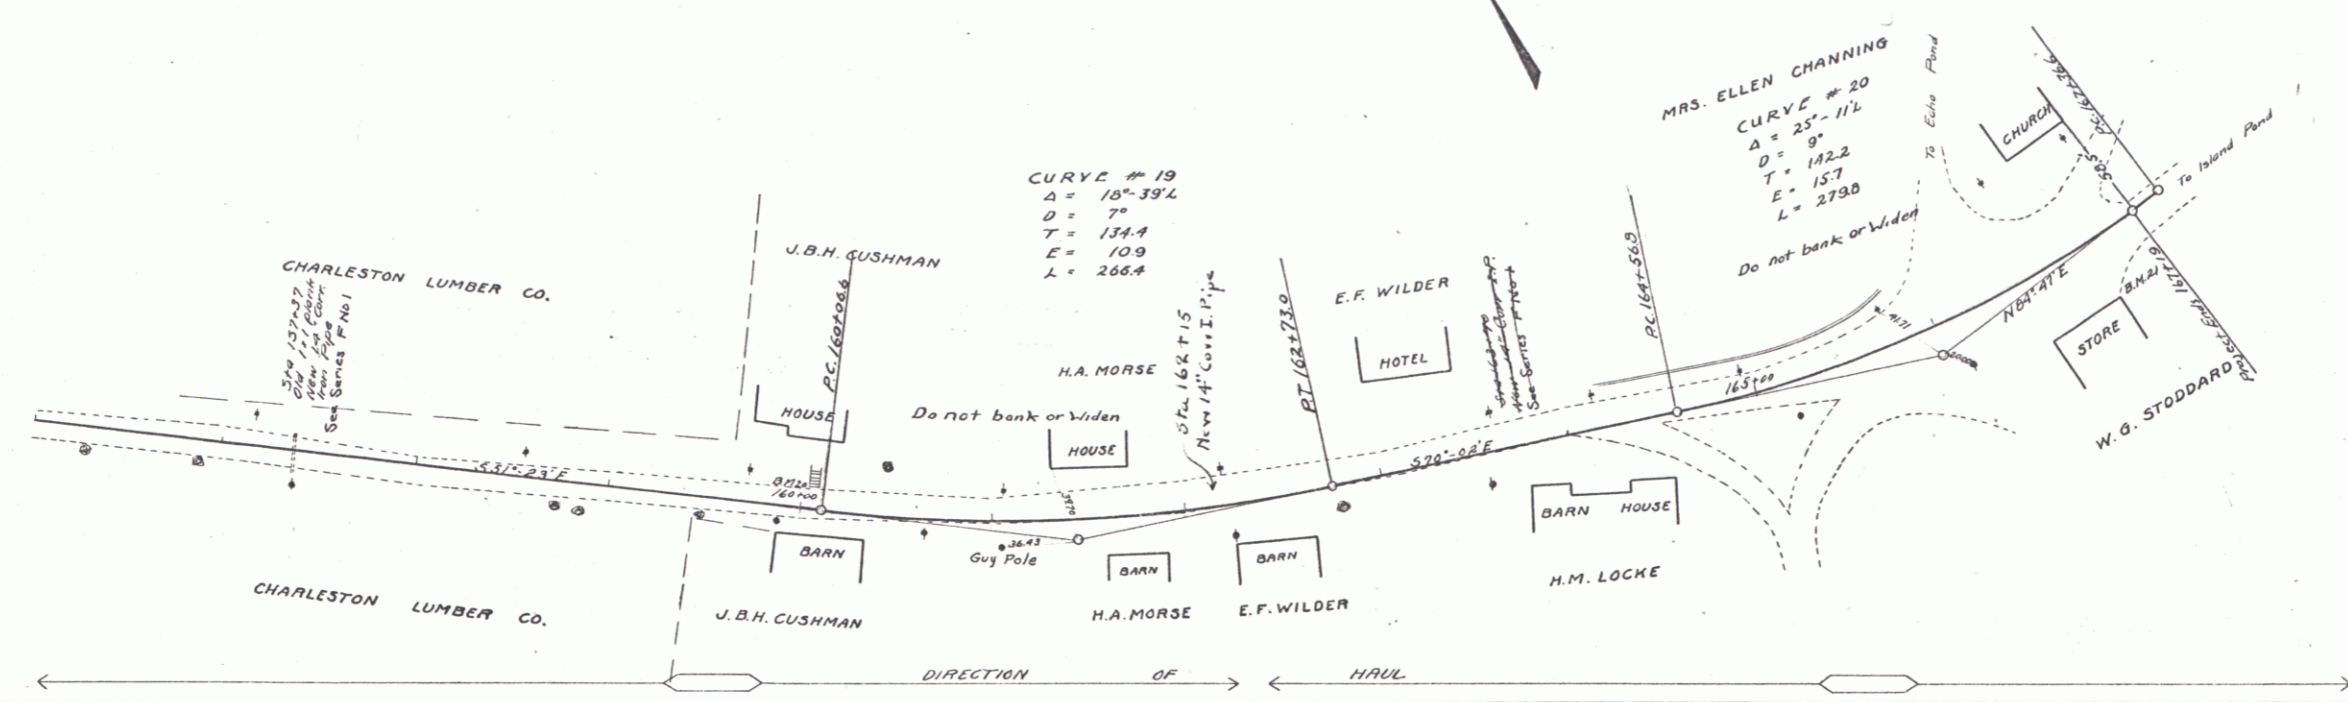

B.M. \*20 West End of Bottom Step Left of Sta. 160+03 Elev. 210.27  
 B.M. \*21 East End of Stone Step Right of Sta. 164+00 Elev. 213.35

Series P. No. 49 Filed  
 3001 1943