
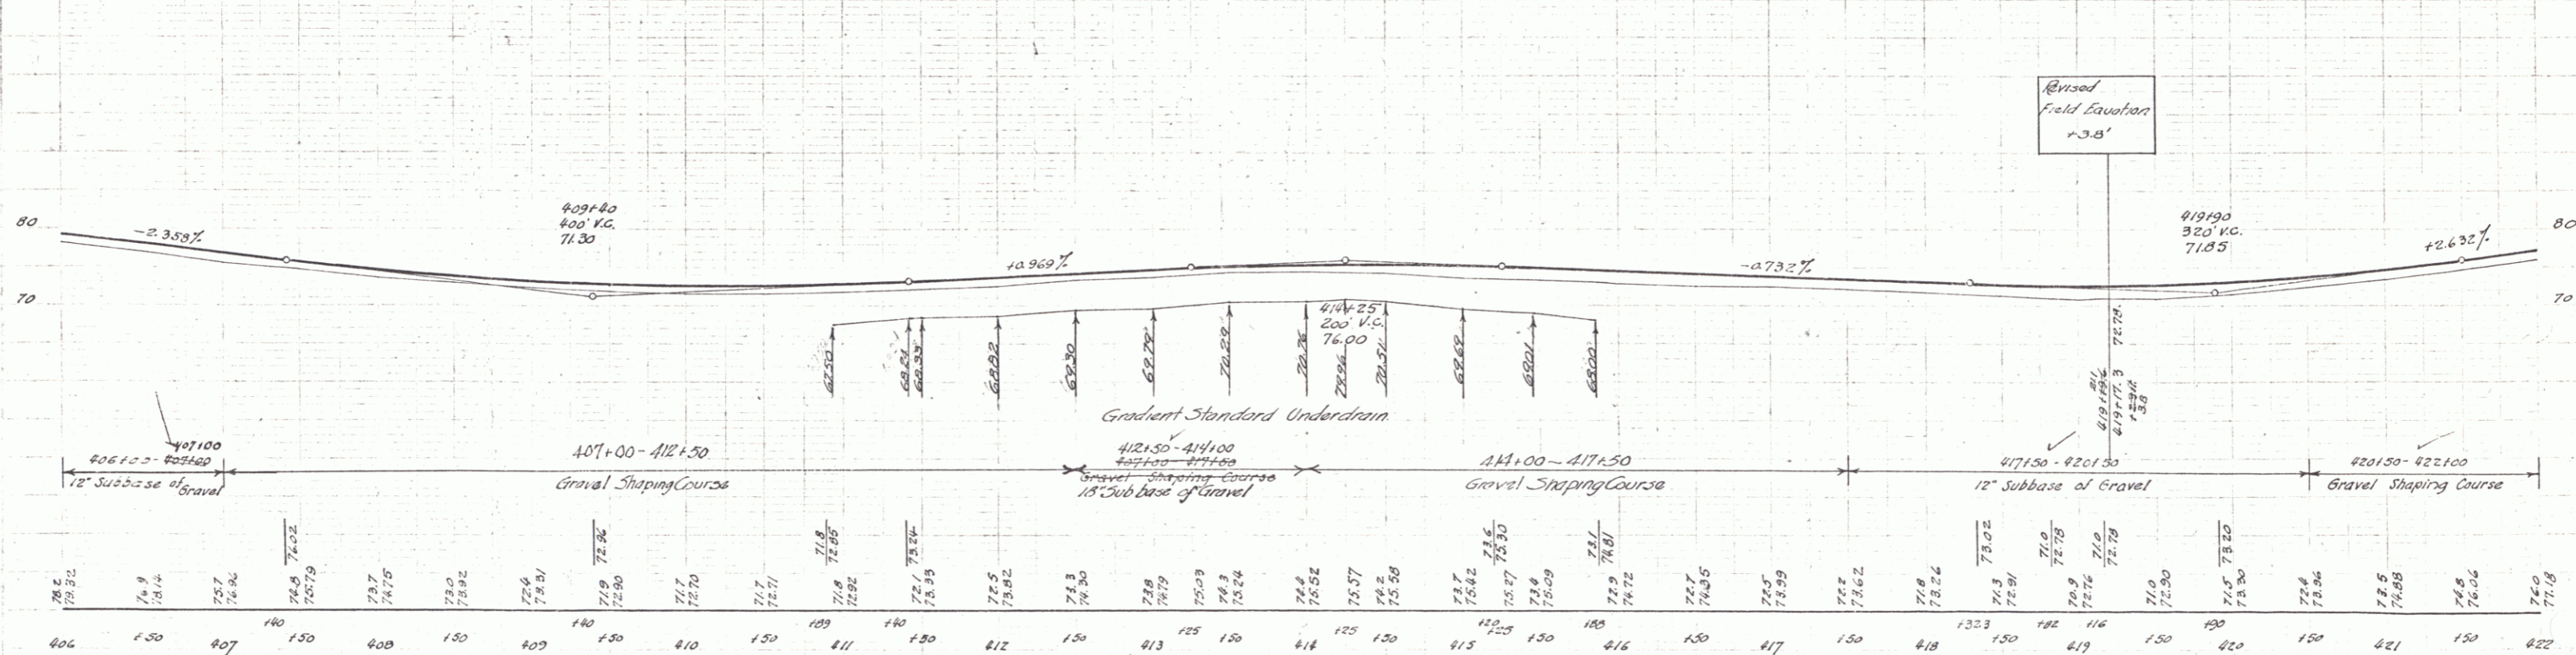


PARCEL LISTMENT DATE GRANTOR GRANTEE RECORDED REMARKS
 A QCD 9-2-39 PERLEY LEWIS ST. OF W. CHARLETTON PAGE 438 DATE 8-8-39

STATE OF MISSISSIPPI SHEET TOTAL
 49(1) 1988 5 85

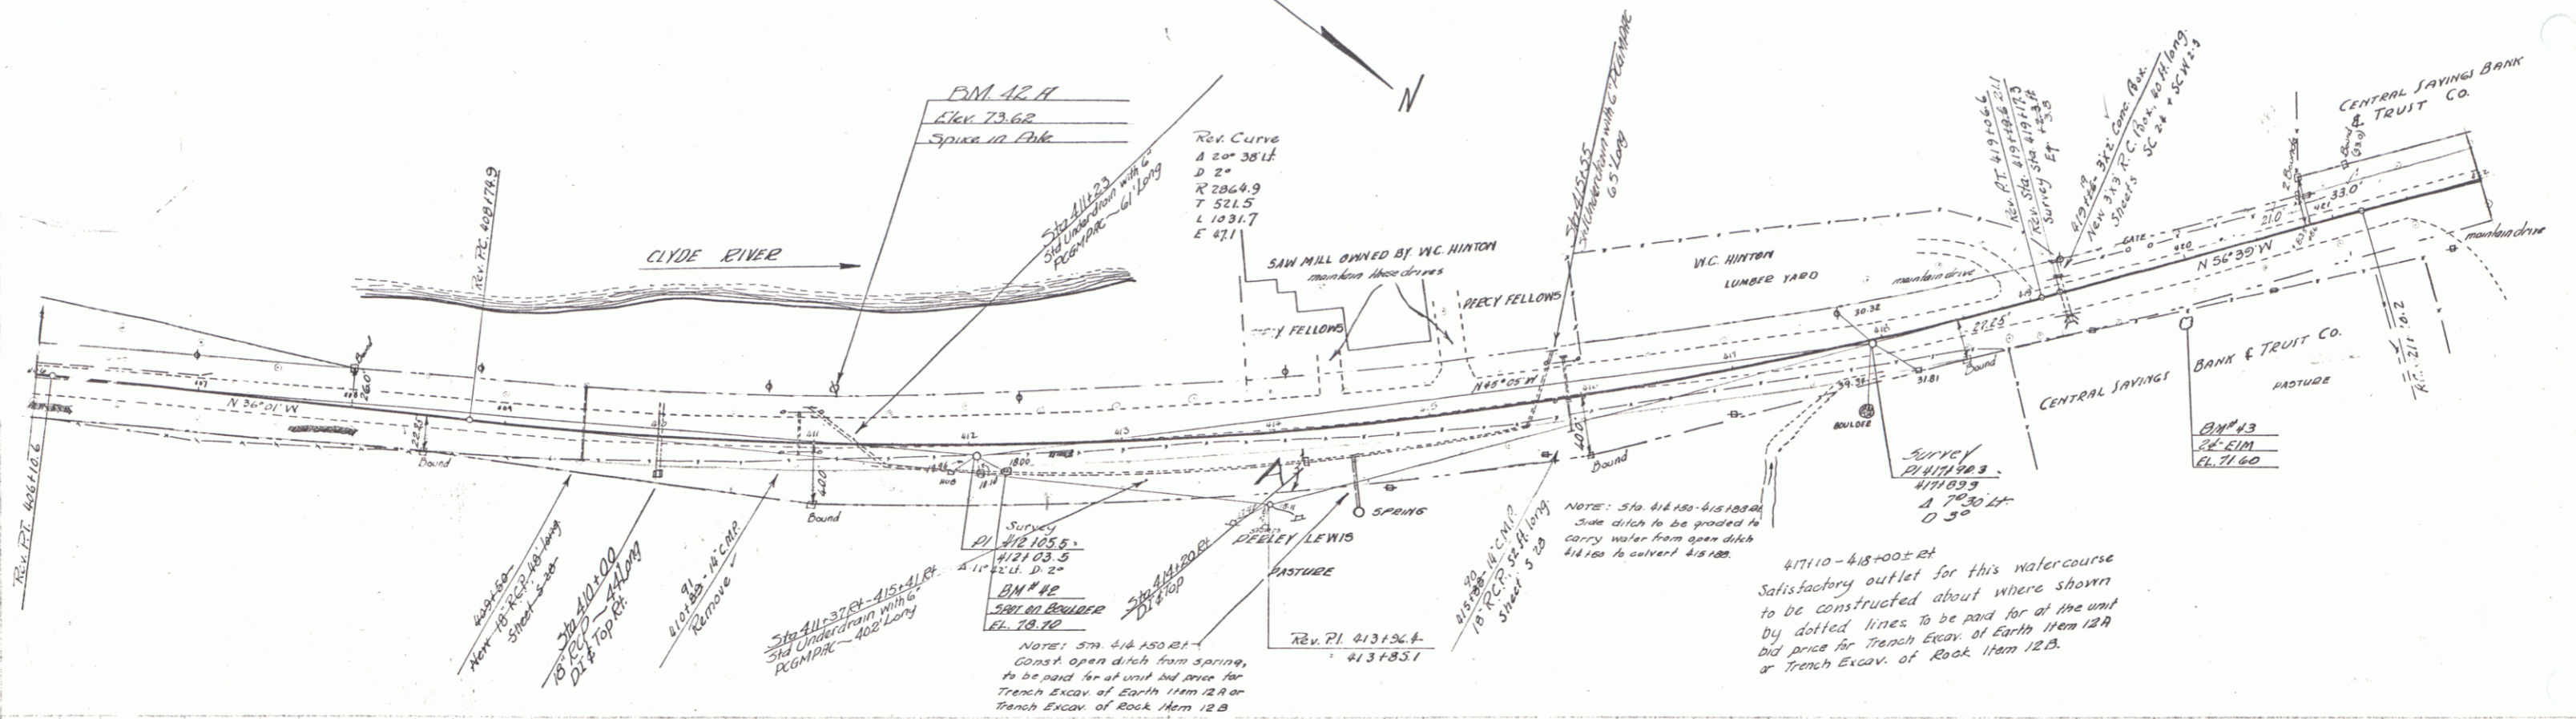

BM #12 Spot on Bowler 25' E. Sta. 412102 El. 70.70 BM #21 Spot inside 35' L. 414.11 El. 73.62
 BM #19 S.P. of W. Elm 31' E. Sta. 419190 El. 71.60

SERIES FAP No. 89(2)
 SHEET 5 of 85