
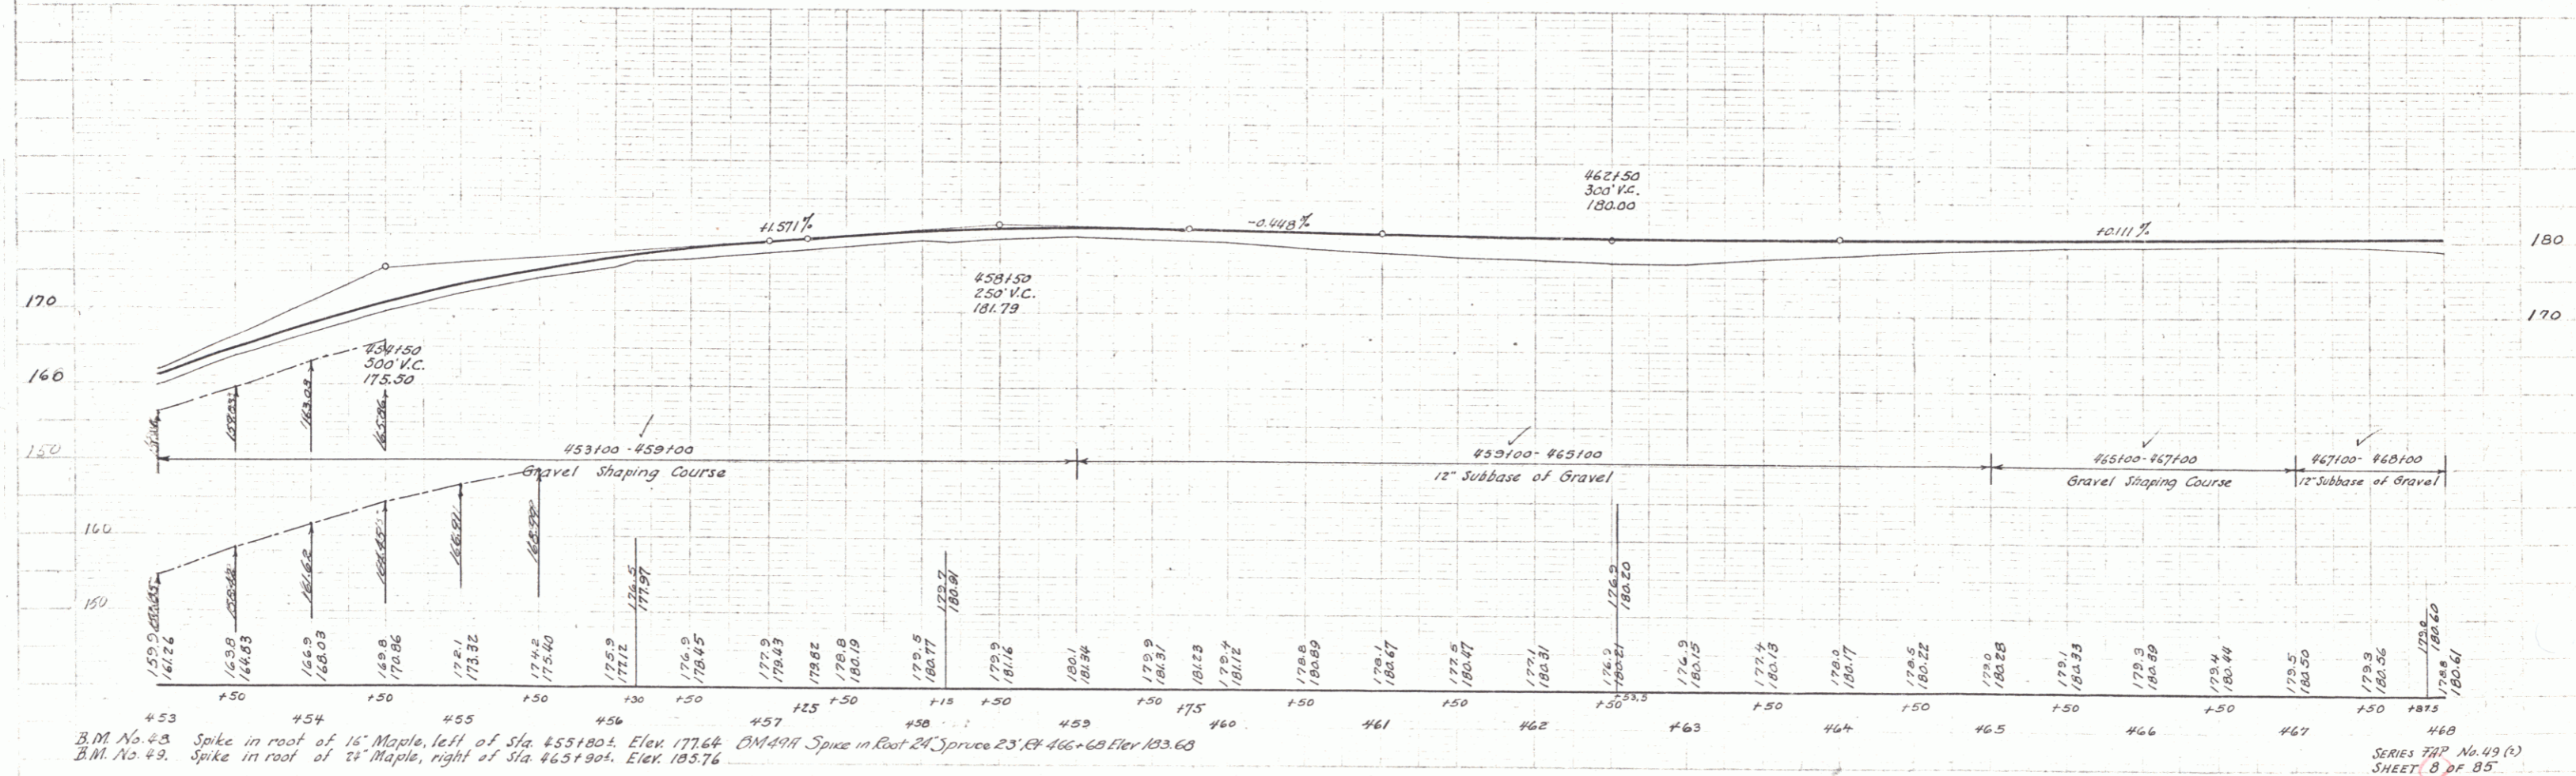


PARCEL INSTRUMENT DATE GRANTOR GRANTEE RECORDED REMARKS
 A Q.C.D. 9-27-39 HARLEY BLY ST OF VT CHARLETON
 BOOK PAGE DATE
 23 242 10-6-39

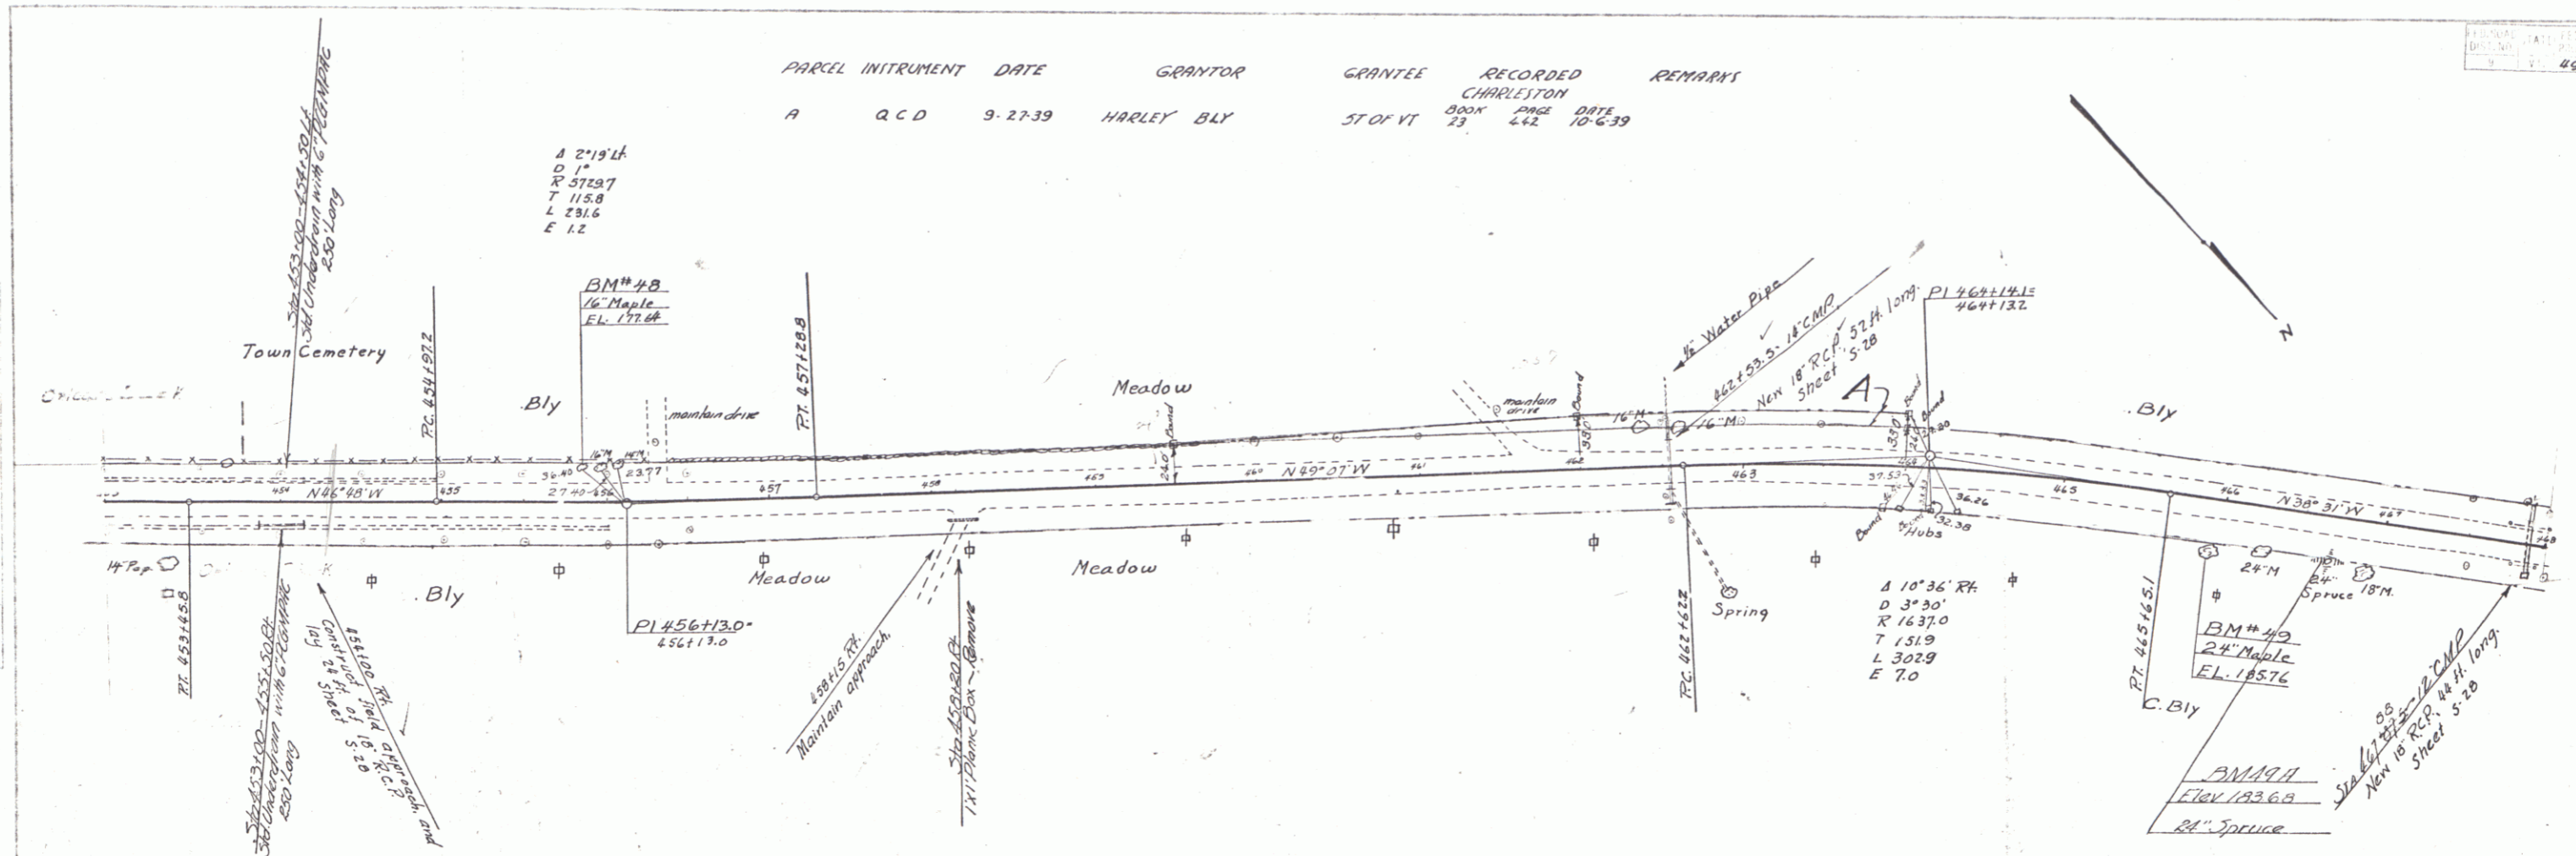

B.M. No. 48 Spike in roof of 16" Maple, left of Sta. 455180.4. Elev. 177.64
 B.M. No. 49 Spike in roof of 24" Maple, right of Sta. 465190.4. Elev. 183.76
 B.M. No. 49A Spike in Root 24" Spruce 23' E of 466+62 Elev. 183.63
 SERIES 77P No. 49 (1)
 SHEET 8 OF 85