
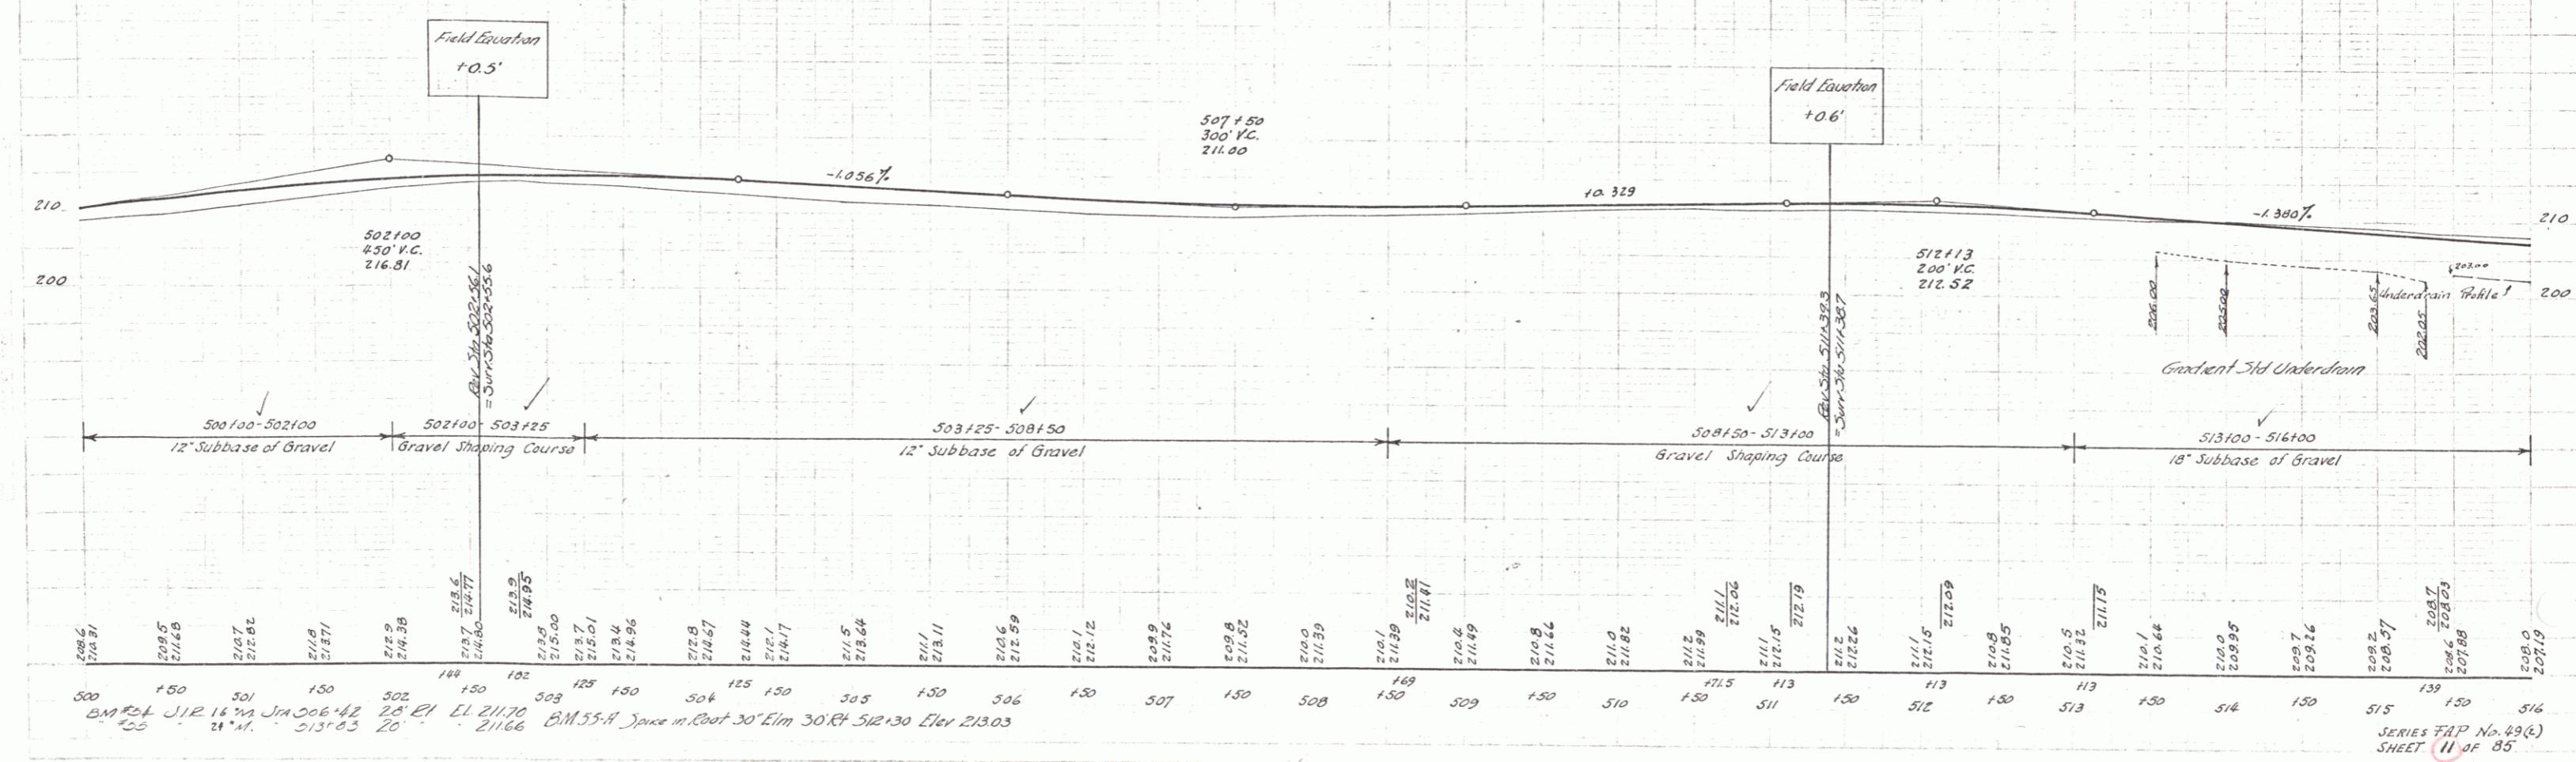


PARCEL	INSTRUMENT	DATE	GRANTOR	GRANTEE	RECORDED	REMARKS
A-B	Q.C.D.	3-2-39	VANVOY MOULTON	ST OF VT	23	800M PAGE 3878
A'	Q.C.D.	10-13-39	CARROLL & RUBY CUSHMAN	ST OF VT	23	450 12-16-39

ORIGINAL STATE 450
 ORIGINAL INSTRUMENT 49(2)
 ORIGINAL DATE 1940 11 85

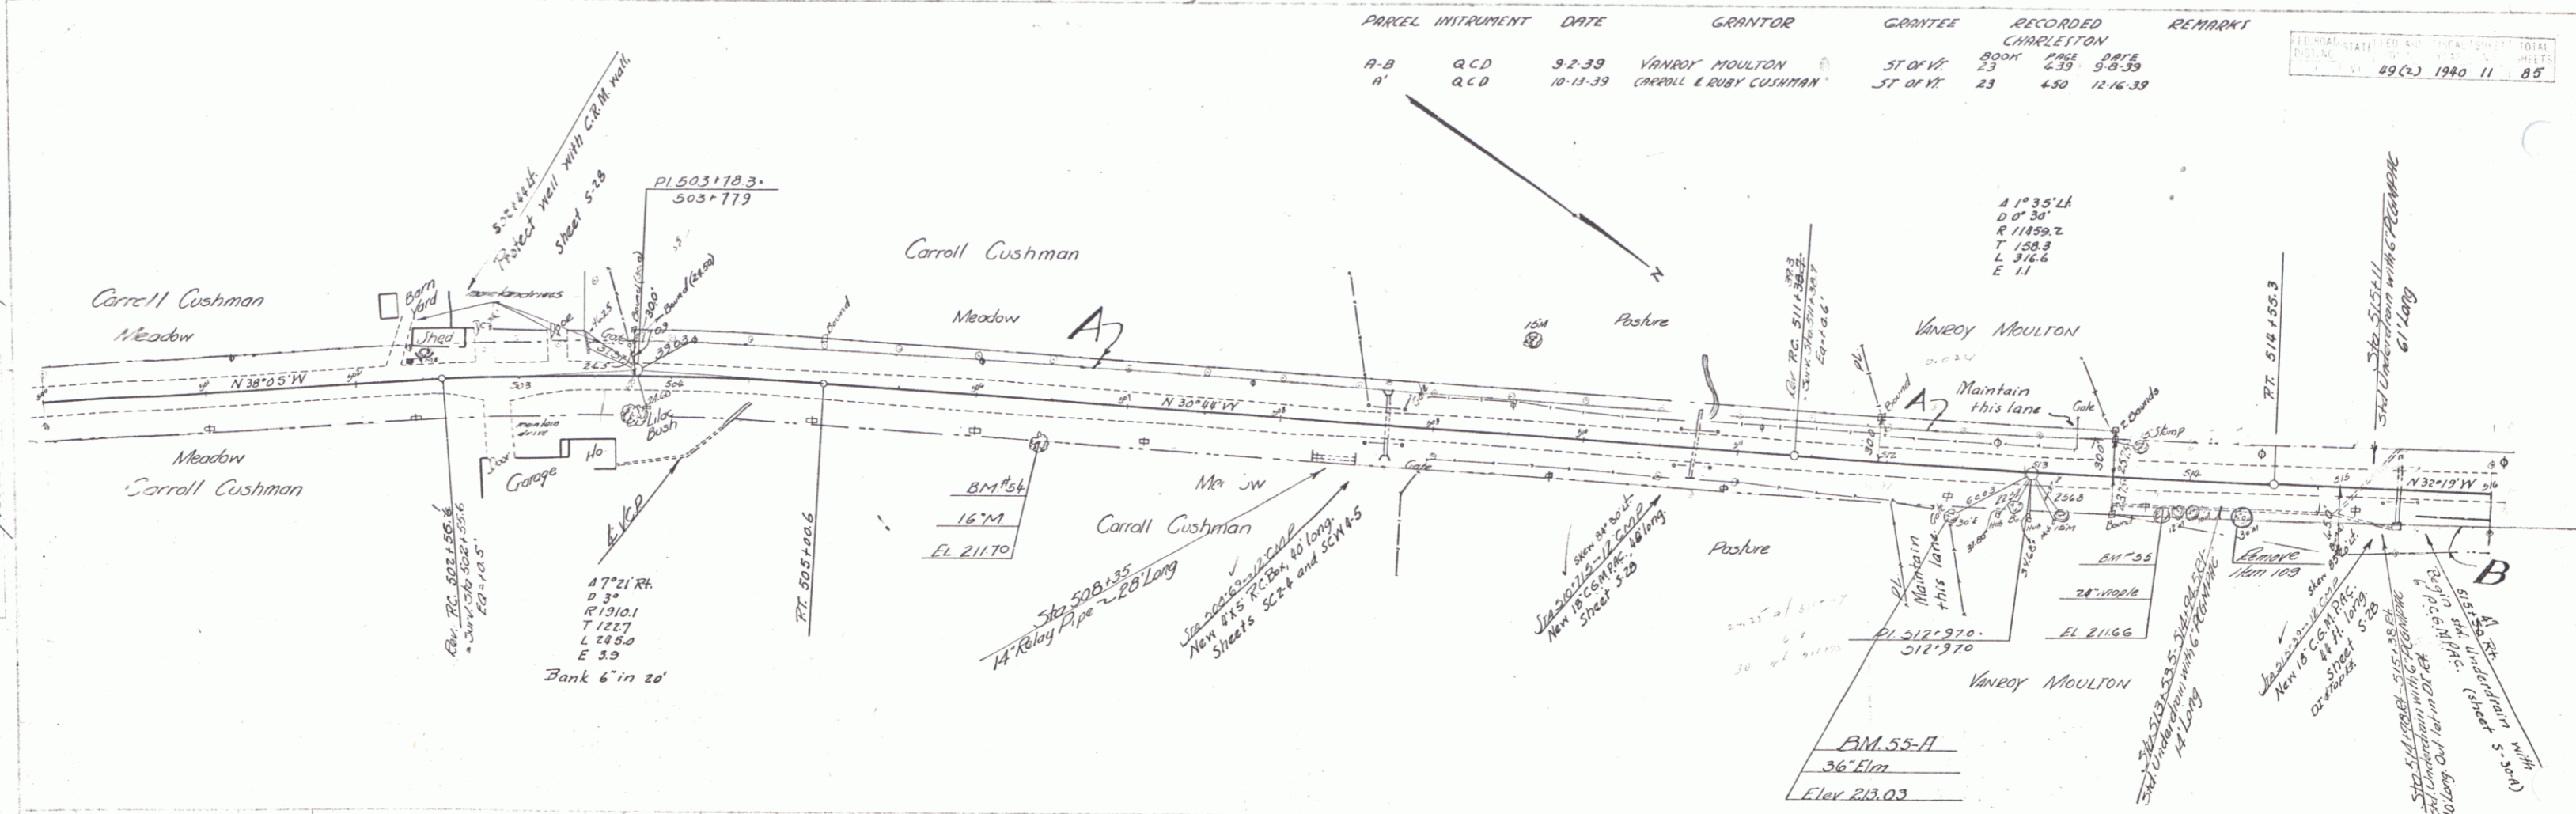

F. Barrett
 L. Linn
 5-31
 7-31
 faced
 7-31

F. Barrett
 L. Linn
 5-31
 7-31

BM 55-A (Elev. 213.03) used in computations. Stationing: 500+00 to 516+00.

SERIES MAP No. 49(2)
 SHEET 11 OF 85