


PARCEL	INSTRUMENT	DATE	GRANTOR	GRANTEE	RECORDED	REMARKS
B-0	A.C.D.	9-2-39	W.C. HINTON	ST OF VT.	BOOK 23 PAGE 438 DATE 9-8-39	

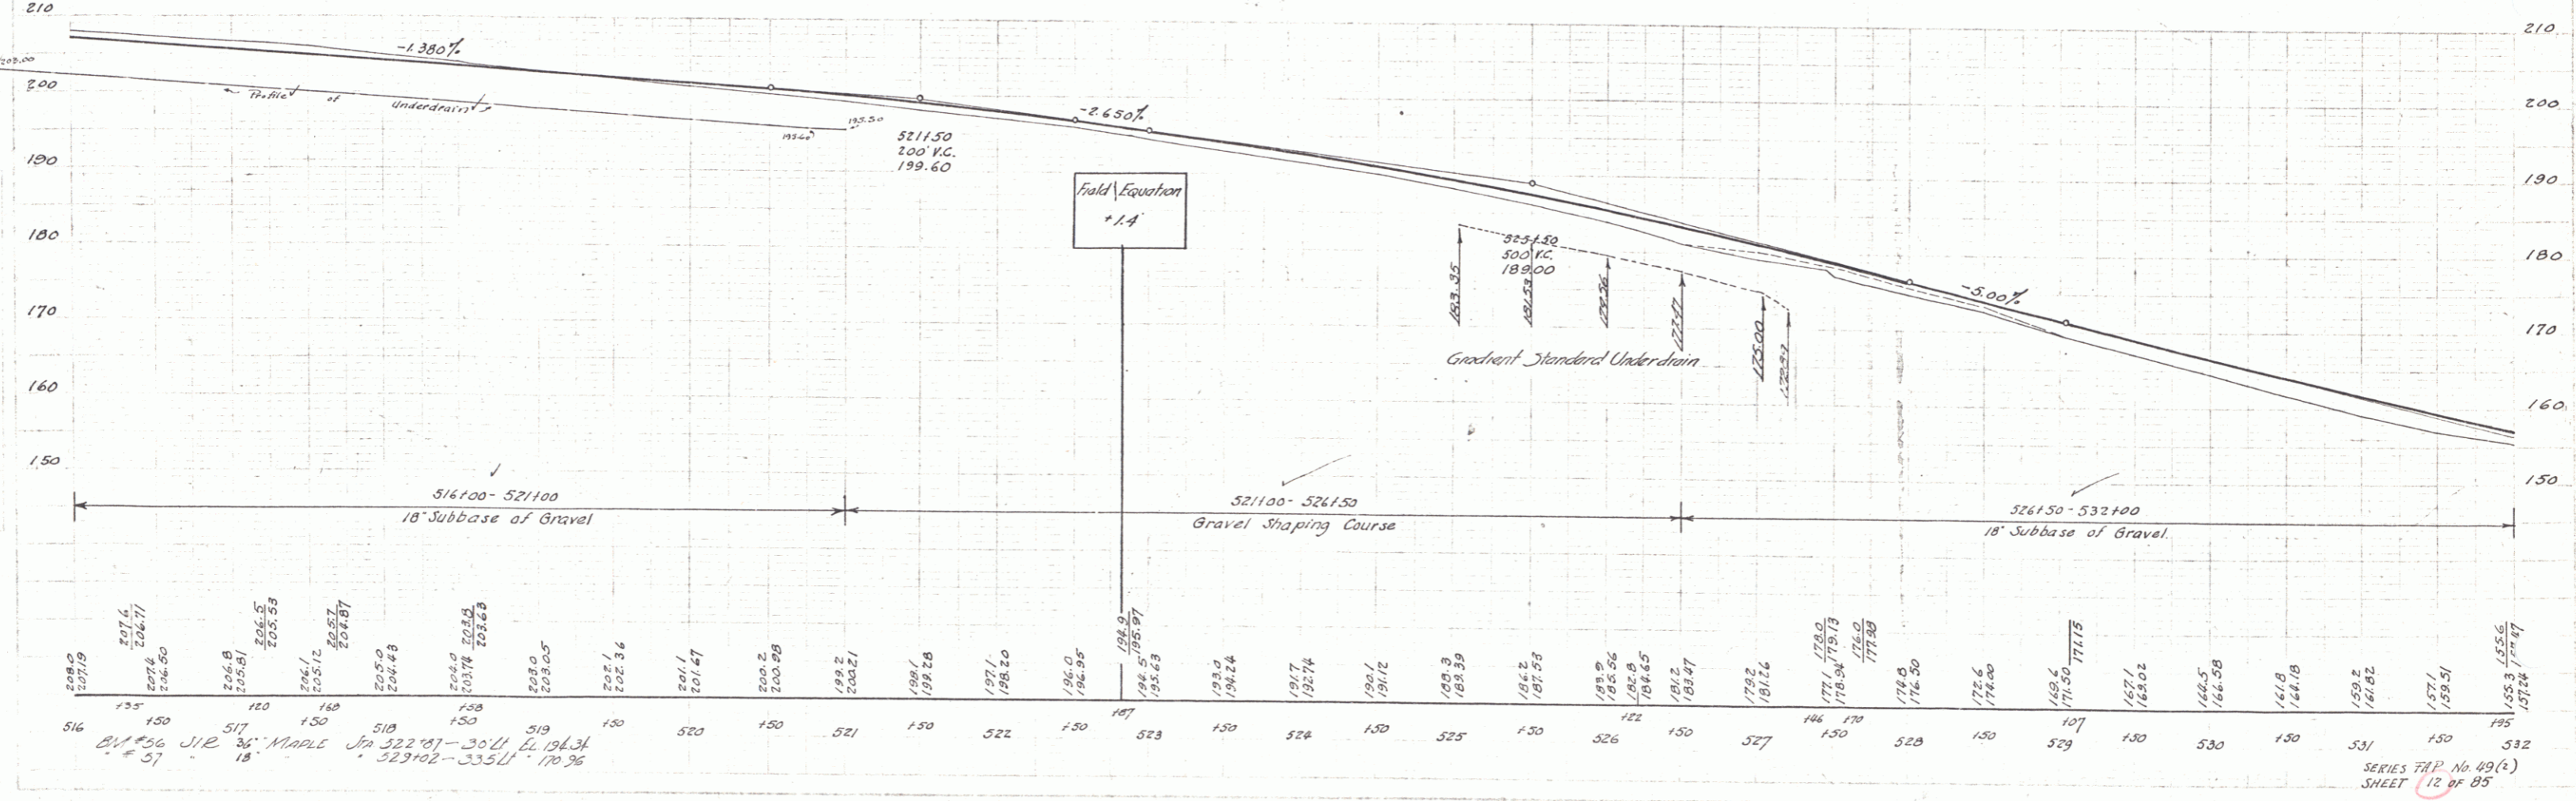

1/4" = 100' 7-31

1/4" = 100' 7-31