


EXISTING CURVED PAV. ON THIS PROJECT TO BECOME THE PROPERTY OF THE STATE

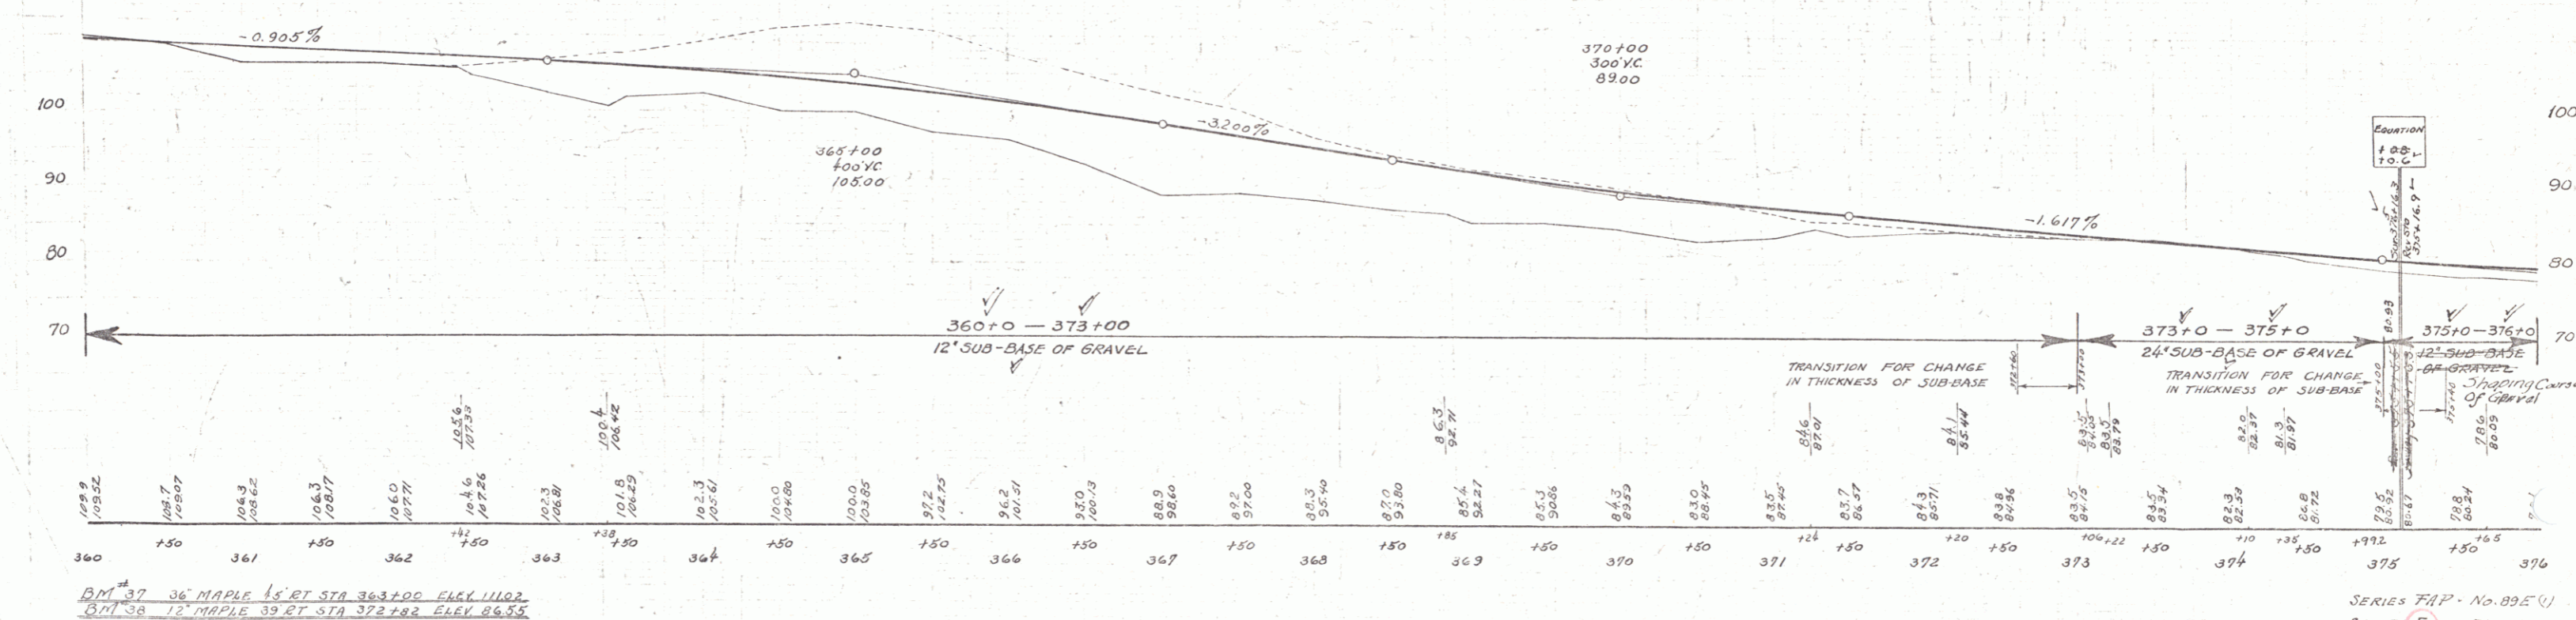

PARCEL	INSTRUMENT	DATE	GRANTOR	GRANTEE	RECORDED	REMARKS
F	Q.C.D.	4/20/28	GORDON COLBURN	ST OF VT.	23	BOOK PAGE DATE
A	Q.C.D.	4/26/28	E.O. HINTON	ST OF VT.	23	427 5/10/28 CUMULATIVE
A	Q.C.D.	9-20-38	PERY LEWIS	ST OF VT.	23	431 3-26-38
A'	Q.C.D.	7-26-39	NETTIE BUCK & HARRIET WILSON	ST OF VT.	23	434 8-3-39

B.M. 37 36' MAPLE 1/2" BT STA 363+00 ELEV. 110.2  
 B.M. 38 12" MAPLE 3/4" BT STA 372+82 ELEV. 86.55

SERIES FAP - No. 89E(1)  
 SHEET 5 OF 21