


PARCEL	INSTRUMENT	DATE	GRANTOR	GRANTEE	RECORDED	REMARKS
A	W.D.	5/6/38	HAZEL BENNETT	Sr. of VT.	23 91	TOWN OF CHARLESTON CON. AT 345+50 PASTURE
B	Q.C.D.	4/30/38	GORDON COLBURN	Sr. of VT.	23 427	5/10/38 Culvert 337+00

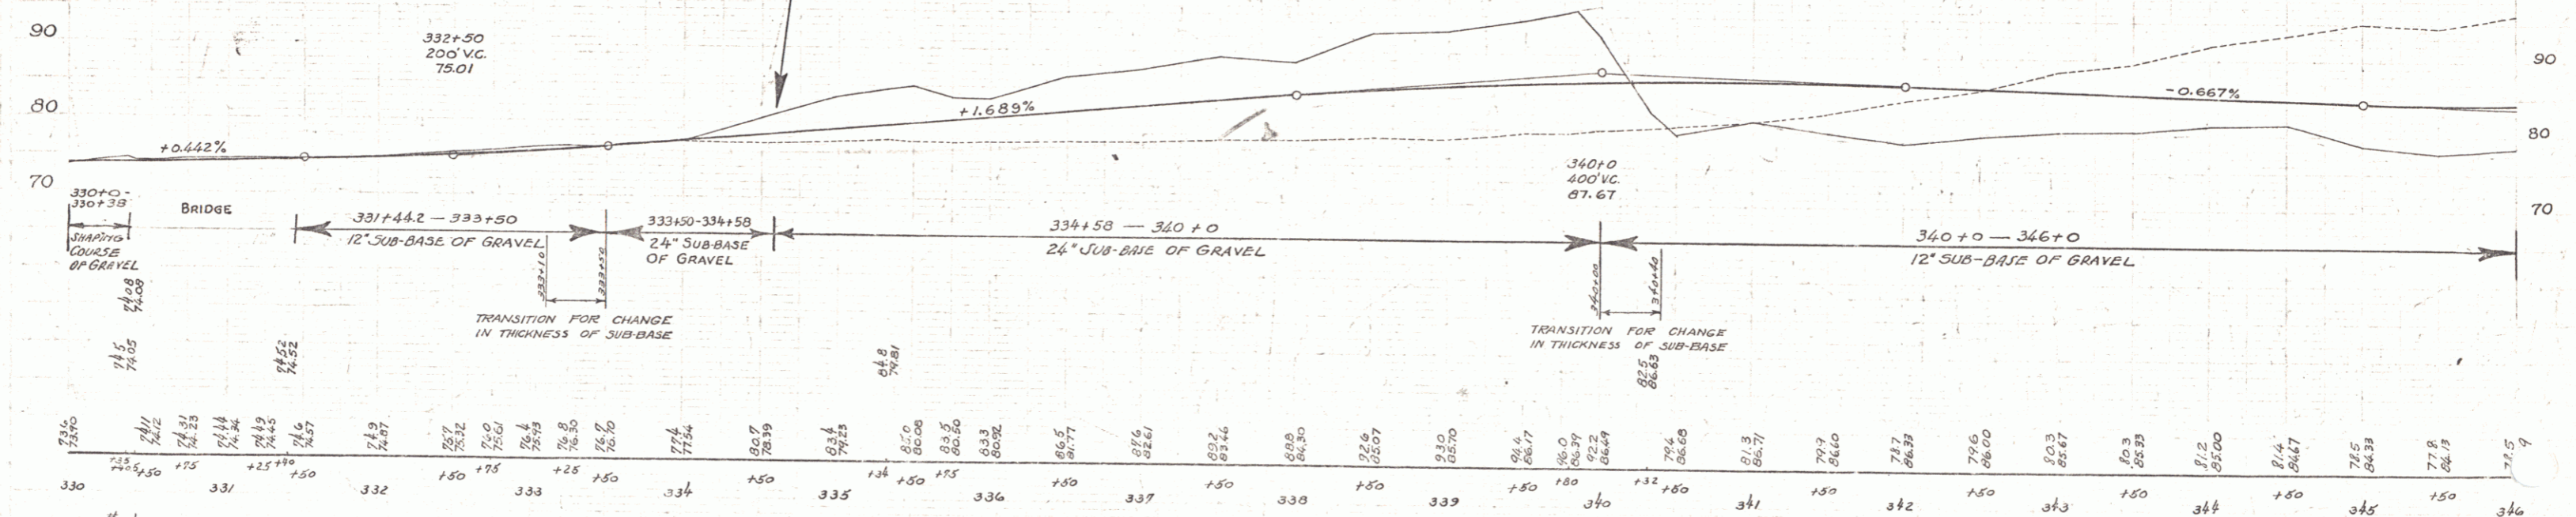

B.M. #34 SPOT ON CONC WING 12 FT 330+38 ELEV 74.58
 B.M. #35 SPIKE IN ROOT 18" SPRUCE 84 FT STA 341+71 ELEV 85.07