

**INDEX OF SHEETS**

1. Title Page
2. Typical Cross Section of Improvement
- 3-4. Quantity Summary Sheets
5. Drainage Sheet
- 6-10. Earthwork Sheets
- 10-11. R.O.W. Detail Sheets
- 12-28. Plan and Profile Sheets
29. Blank
30. Blank
31. Solid Rock Excavation
32. B-1 Banking Tables
33. B-5 Typical Slope Grating
34. B-5 Rock Excavation
35. B-10 Easement on a Slope
36. B-11 Slope Stabilization
37. B-11 Slope Stabilization
38. B-13 Drive Intersections
39. RCP-5-62 AT STA 44+25
40. MFCP-5-62 AT STA 78+00
41. 0-2 Storm Drain and Inlets
42. 0-4 Flushing Basins
43. E-1 Subcations, Signs & Lights
44. E-21 Traffic Signs
45. 0-2 Guard Rail
46. 0-4 Marker Posts
47. J-1 Project and Boundary Markers
48. Blank
49. Detail sheet - 10" C.A.N.P.P.
50. SB-PP1 - 31" Pipe
51. SB-PP2 - 64" Pipe
52. SB-21
53. 98-1 Plan and Elevation
54. 98-2 Quantity Sheet
55. 98-3 Earthwork Sheet
56. 98-4 Information Sheet
57. 98-5 Borings
58. 98-6 Framing Plan & Core Layout
59. 98-7 Abutment #1 - Plan & Elevation
60. 98-8 Abutment #1 - Details
61. 98-9 Abutment #2 - Plan & Elevation
62. 98-10 Abutment #2 - Details
63. 98-11 Approach Slab Details
64. 98-12 Channel Rehabilitation Plan
65. 98-13 Reinforcing Schedule
66. 98-14 General Notes
67. 98-15 Details A-C-Construction Details
68. 98-16-17 Details A-C-Construction Details
69. 98-18-19 Details A-C-Construction Details
70. 98-20 Details A-C-Construction Details
71. 98-21 Details A-C-Construction Details
72. 98-22 Details A-C-Construction Details
100. 98-50 Details A-C-Construction Details

**PROJECT NAME & NUMBER TYPE PVMT AREA**  
 BERKSHIRE F-66-034-1(1) BIT CONC. P.W.M.T. 33,579.68 S.Y.  
 - RECORD PLANS -  
 MATERIALS

SUBBASE OF GRAVEL - WELD PIT, BERKSHIRE, VT.  
 SUBBASE OF SAND - WELD PIT, BERKSHIRE & GREEN PIT, ENOSBURG, VT.  
 CUTBACK ASPHALT - MOBIL OIL CORP., ALBANY, N.Y.  
 BITUMINOUS CONC. PAVT - L. M. PIKE, SWANTON, VT.  
 REFINED TAR - WITCO CHEMICAL CO., WORCESTER, MASS.  
 METAL GULVERT PIPES - NEW ENGLAND METAL CULV. CO., WHITE R. JCT., VT.  
 PLANK GUARD RAIL - WHITE R. VALLEY HARDWOOD, INC., RANDOLPH, VT.  
 GUARD RAIL ITEMS, CONC. PIPES, & D.I.S. - S.T. GRISWOLD, INC., WILLISTON, VT.  
 CONC. CLASSES 'A' & 'B' - A. S. ANDERSON, SWANTON, VT.  
 ASPHALTIC ASBESTOS COATING - RUTLAND PRODUCTS, RUTLAND, VT.  
 WATER REPELLENT - A. H. HARRIS & SONS, INC., HYDE PARK, MASS.  
 TAR EMULSION - TECH CHEMICAL CORP., CHESHIRE, CONN.  
 JOINT SEALER - DEWEY & ALMY CHEM. CO., W.R. GRACE CO., CAMBRIDGE, MASS.  
 REINFORCING STEEL, PREFORMED JOINT SEALER, & BRIDGE RAILING -  
 V.T. STRUCTURAL STEEL, BURLINGTON, VT.  
 PAINT WATERPROOFING - KIDBY EQUIPMENT CO., WHITE R. JCT., VT.  
 GREEN PAINT - MASTER BRONZE POWDER CO., CHICAGO, ILL.  
 GREY BRIDGE PAINT - RUST-OLEUM CORP., EVANSTON, ILL.  
 SEAMLESS COPPER WATER TUBE - SCOVILL MFG. CO., WATERBURY, VT.

**STATE OF VERMONT  
 DEPARTMENT OF HIGHWAYS**

**Proposed Improvement**

**TOWN OF BERKSHIRE  
 COUNTY OF FRANKLIN  
 VT. ROUTE 105  
 ENOSBURG FALLS-RICHFORD ROAD**

Pin# 00R 213


BEGINNING AT A POINT ON VT. ROUTE 105 IN THE VILLAGE OF EAST BERKSHIRE, 2.385 MILES SOUTHERLY OF THE BERKSHIRE-RICHFORD TOWN LINE AND EXTENDING NORTHERLY 2.365 MILES, INCLUDING BRIDGE.

LENGTH OF ROADWAY 12,440.46 FEET = 2.356 MILES  
 LENGTH OF BRIDGE 151.92 FEET = 0.029 MILES  
 LENGTH OF PROJECT 12,592.38 FEET = 2.385 MILES

ADT (1960)	500
ADT (1985)	1730
DIV (1985)	270
D	6 1/2%
T	7 1/2%
V	50 MPH

**CONTRACTOR-LAFERLE CONSTRUCTION CO. CONTRACT**  
 ST. JOHNSBURY, VT. DATED - DEC. 1, 1965  
 RES. ENGINEER - T. K. PIERCE BEGAN - APR. 18, 1966  
 RECORD PLANS BY R.W. COMPLETED - AUG. 13, 1967  
 ACCEPTED - AUG. 16, 1967

**SHEETS ADDED IN FINALS**  
 3 - Channel Sheets  
 3 - Gravel Computation Sheets  
 7 - Drainage Sheets

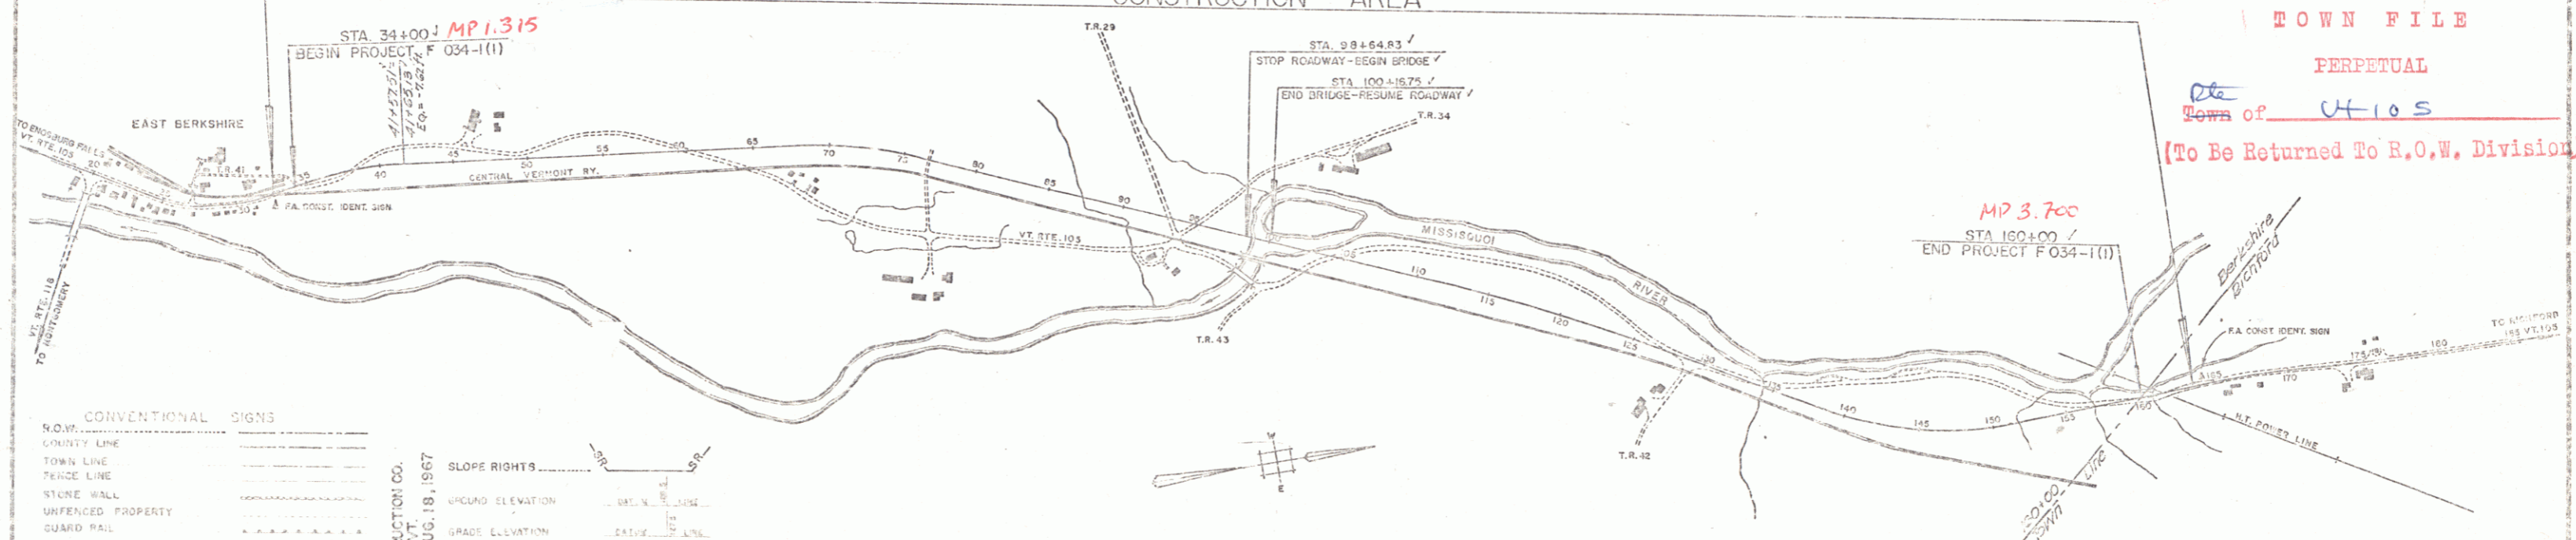

**RIGHT-OF-WAY DIVISION  
 TOWN FILE  
 PERPETUAL  
 Town of U-105  
 (To Be Returned To R.O.W. Division)**

**CONVENTIONAL SIGNS**

ROADWAY	---
COUNTY LINE	---
TOWN LINE	---
TENACE LINE	---
STONE WALL	---
UNFENCED PROPERTY	---
GUARD RAIL	---
TRAVELED WAY	---
RAILROAD	---
RETAINING WALL	---
CENTER LINE	---
SURVEY LINE	---
CULVERT	---
ONCP WARE	---
TROLLEY WIRE	---
POWER POLE	---
TELEPHONE POLE	---
TRUCKS	---
BRIDGE	---
FA. CO. IDENTIFICATION SIGNS	---

**SLOPE RIGHTS**

WARD ELEVATION	---
GRADE ELEVATION	---
CURVE DATA	---
REFLECTION OF ANGLE	---
DEGREE OF CURVE	---
RADIUS OF CURVE	---
POINT OF CURVE	---
POINT OF TANGENT	---
POINT OF INTERSECTION	---
POINT OF SIGHT	---
POINT OF TANGENT	---
POINT ON TANGENT	---
POINT ON SIGHT	---



THESE PLANS ARE SUBJECT TO SUCH REVISIONS AS MAY BE REQUIRED BY THE BUREAU OF PUBLIC ROADS ON THE COMMISSIONER OF HIGHWAYS.  
 CONSTRUCTION IS TO BE CARRIED ON IN ACCORDANCE WITH THESE PLANS AND THE STANDARD SPECIFICATIONS FOR HIGHWAY AND BRIDGE CONSTRUCTION LATEST EDITION AS APPROVED BY THE BOARD OF PUBLIC ROADS ON OCTOBER 12, 1954, INCLUDING ALL SUBSEQUENT APPROVED REVISIONS AND SUCH REVISED SPECIFICATIONS AND SPECIAL PROVISIONS AS ARE INCORPORATED IN THESE PLANS.

<i>[Signature]</i> DATE 3/17/68	<i>[Signature]</i> DATE 3/21/68	<i>[Signature]</i> DATE 3/22/68	<i>[Signature]</i> DATE 3/23/68	<i>[Signature]</i> DATE 3/24/68	<i>[Signature]</i> DATE 3/25/68	<i>[Signature]</i> DATE 3/26/68	<i>[Signature]</i> DATE 3/27/68	<i>[Signature]</i> DATE 3/28/68	<i>[Signature]</i> DATE 3/29/68	<i>[Signature]</i> DATE 3/30/68
------------------------------------	------------------------------------	------------------------------------	------------------------------------	------------------------------------	------------------------------------	------------------------------------	------------------------------------	------------------------------------	------------------------------------	------------------------------------

DEPARTMENT OF CONSUMERS  
 BUREAU OF PUBLIC ROADS

APPROVED

DIVISION

PROJECT F-66-034-1(1)

DATE 3/29/68

SCALE BY INSPECTOR DATE 3/29/68