


PLAN	DATE	BY
REVISED		
NO. 1		
NO. 2		
NO. 3		
NO. 4		
NO. 5		

REV. CURVE DATA  
 $\Delta$  39° 31' 00" Lt.  
D 4' 15"  
T 1348.14'  
L 929.87'  
E 84.30'  
2FL 38.09'  
Ent 2.8' per ft.

CONSTRUCT DRIVE  
32+45 Lt. /  
34+00 Lt. /

THREE CABLE GUARD RAIL  
W/ STEEL POSTS, ITEM 542  
32+00-34+48 Lt.  
31+15.5 - 32+54.7 Rt.

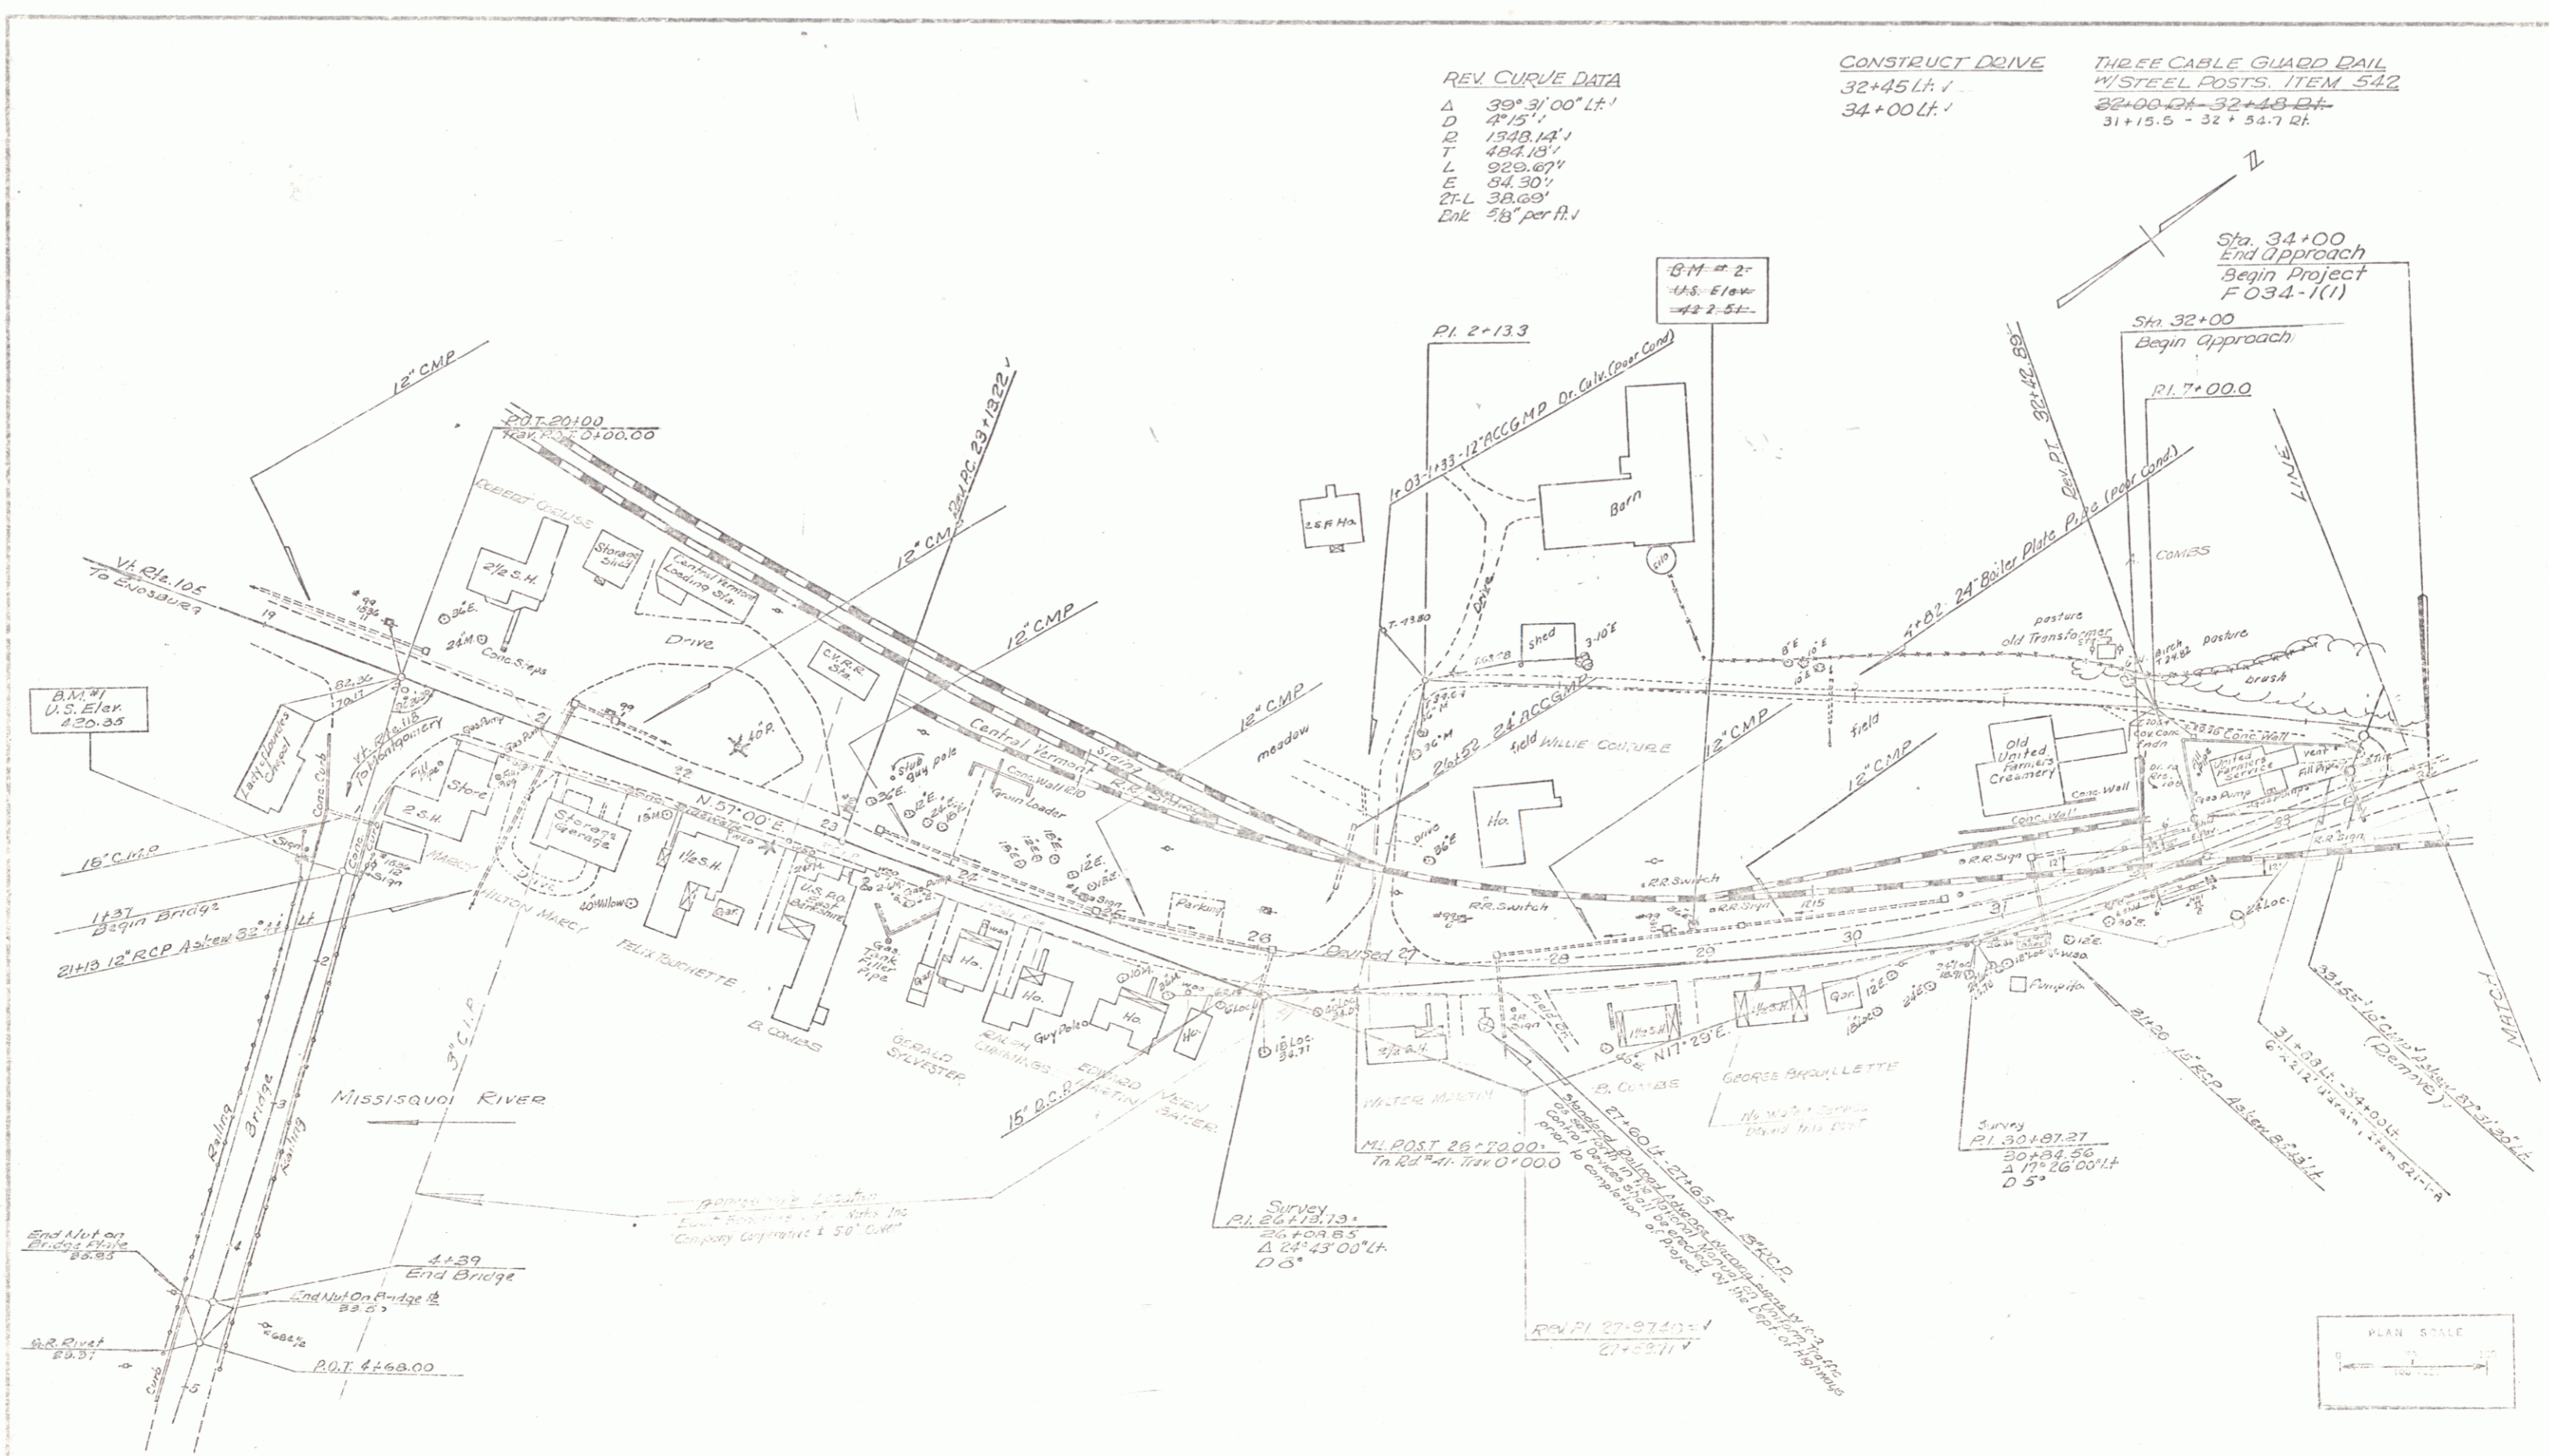

BECKSHIRE  
F-EG-03A-1(1)  
Sheet 12 of 132 Sheets