


PLAN	DESIGNED	BY	DATE
	BY		
	CHECKED		
	DATE		
	BY		
	CHECKED		
	DATE		



CURVE DATA
 Δ 16° 18' 30" RT
 D 21.7
 R 286.479
 T 410.48
 L 215.41
 E 29.26
 Bnk 116' 41"

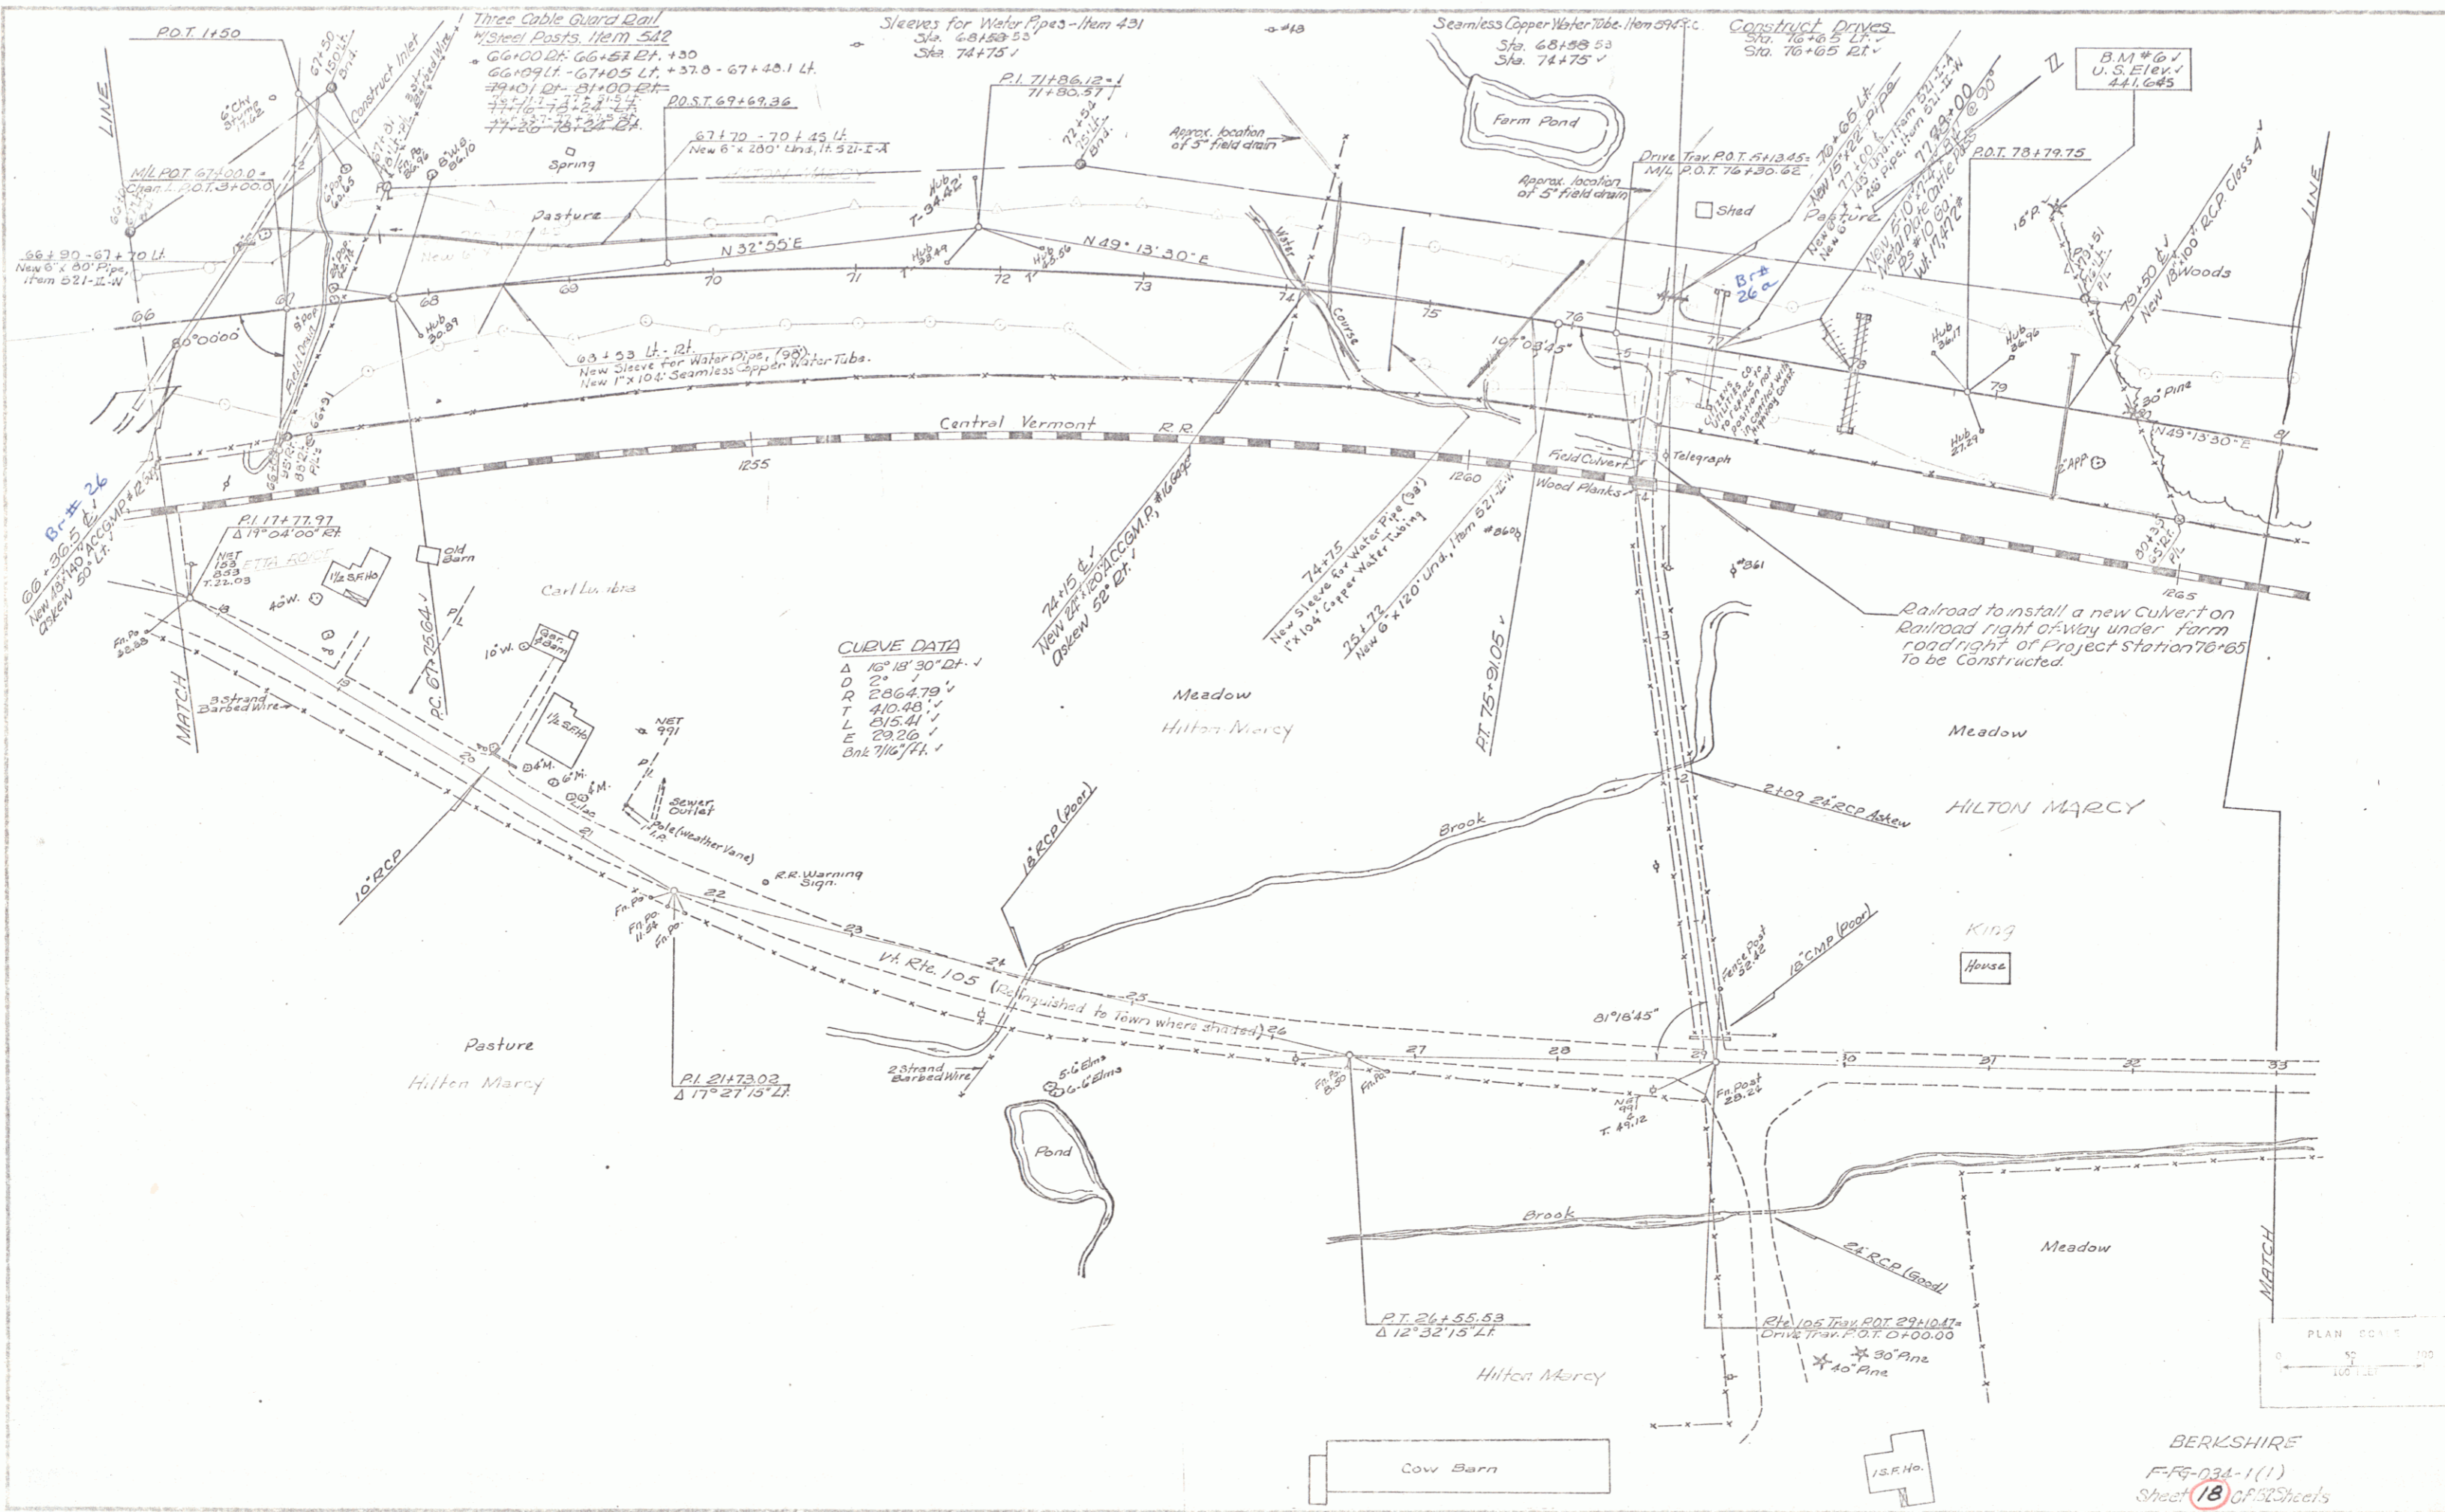

BERKSHIRE
 F-85-034-1(1)
 Sheet 18 of 22 Sheets