


Excavation & Removal of Road Surfaces and/or Pavements Item 119
113+00 Lt. - 125+45 Lt.

Construct Drive
121+00 Lt.



DEV CURVE DATA
 Δ 7° 03' 00" Rt.
 D 0° 30'
 R 11459.16'
 T 732.64' 727.66'
 L 1403.18' 1453.33'
 E 23.38'
 Chk D.C. ✓

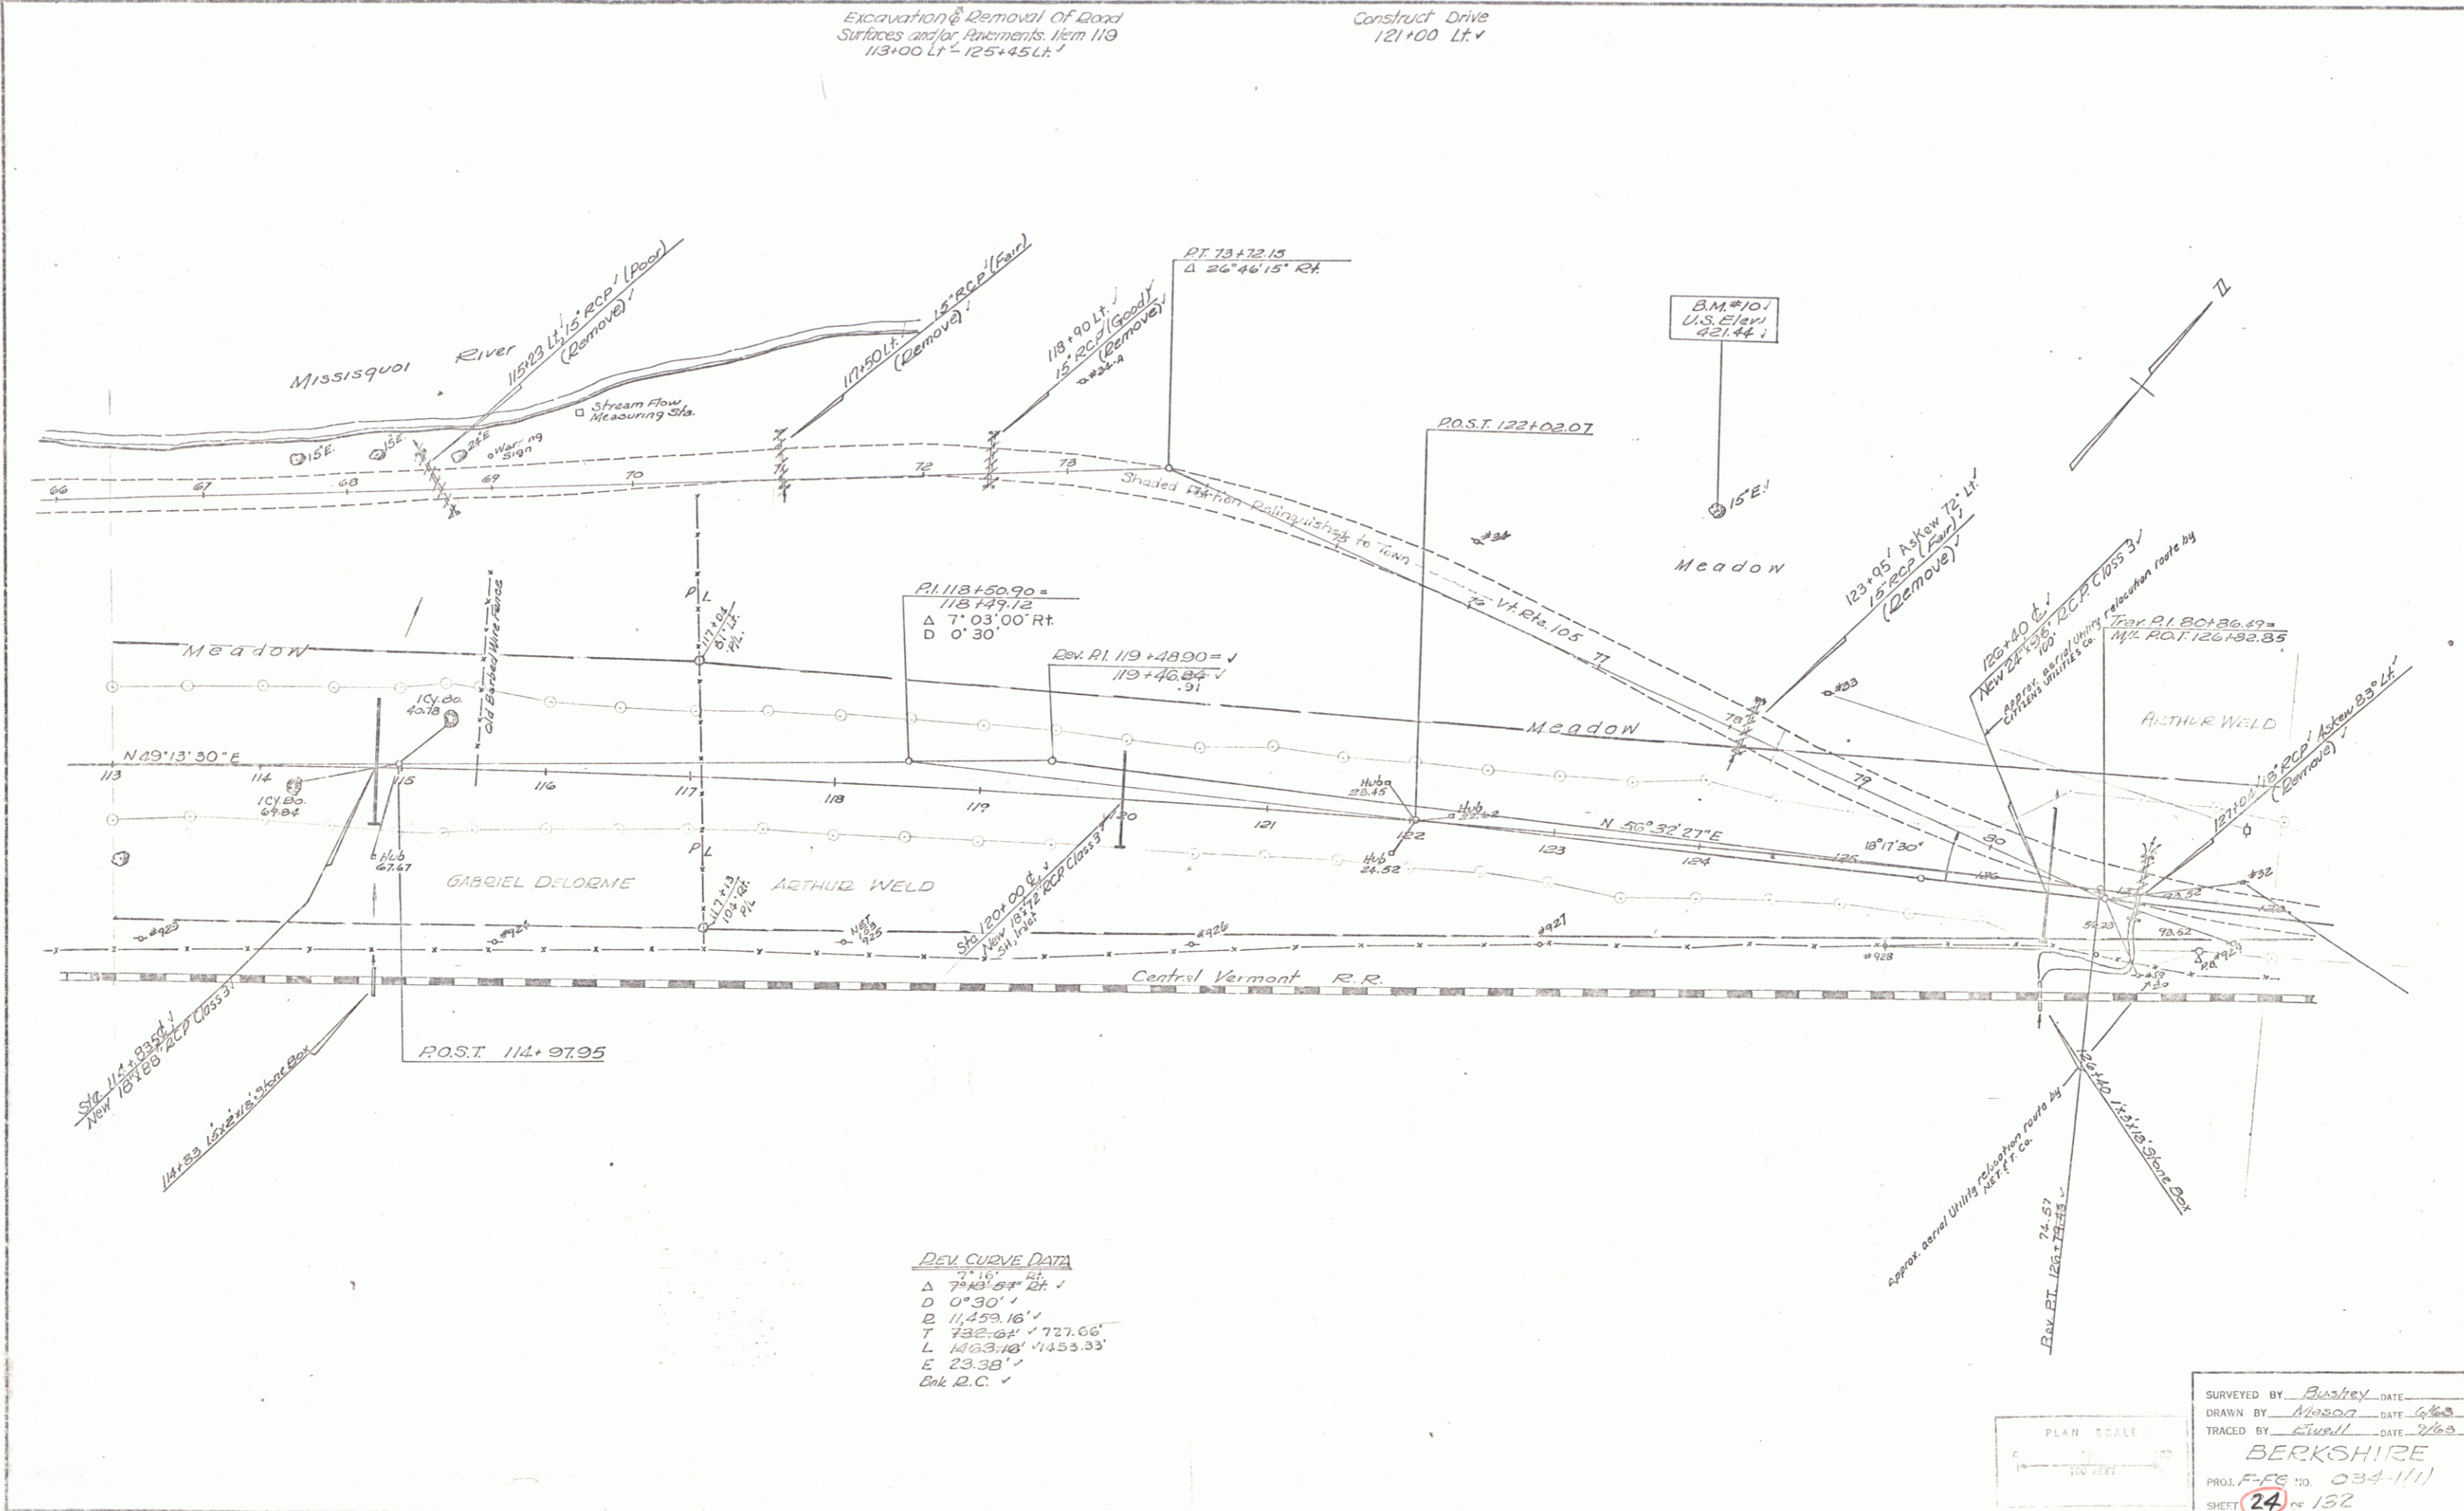

SURVEYED BY Bustey DATE 11/20/07
 DRAWN BY Stowell DATE 1/26/08
 TRACED BY Stowell DATE 1/26/08
BERKSHIRE
 PROJ. F-ES NO. 034-1(1)
 SHEET **24** of 152