
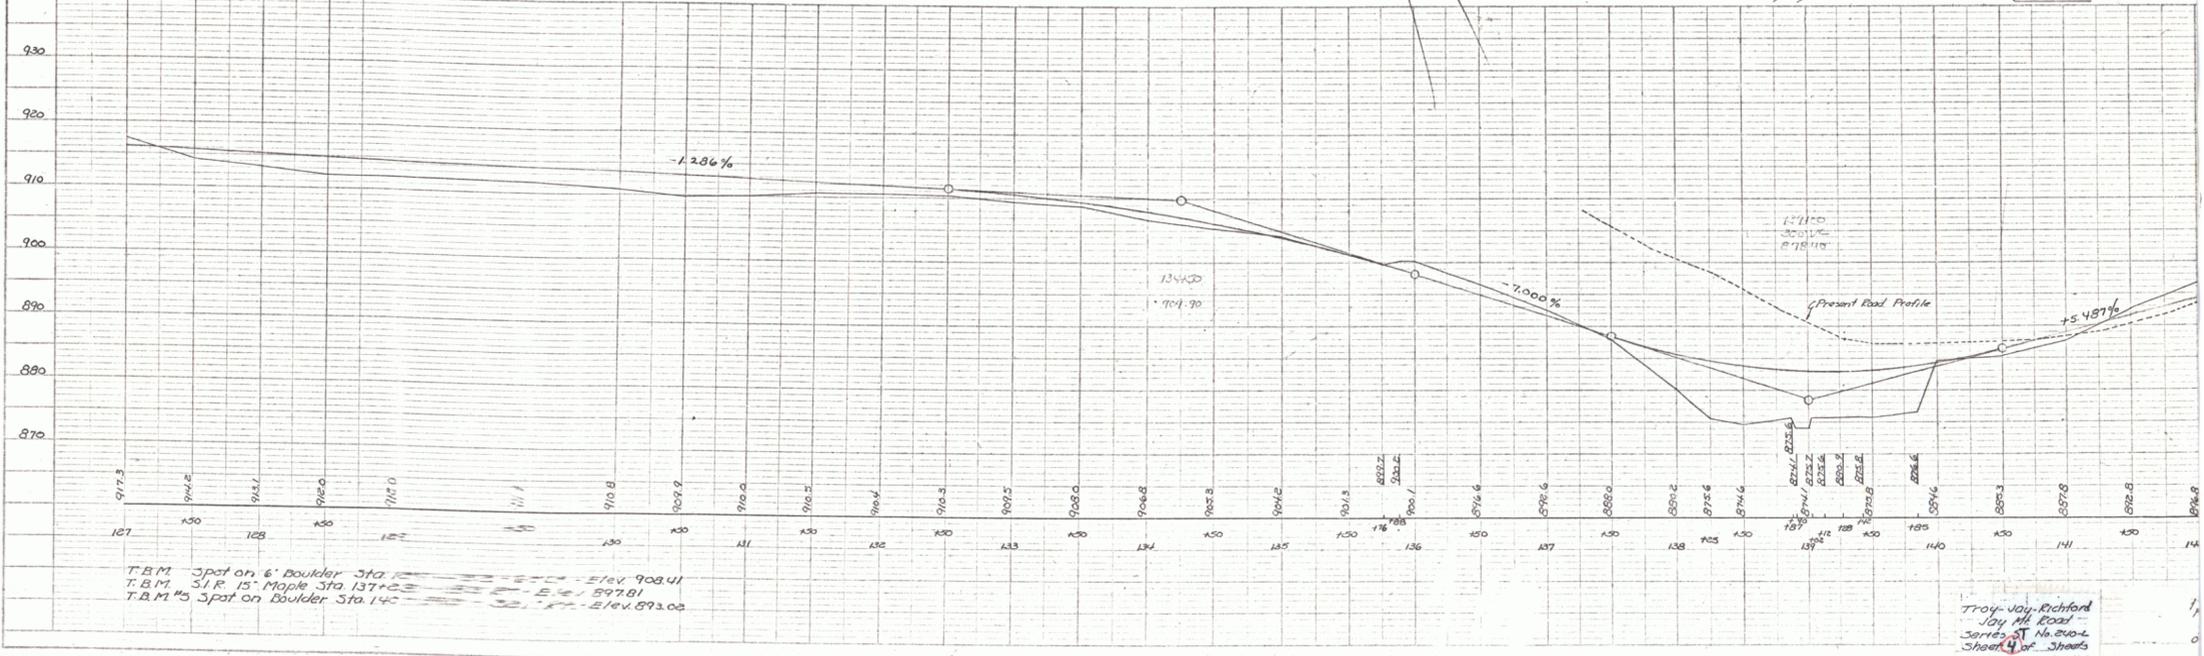


PLAN
 DATE: 5/17/05
 DRAWN BY: C.M. Lane
 CHECKED BY: C.M. Lane
 PROJECT: FA O'Neil
 NO. 100

PROFILE
 DATE: 5/17/05
 DRAWN BY: C.M. Lane
 CHECKED BY: C.M. Lane
 PROJECT: FA O'Neil
 NO. 100

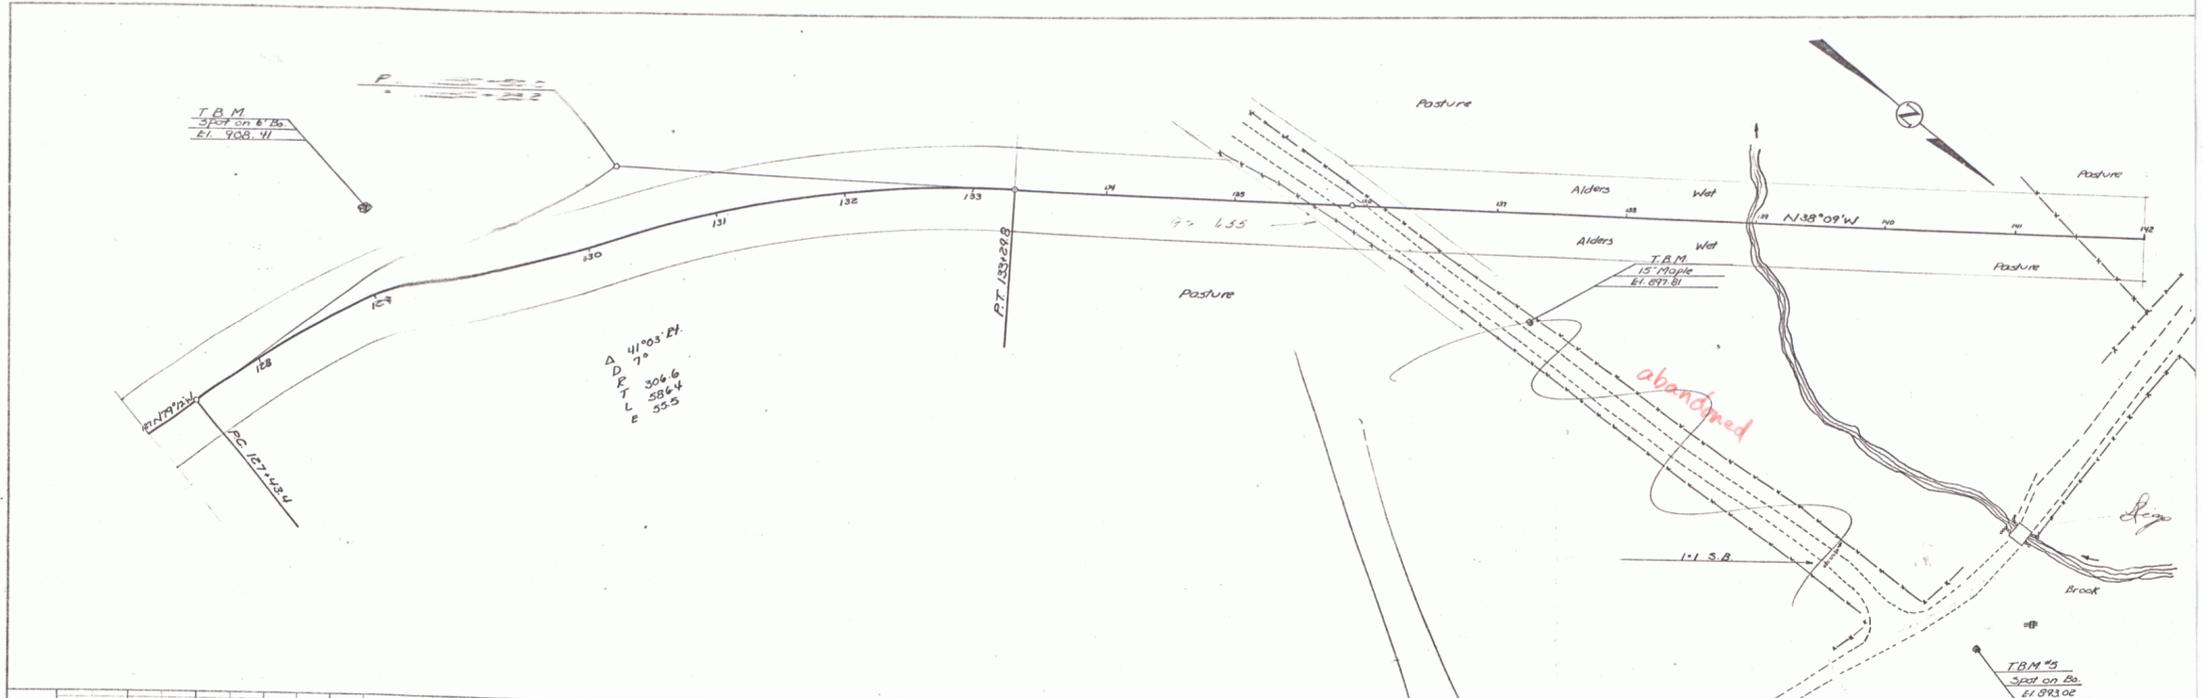

T.B.M. Spot on 6" Boulder Sta. 127 - Elev. 908.41
 T.B.M. 15" Maple Sta. 137 - Elev. 897.81
 T.B.M. 15" Spot on Boulder Sta. 140 - Elev. 893.02

Troy - Jay - Richard
 Jay Rd Road
 Series ST No. 2000
 Sheet 1 of 3 sheets