


PLAN  
 G. M. Lane, Civil Engr.  
 No. 11-28-88  
 F.A.O. Merrill  
 11-28-88

G. M. Lane, Civil Engr.  
 No. 11-28-88  
 F.A.O. Merrill  
 11-28-88

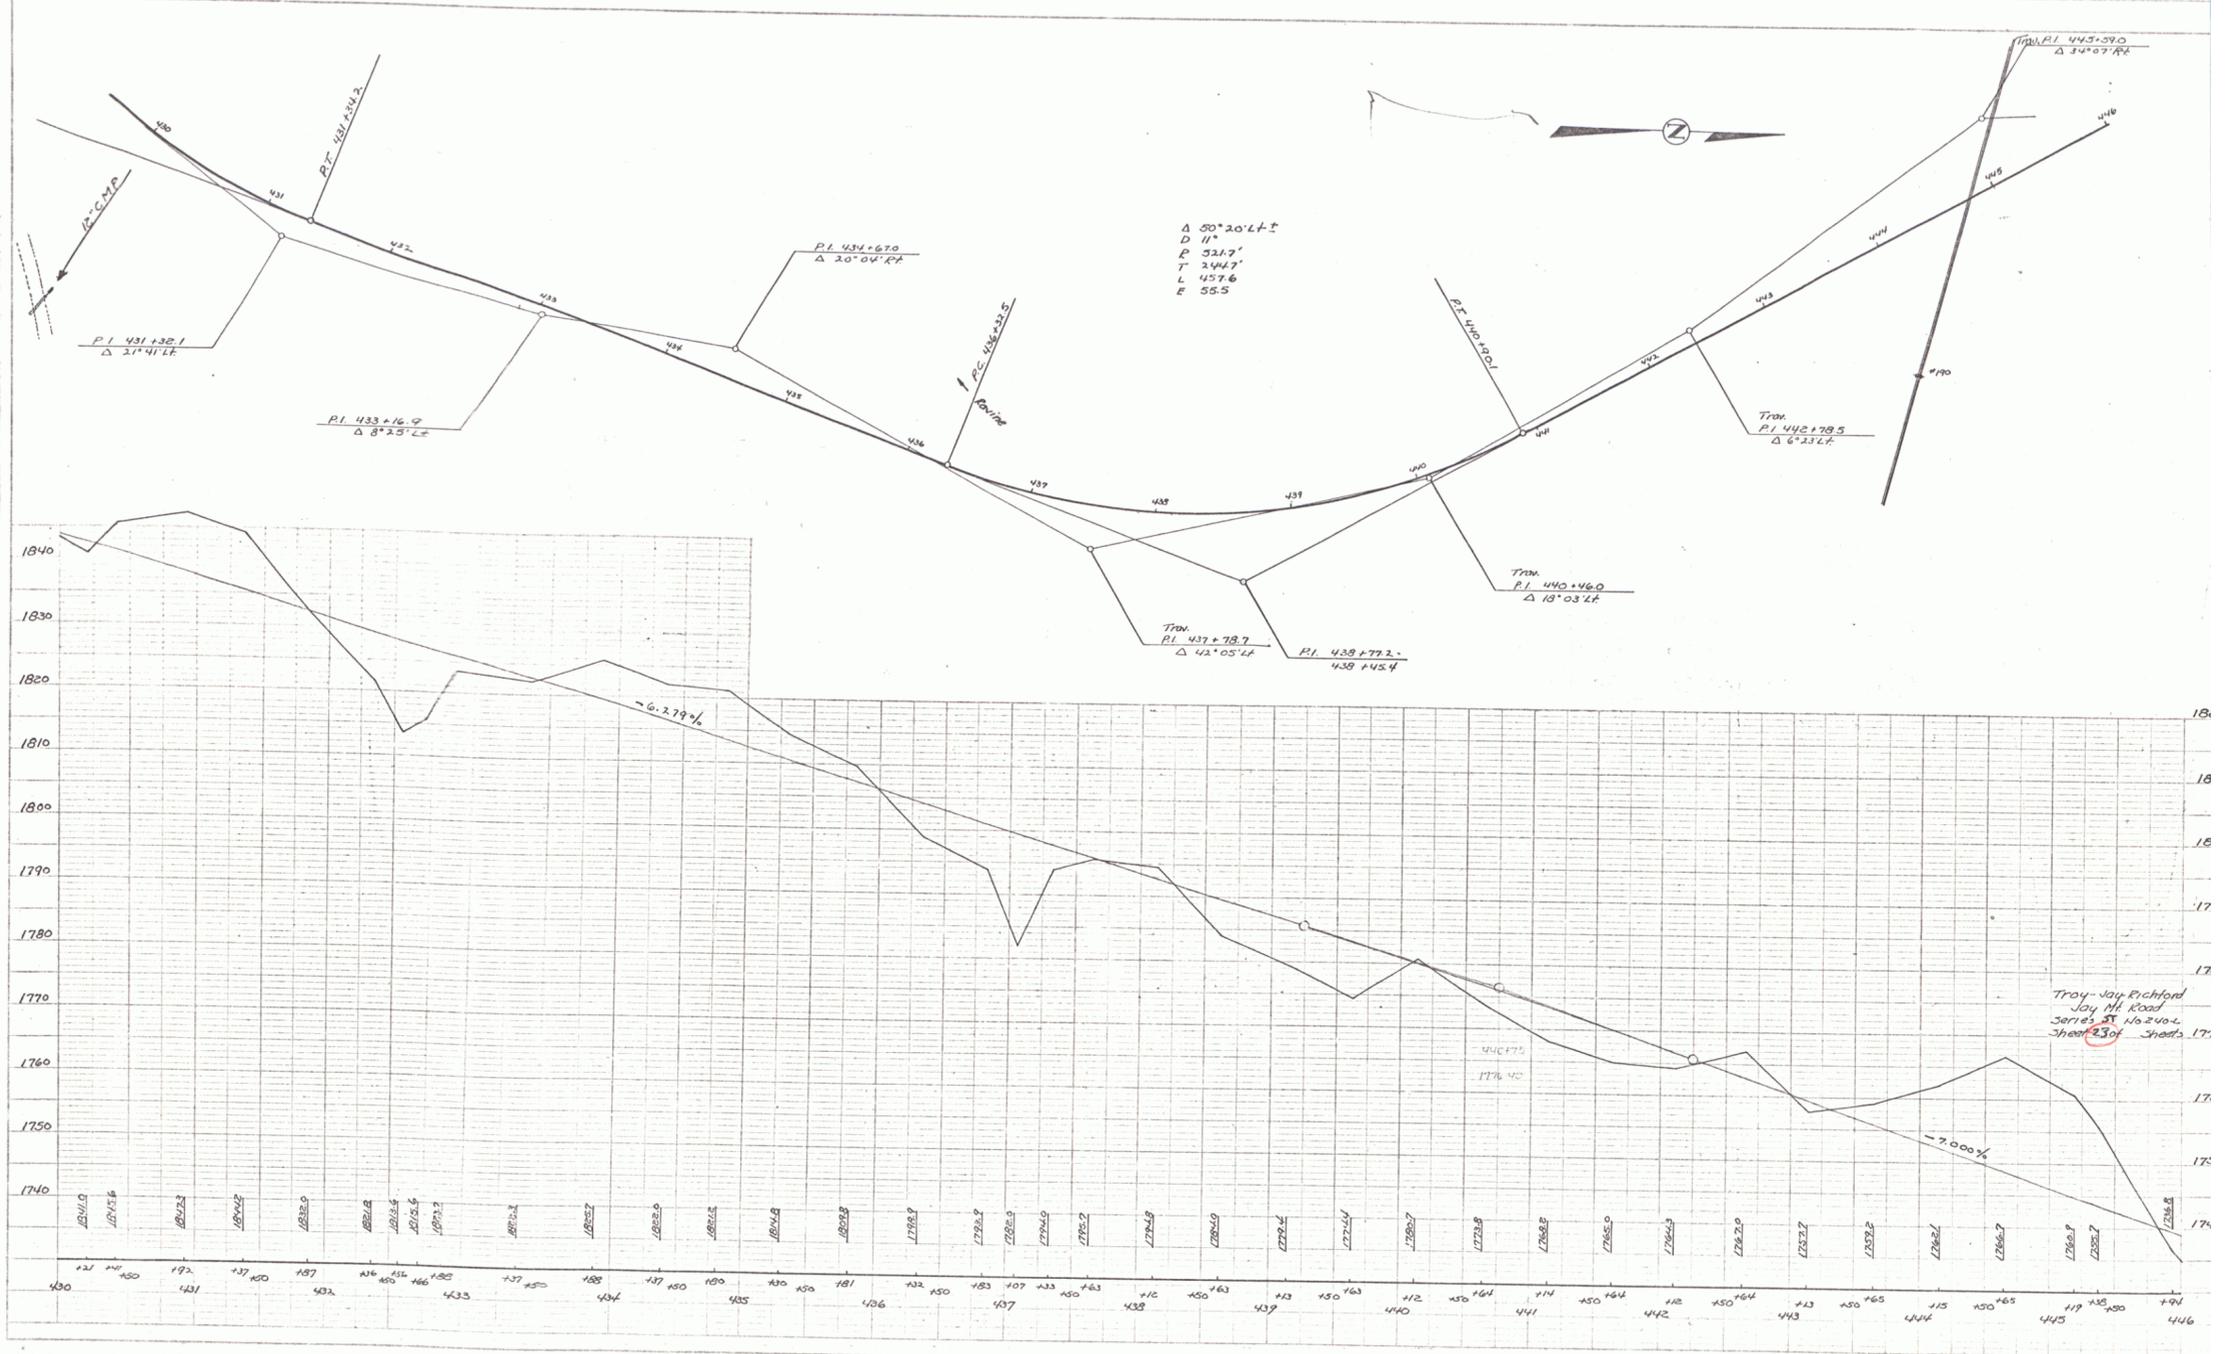

Troy - Jay Richford  
 Jay Hill Road  
 Series 51 No 2404  
 Sheet 23 of Sheets 17