



PLAN
 DATE: 10/1/58
 DRAWN BY: G.M. Lane
 CHECKED BY: R.A. O'Neill
 TITLE: Twp. Jay

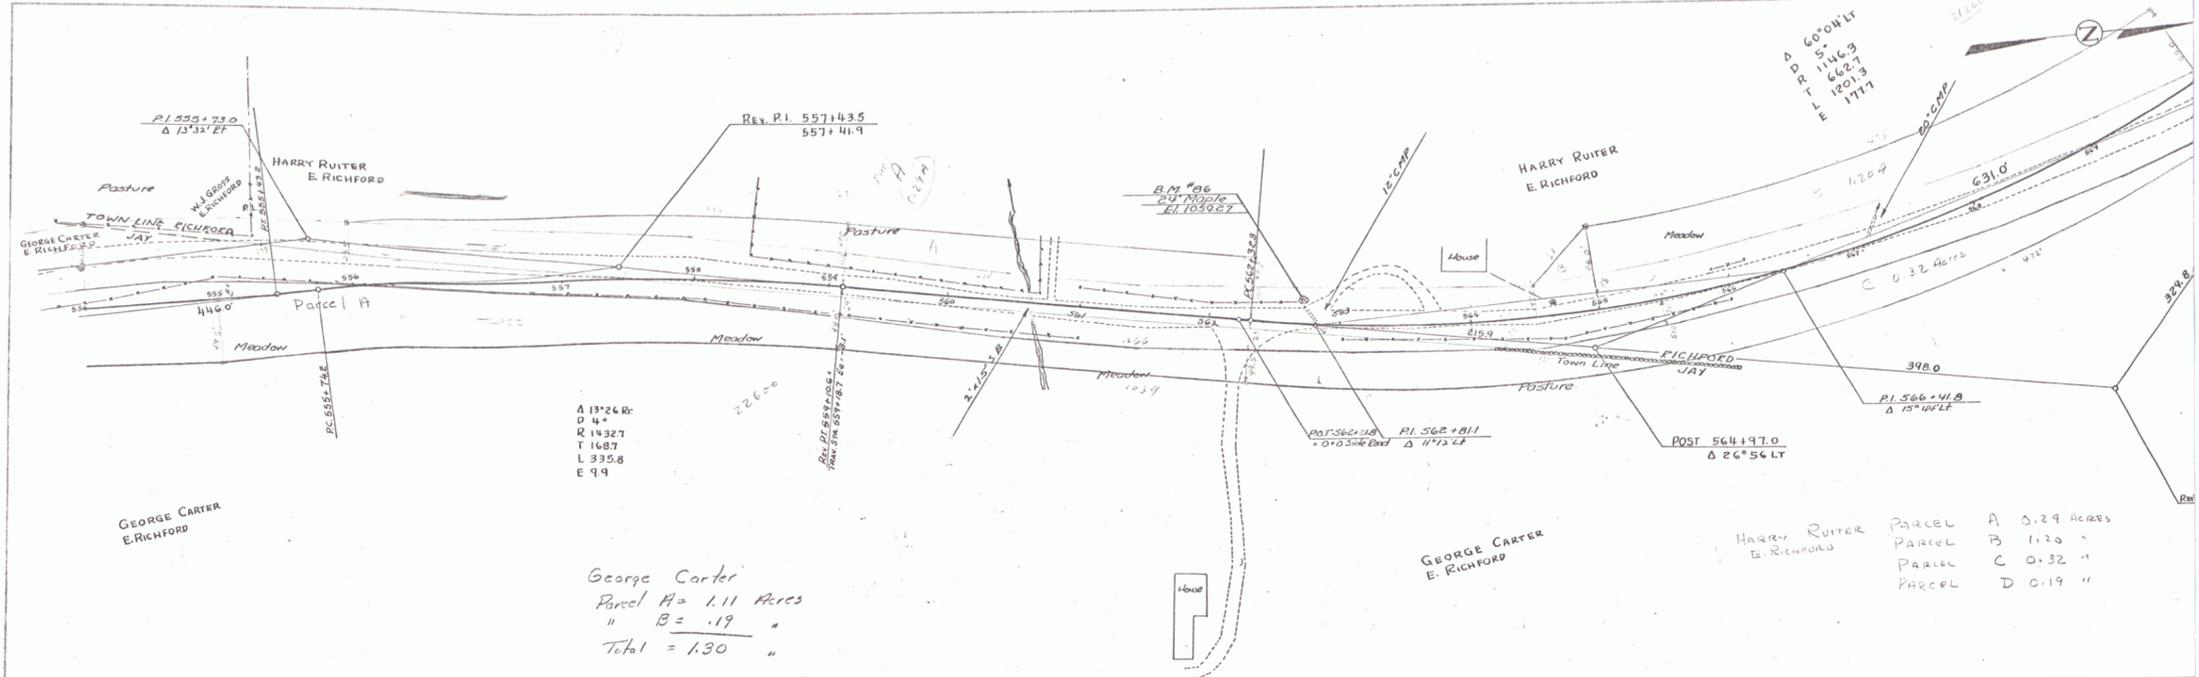

George Carter
 Parcel A = 1.11 Acres
 " B = .19 "
 Total = 1.30 "

HARRY RUTER E. RICHFORD
 PARCEL A 0.29 ACRES
 PARCEL B 1.20 "
 PARCEL C 0.32 "
 PARCEL D 0.19 "

PROFILE
 DATE: 10/1/58
 DRAWN BY: G.M. Lane
 CHECKED BY: R.A. O'Neill
 TITLE: Twp. Jay

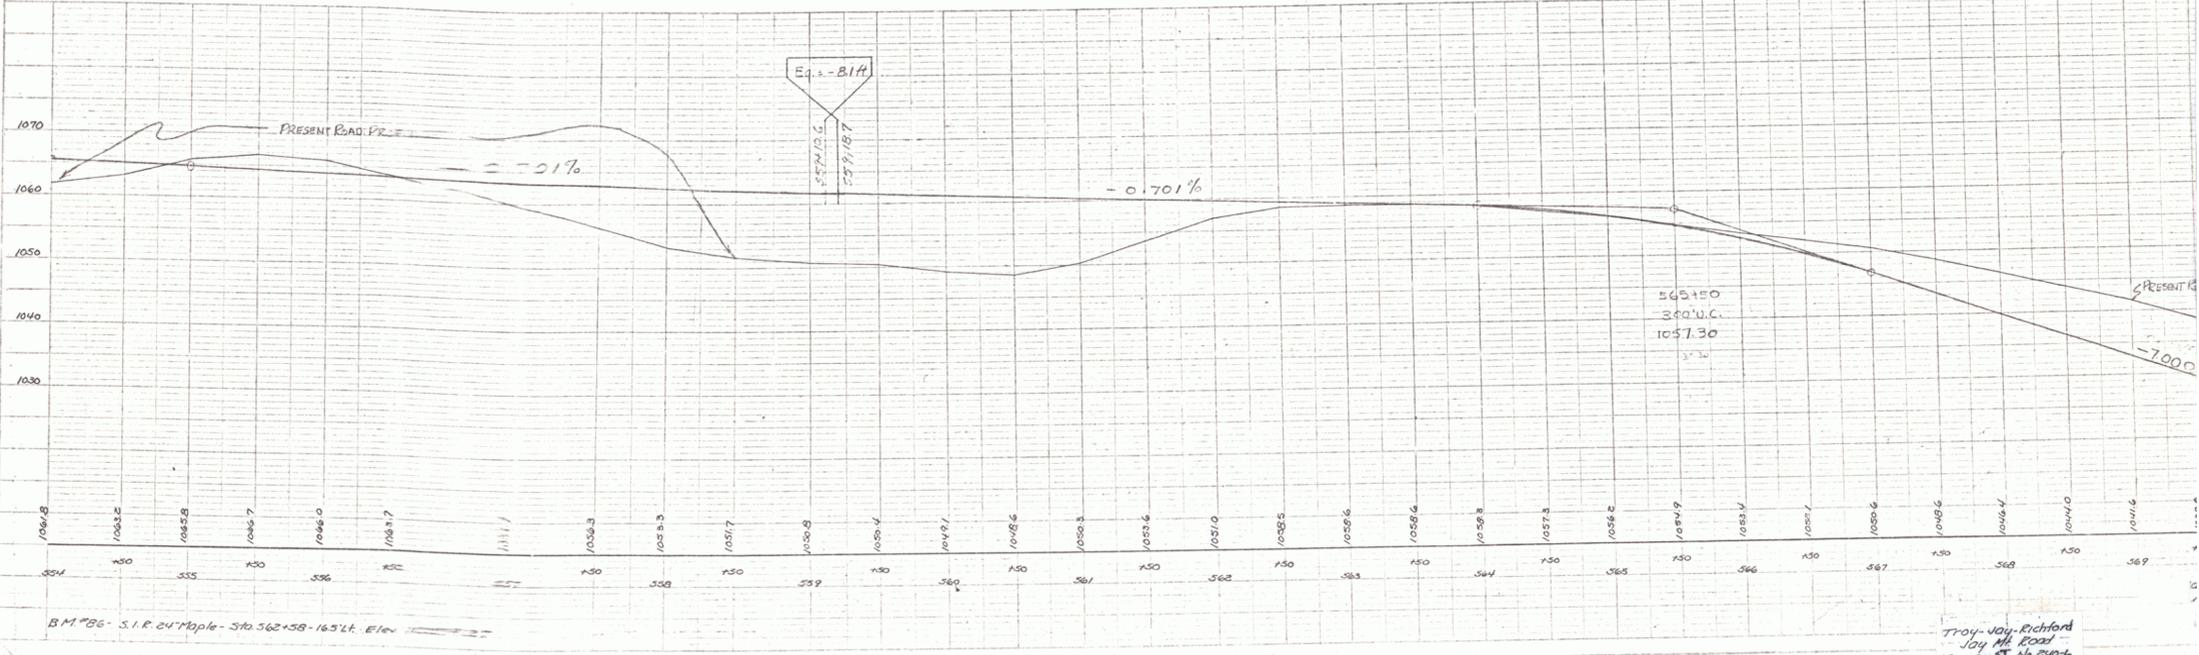

Twp. Jay, Richford
 Jay Hill Road
 Series No. 240-L
 Sheet 33 of 34