



PLAN  
 SHEET NO. 1-56  
 PROJECT  
 TRAILWAY

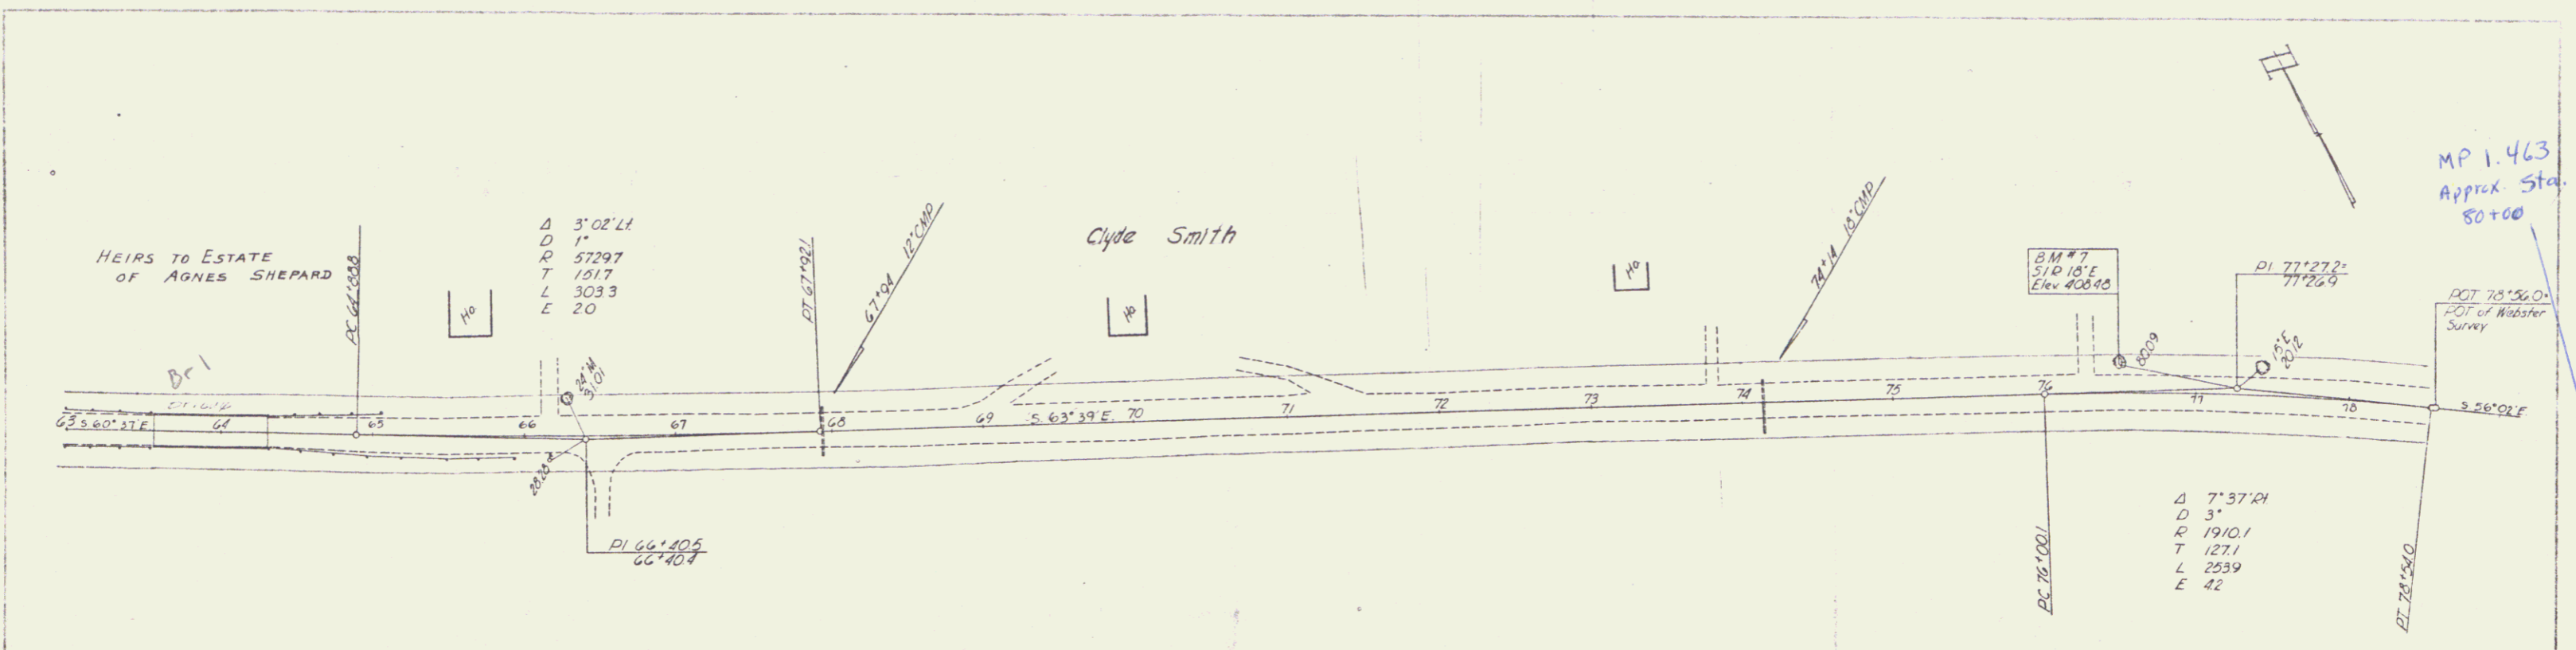

PROFILE  
 SHEET NO. 1-56  
 PROJECT  
 TRAILWAY

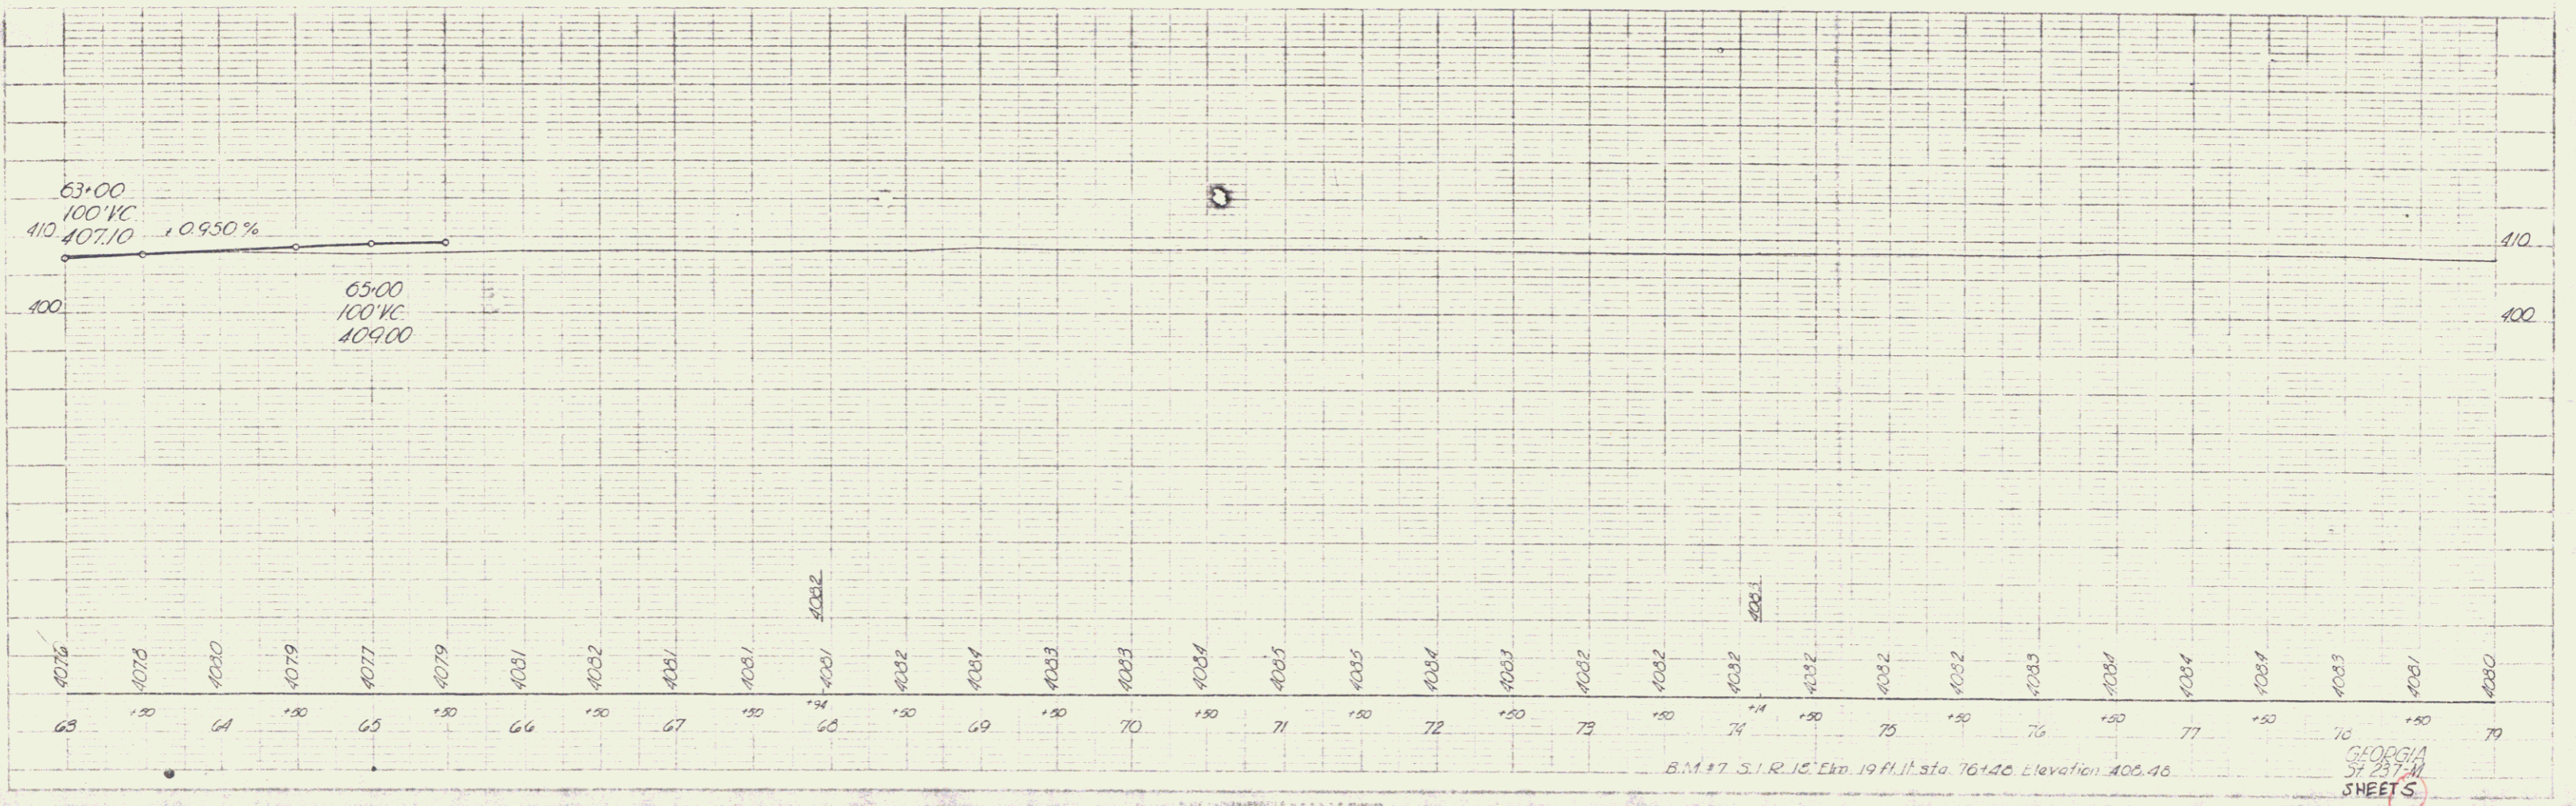

B.M. #7 S.1.R.10 Ebn. 19 Pl. sta. 76+40 Elevation 400.46

GEORGIA  
 SURVEYING  
 SHEETS