


CHAS. T. MAIN, INC.
 REGISTERED-MARTIN INC. 11-26
 11-26
 11-26

CHAS. T. MAIN, INC.
 REGISTERED-MARTIN INC. 11-26
 11-26
 11-26

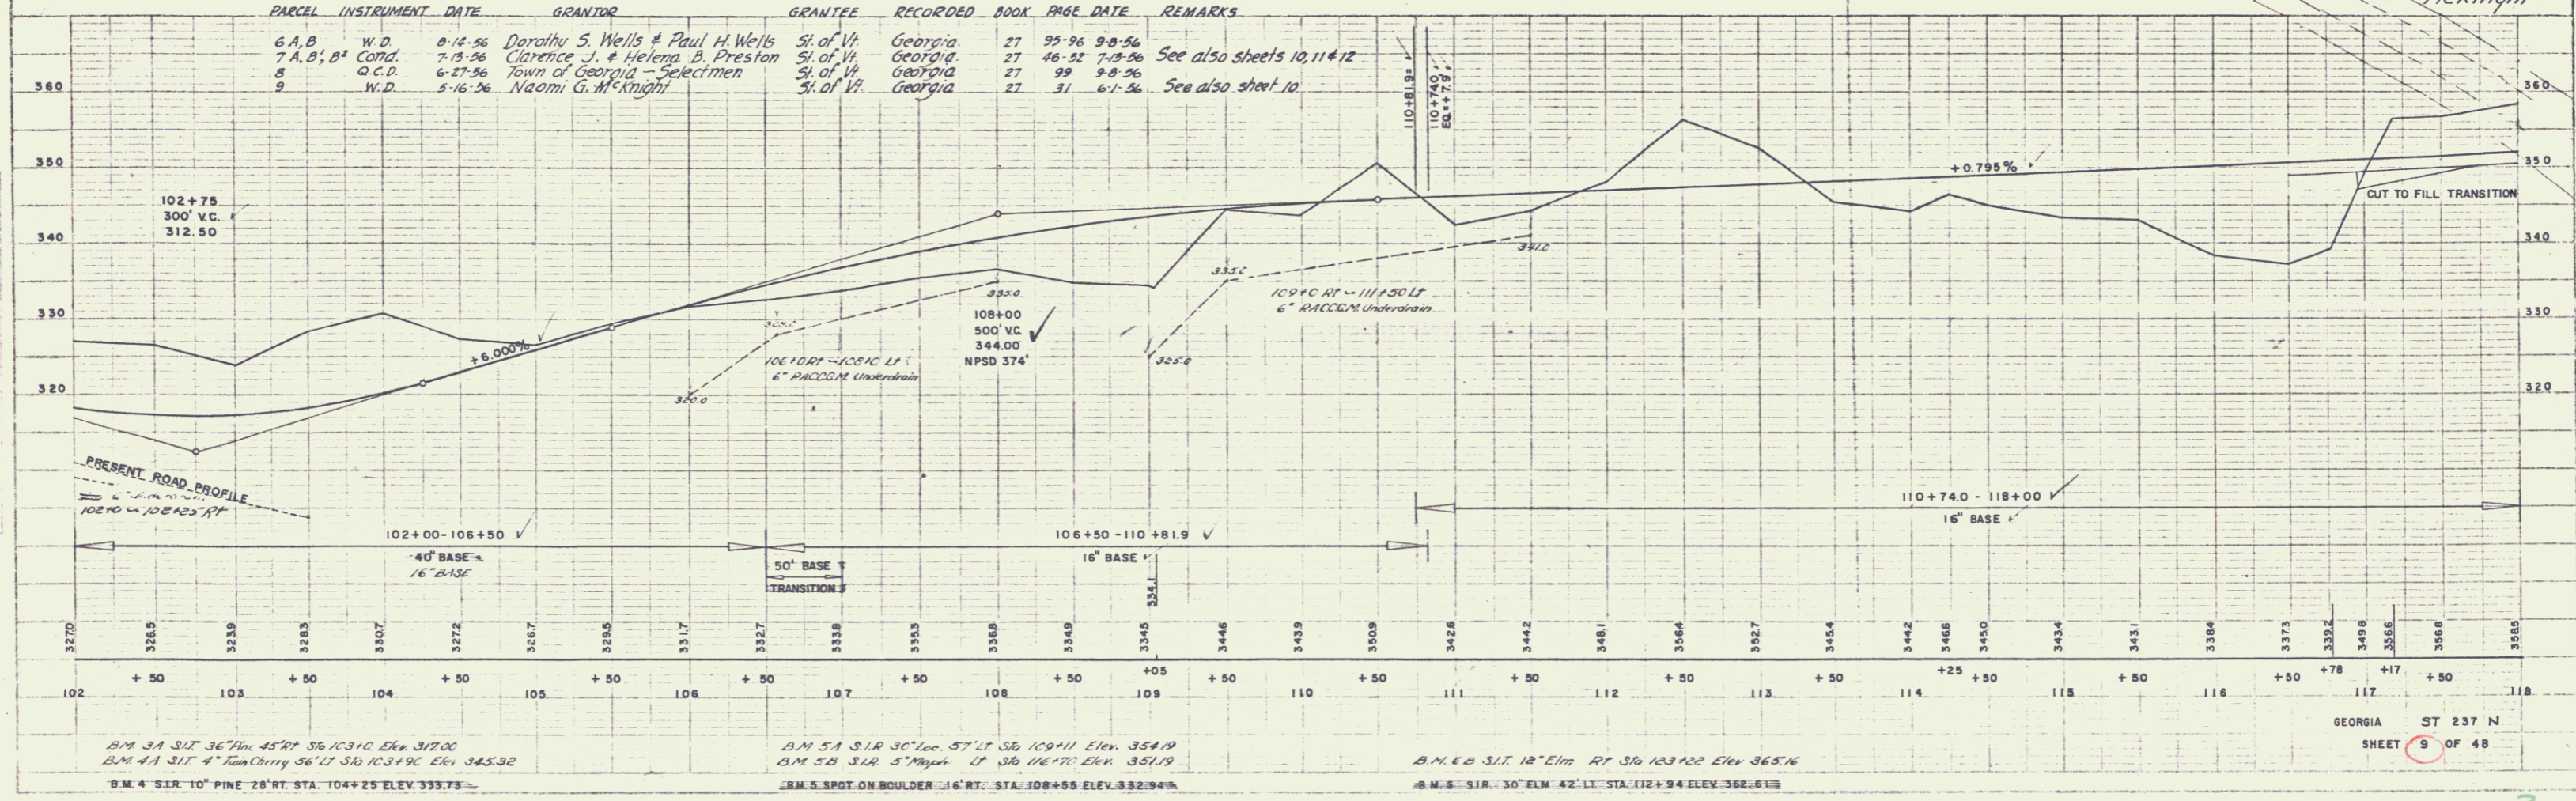

B.M. 3A S.I.T. 36" PINE 45' RT. STA. 103+90 ELEV. 337.00
 B.M. 4A S.I.T. 4" Iron Cherry 36" LI. S.D. 103+90 ELEV. 343.32
 B.M. 5A S.I.R. 30" LUM. 57" LI. S.D. 104+11 ELEV. 354.19
 B.M. 5B S.I.R. 5" Maple LI. S.D. 106+17 ELEV. 351.19
 B.M. 6B S.I.T. 12" Elm RT. STA. 103+122 ELEV. 365.16
 B.M. 5 S.I.R. 30" ELM. 42" LI. STA. 112+94 ELEV. 368.615
 B.M. 5 SPOT ON BOULDER 16" RT. STA. 108+55 ELEV. 332.94

3