
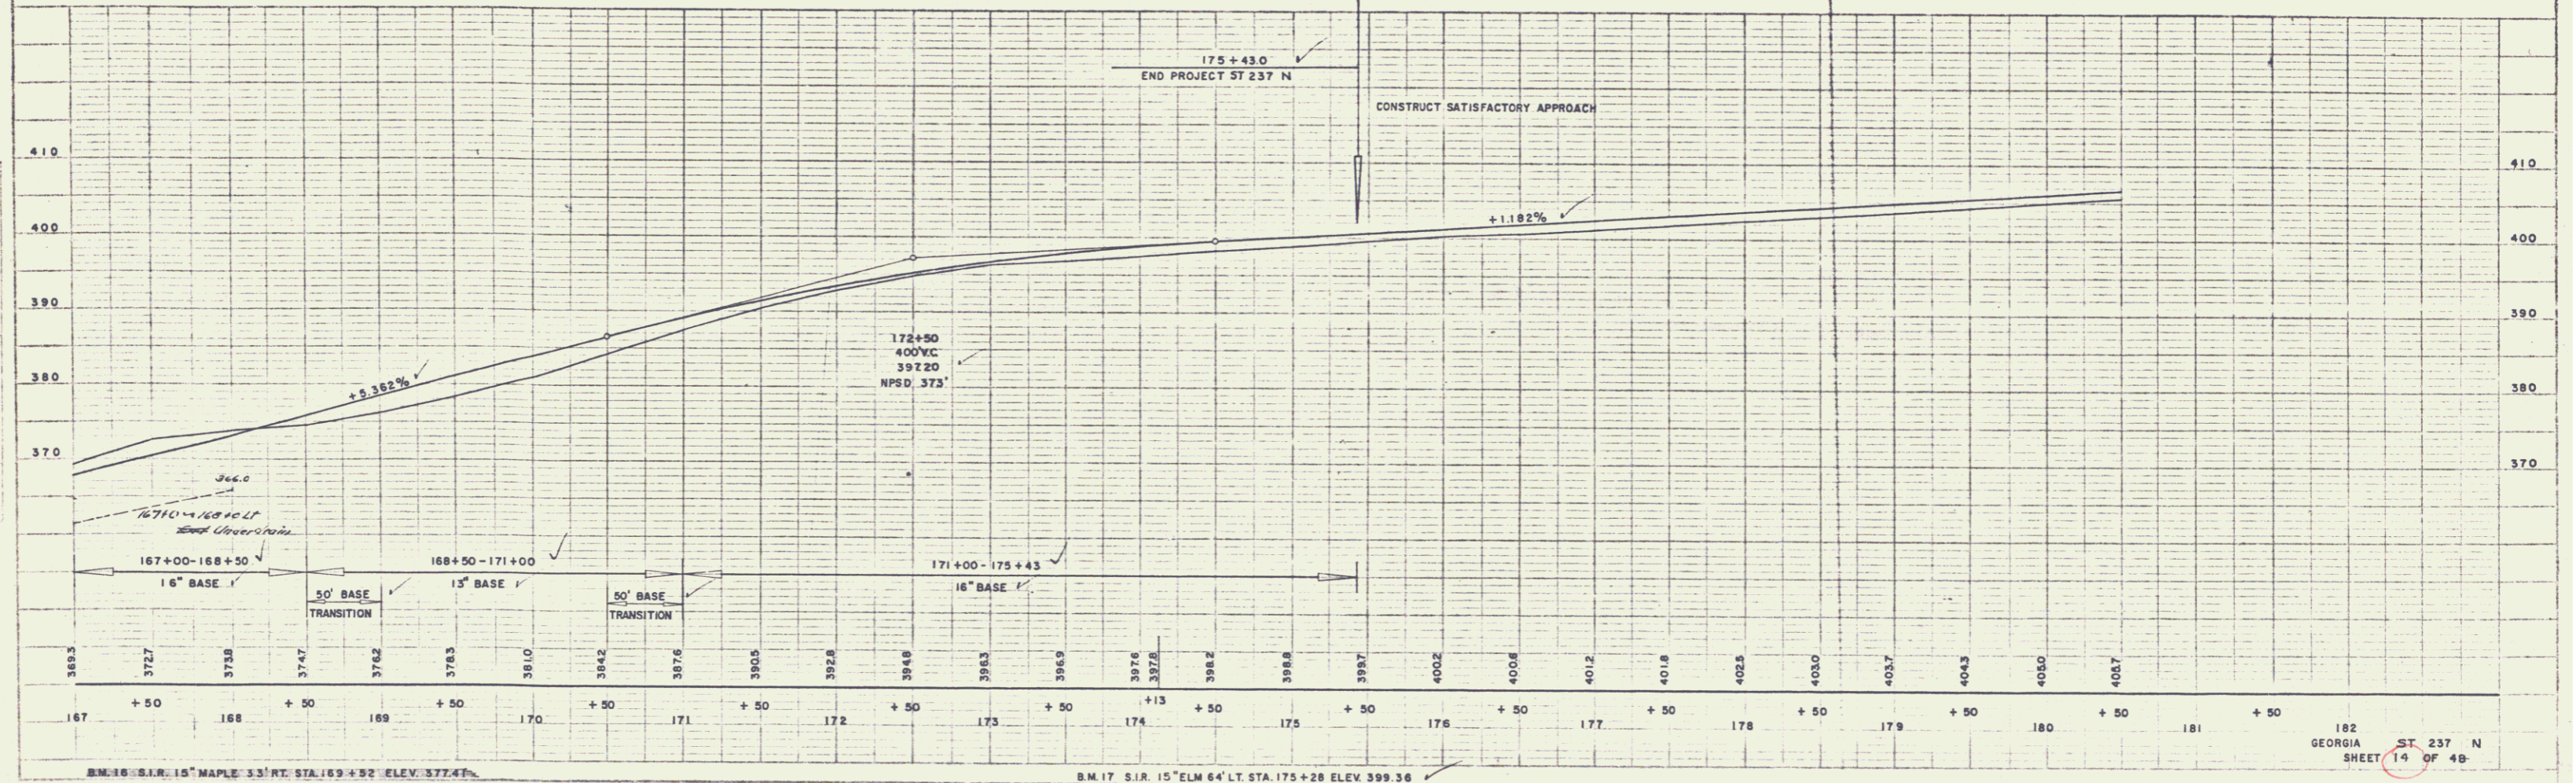


STILL OUM. 10373  
160112-160184.11 - 4  
160126-160181.11 - 4

PLAN  
NOTE BOOK  
WESTER-MARTIN INC.  
11-88  
11-88  
WESTER-MARTIN INC.  
11-88  
11-88

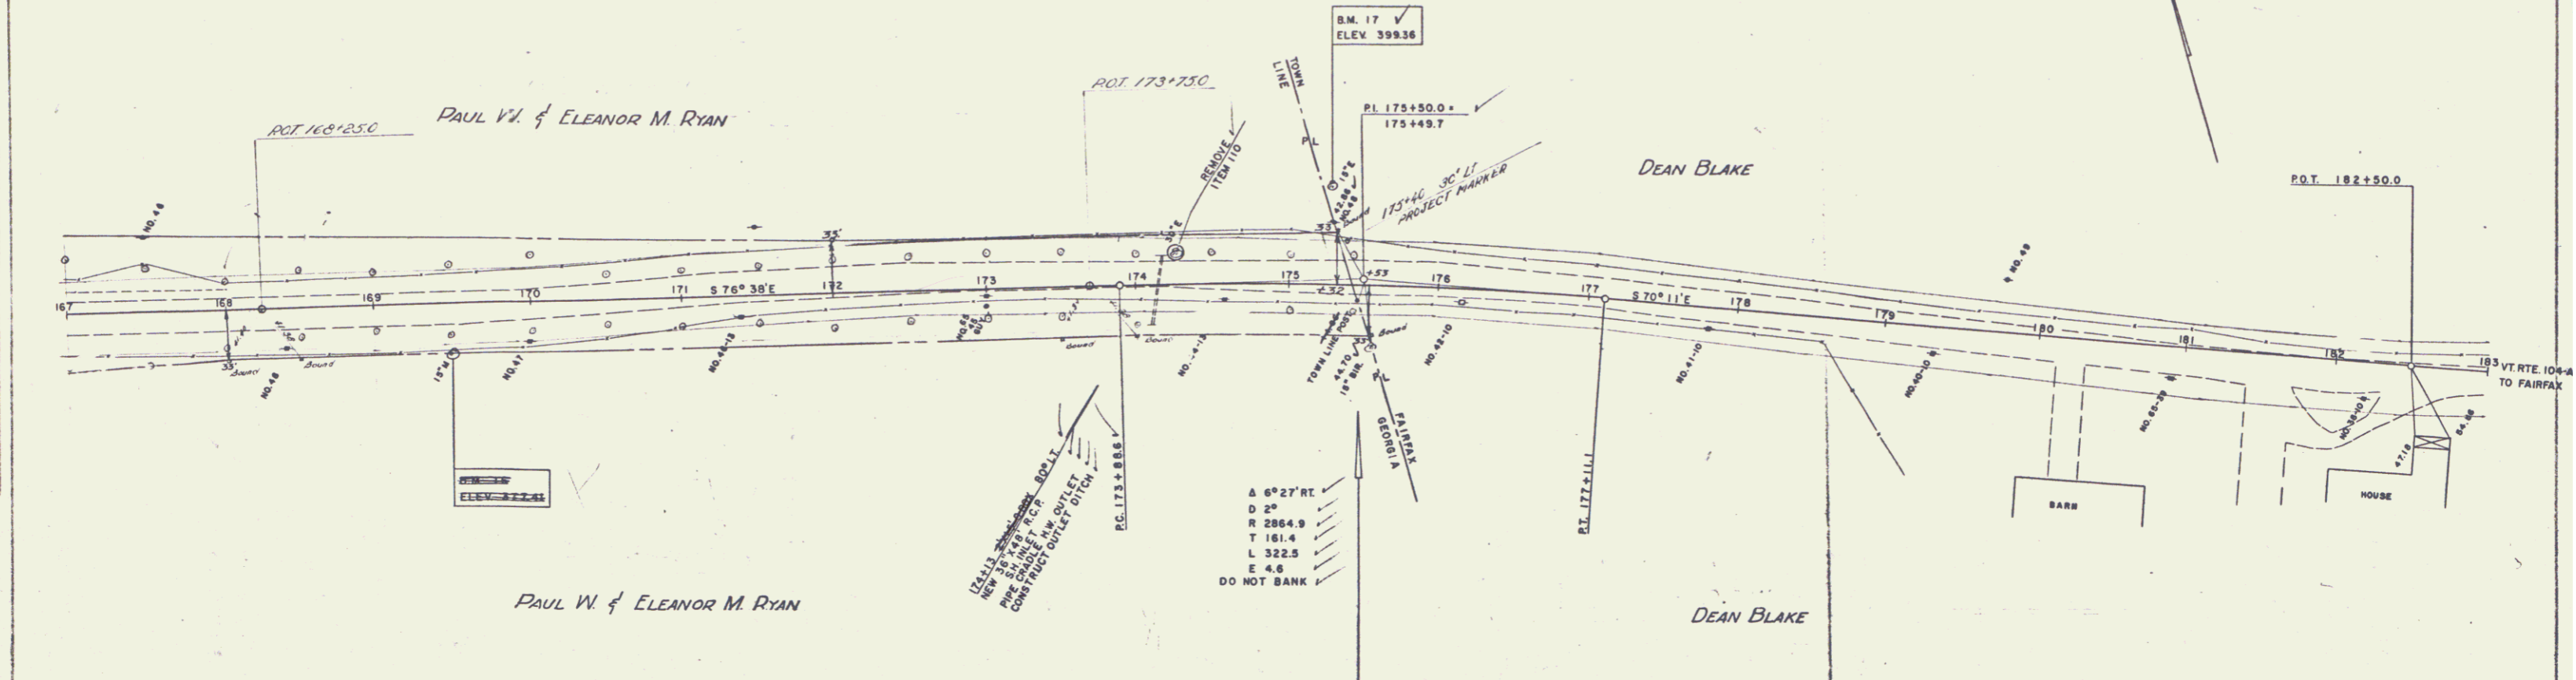

11-88  
WESTER-MARTIN INC.  
11-88  
WESTER-MARTIN INC.  
11-88  
11-88

B.M. 16 S.I.R. 15' MAPLE 33' RT. STA. 169+52 ELEV. 377.47

B.M. 17 S.I.R. 15' ELM 64' LT. STA. 175+28 ELEV. 399.36

182  
GEORGIA  
ST 237 N  
SHEET 14 OF 48

8