



PLAN
SCALE: 1" = 40'
DATE: 7/25/56
DRAWN BY: J. P. H. / T. P. H.

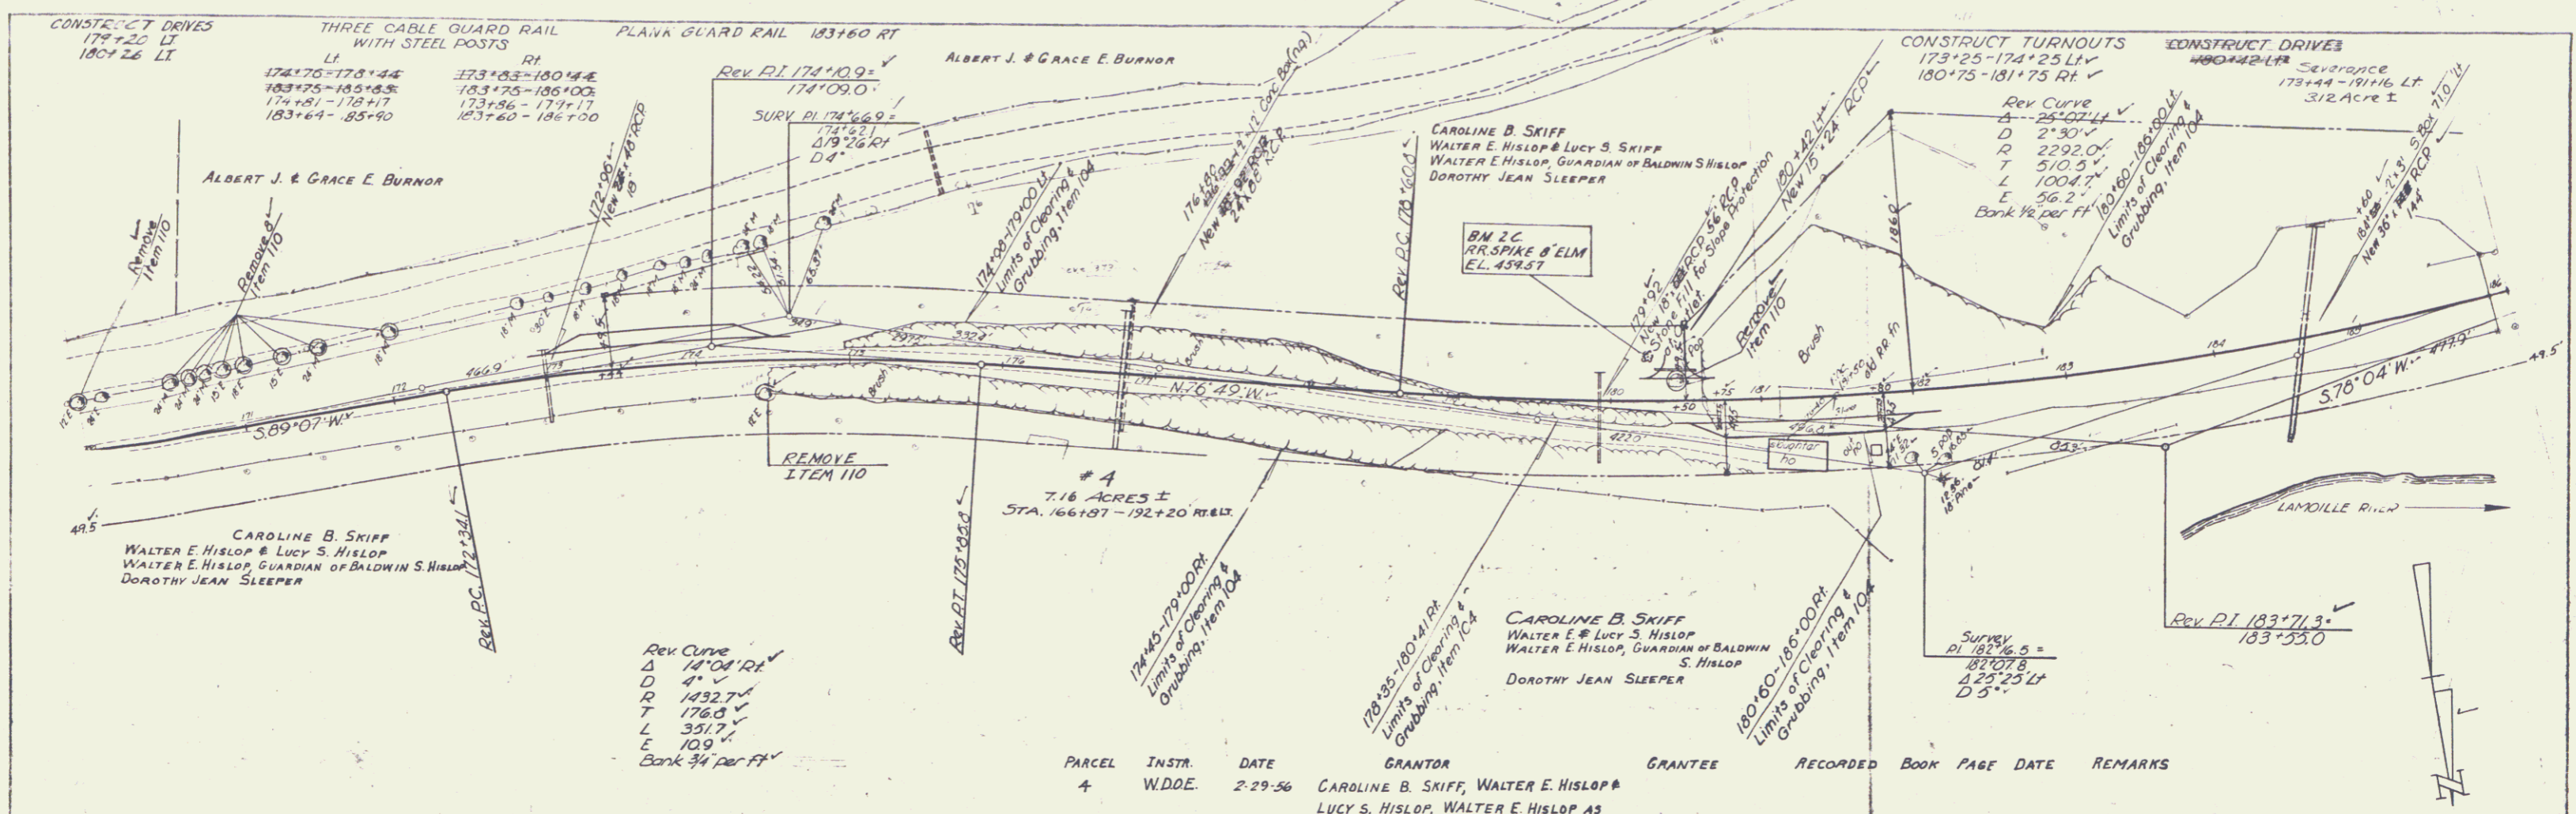

Rev Curve
 Δ 14° 04' RA
 D 4' ✓
 R 1432.7 ✓
 T 176.5 ✓
 L 351.7 ✓
 E 10.9 ✓
 Bank 34 per FT

PARCEL	INSTR.	DATE	GRANTOR	GRANTEE	RECORDED	BOOK	PAGE	DATE	REMARKS
4	W.D.E.	2-29-56	CAROLINE B. SKIFF, WALTER E. HISLOP LUCY S. HISLOP, WALTER E. HISLOP AS GUARDIAN OF BALWIN S. HISLOP, DOROTHY JEAN SLEEPER	ST. OF VI	CAMBRIDGE	42	355-556	3-15-56	SEE ALSO SHEETS 20 & 22

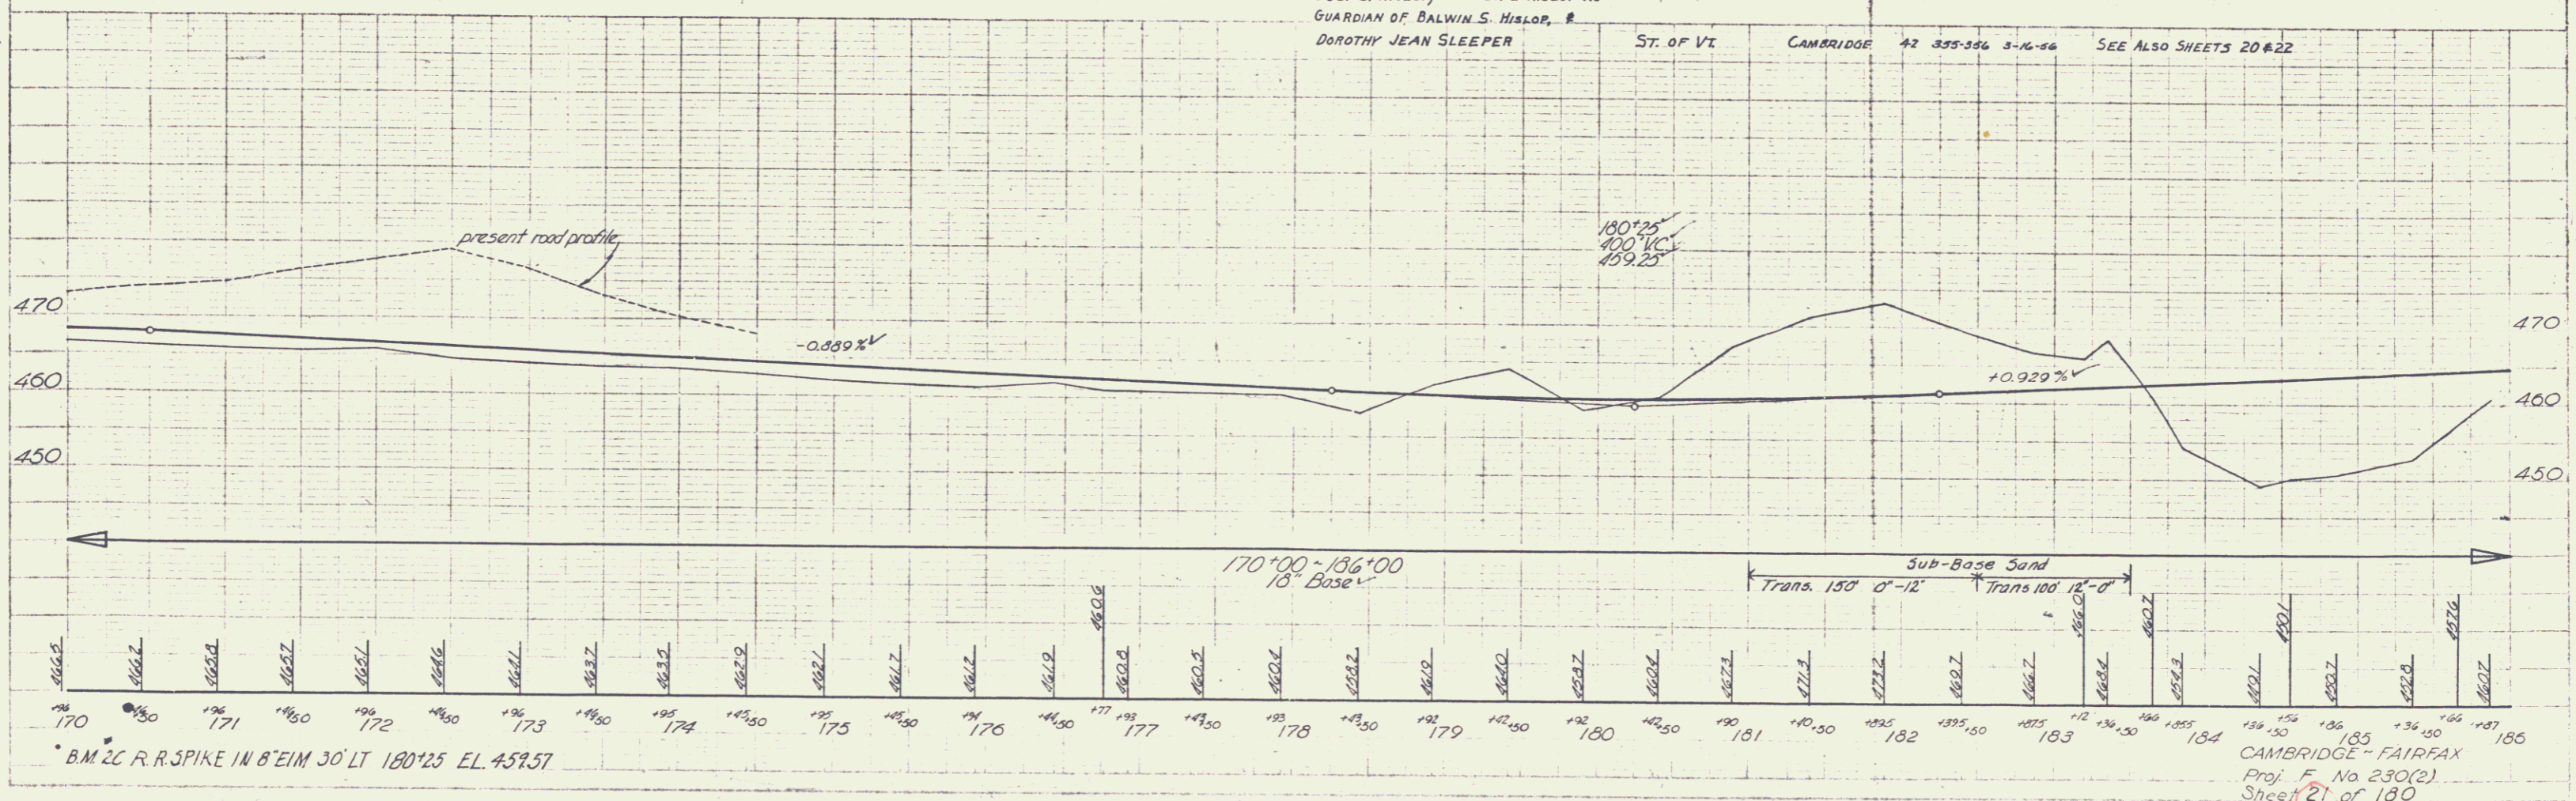

PROFILE
SCALE: 1" = 10'
DATE: 7/25/56
DRAWN BY: J. P. H. / T. P. H.

CAMBRIDGE - FAIRFAX
 Proj. No. 230(2)
 Sheet 21 of 180