

STEEL WOOD GUIDE POSTS
16' x 1/2"

205+42-210+54
215+33-217+00

206+08-207+00
206+26-206+41
215+33-217+00

GOVT PARTICIPATION
Sta 204+25-208+75
Instal sleeve for water pipe across
roadway and relay or furnish and
lay water pipe

THREE CABLE GUARD RAIL
WITH STEEL POSTS

LT +19
201+00-203+95


RT
201+00-203+95

206+58-210+52
209+60-217+00
201+00-202+00
208+49-210+73

CONSTRUCT TURNOUTS
206+95-209+95 LRV
212+50-215+50 RR

CONSTRUCT DRIVES
204+10-212+22 L1 4 RT
204+50-211+76 RT
212+55-218+90 L1

PARCEL	INSTR.	DATE	GRANTOR	GRANTEE	RECORDED	BOOK	PAGE	DATE	REMARKS
7	COND.	7-9-54	SMITH D. & BESSIE J. TAYLOR	ST. OF VT.	CAMBRIDGE	43	42-45	7-9-54	SEE ALSO SHEET 24

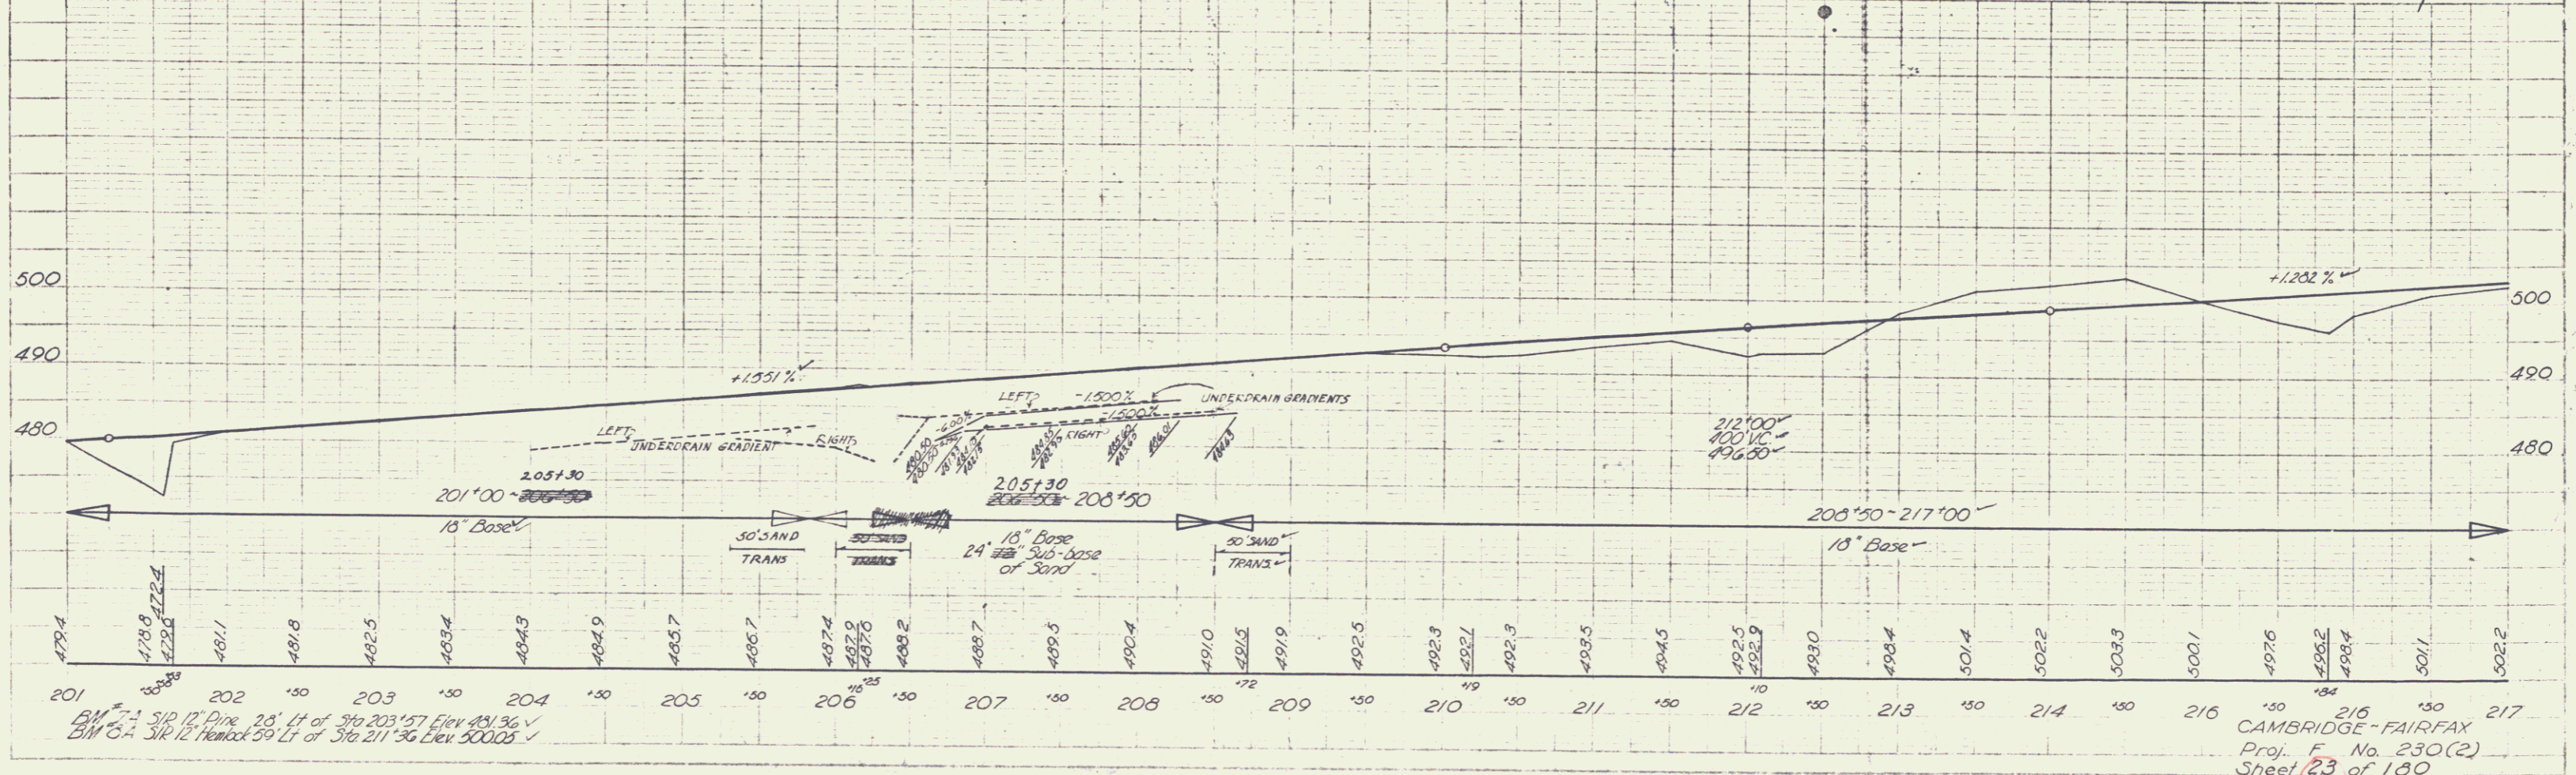

BM 7A 516.12 Pk 25 Lt of 316 203+57 Elev 481.96 ✓
BM 6A 516.12 Pk 59 Lt of 316 211+36 Elev 500.05 ✓

216
CAMBRIDGE-FAIRFAX
Proj. F No. 230(2)
Sheet 23 of 180