


PARCEL	INSTR.	DATE	GRANTOR	GRANTEE	RECORDED	BOOK	PAGE	DATE	REMARKS
8	W.D.E.	12-22-54	HAROLD B. & LOIS G. PUTNAM	ST. OF VT.	CAMBRIDGE	43	113-114	12-10-55	SEE ALSO SHEET 25

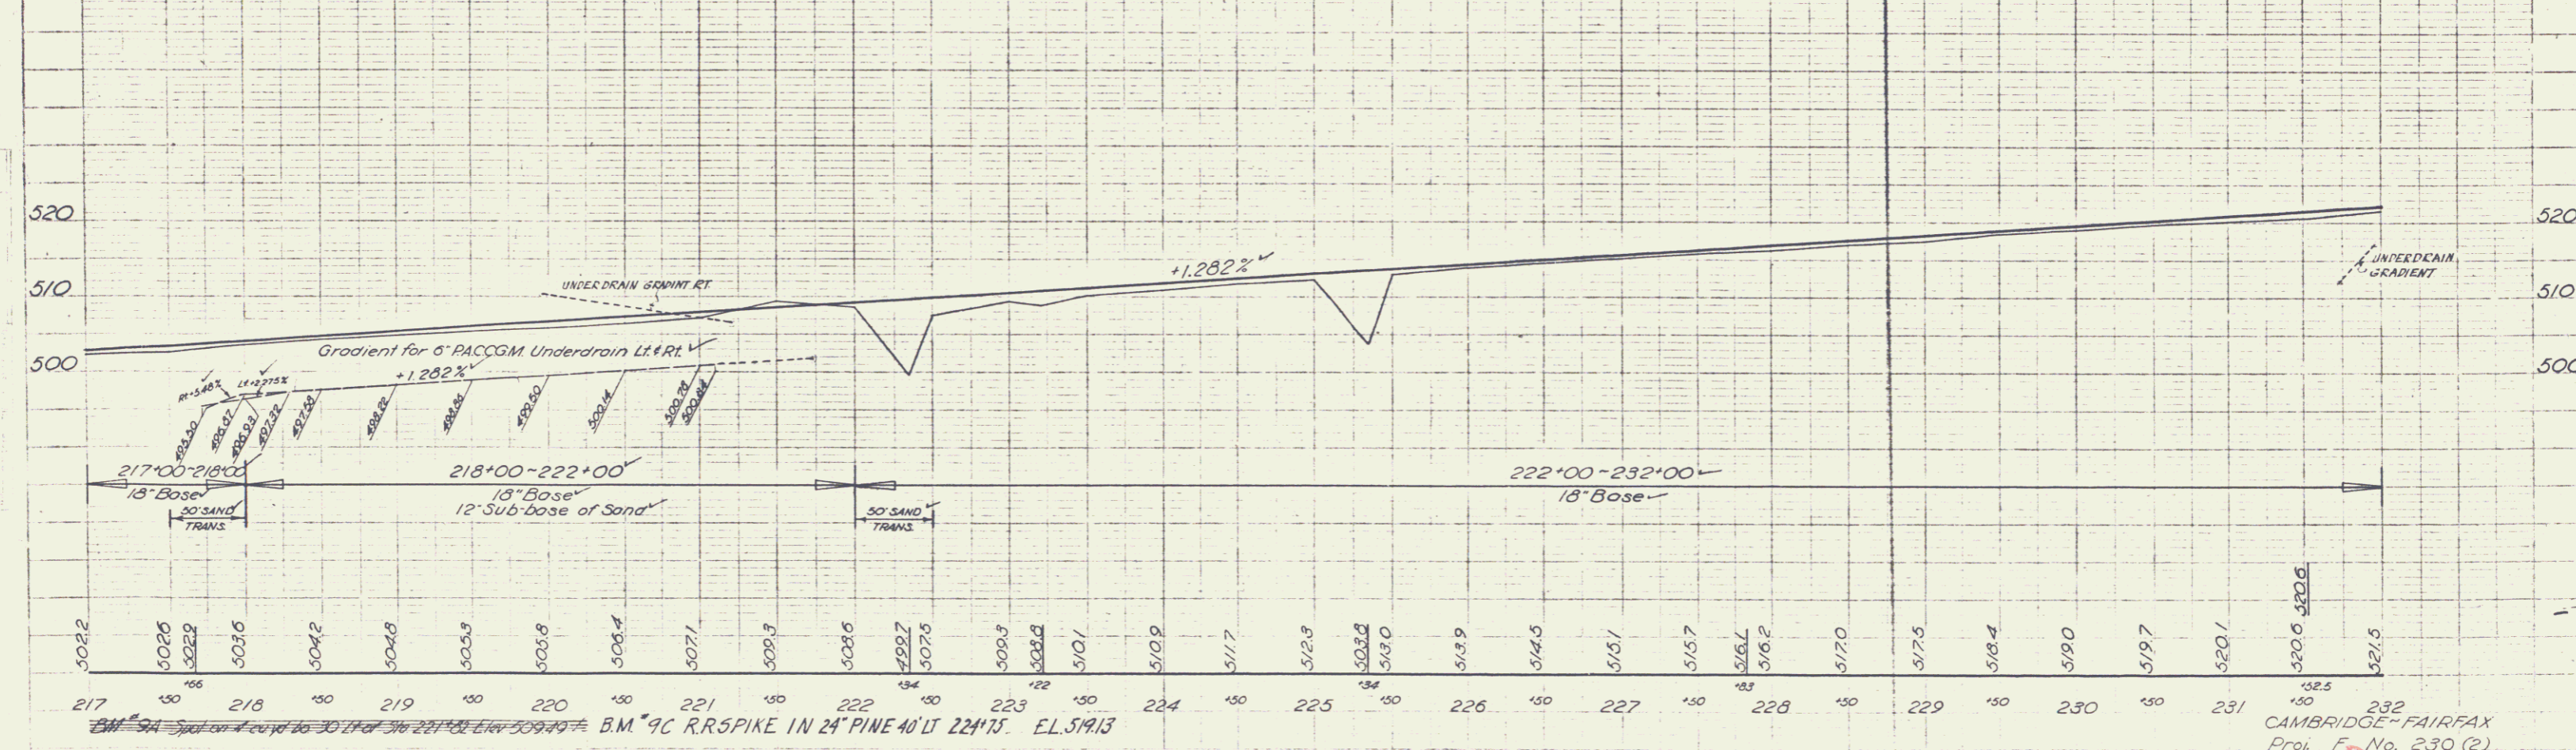

PLAN
 2/25
 8/25
 0/25
 7/

MILLER
 9/23

CAMBRIDGE-FAIRFAX
 Proj. F. No. 230 (2)
 Sheet 24 of 180