


PARCEL	INSTR	DATE	GRANTOR	GRANTEE	RECORDED	BOOK	PAGE	DATE	REMARKS
9	W.D.D.E.	12-22-54	HERBERT C. BELLWS & CORA A. BELLWS & ELIZABETH C. BELLWS	ST. OF VT.	CAMBRIDGE	43	117-118	2-6-56	SEE ALSO SHEET 26

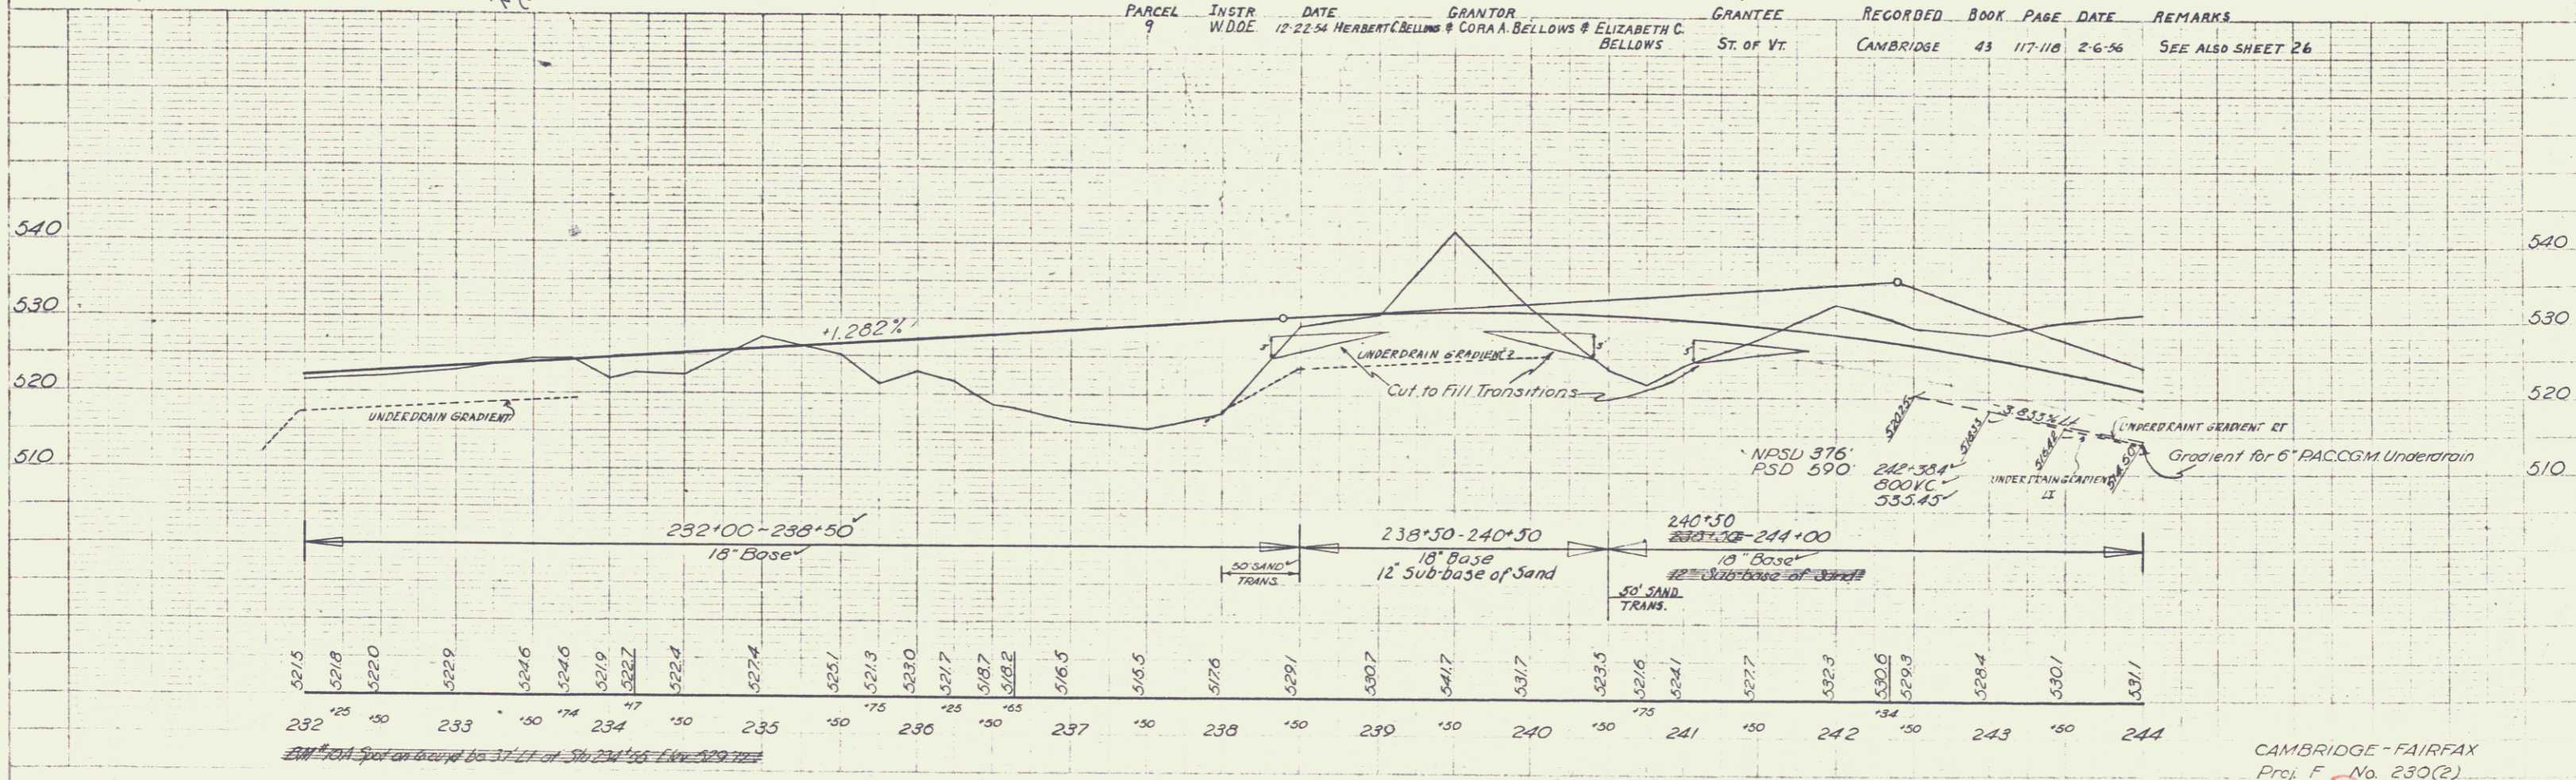

CAMBRIDGE - FAIRFAX  
 Proj. F. No. 230(2)  
 Sheet 25 of 180

PLAK 5/23 0/25  
 3/10/59  
 J.R.  
 TRACED

9/52  
 MILLER