
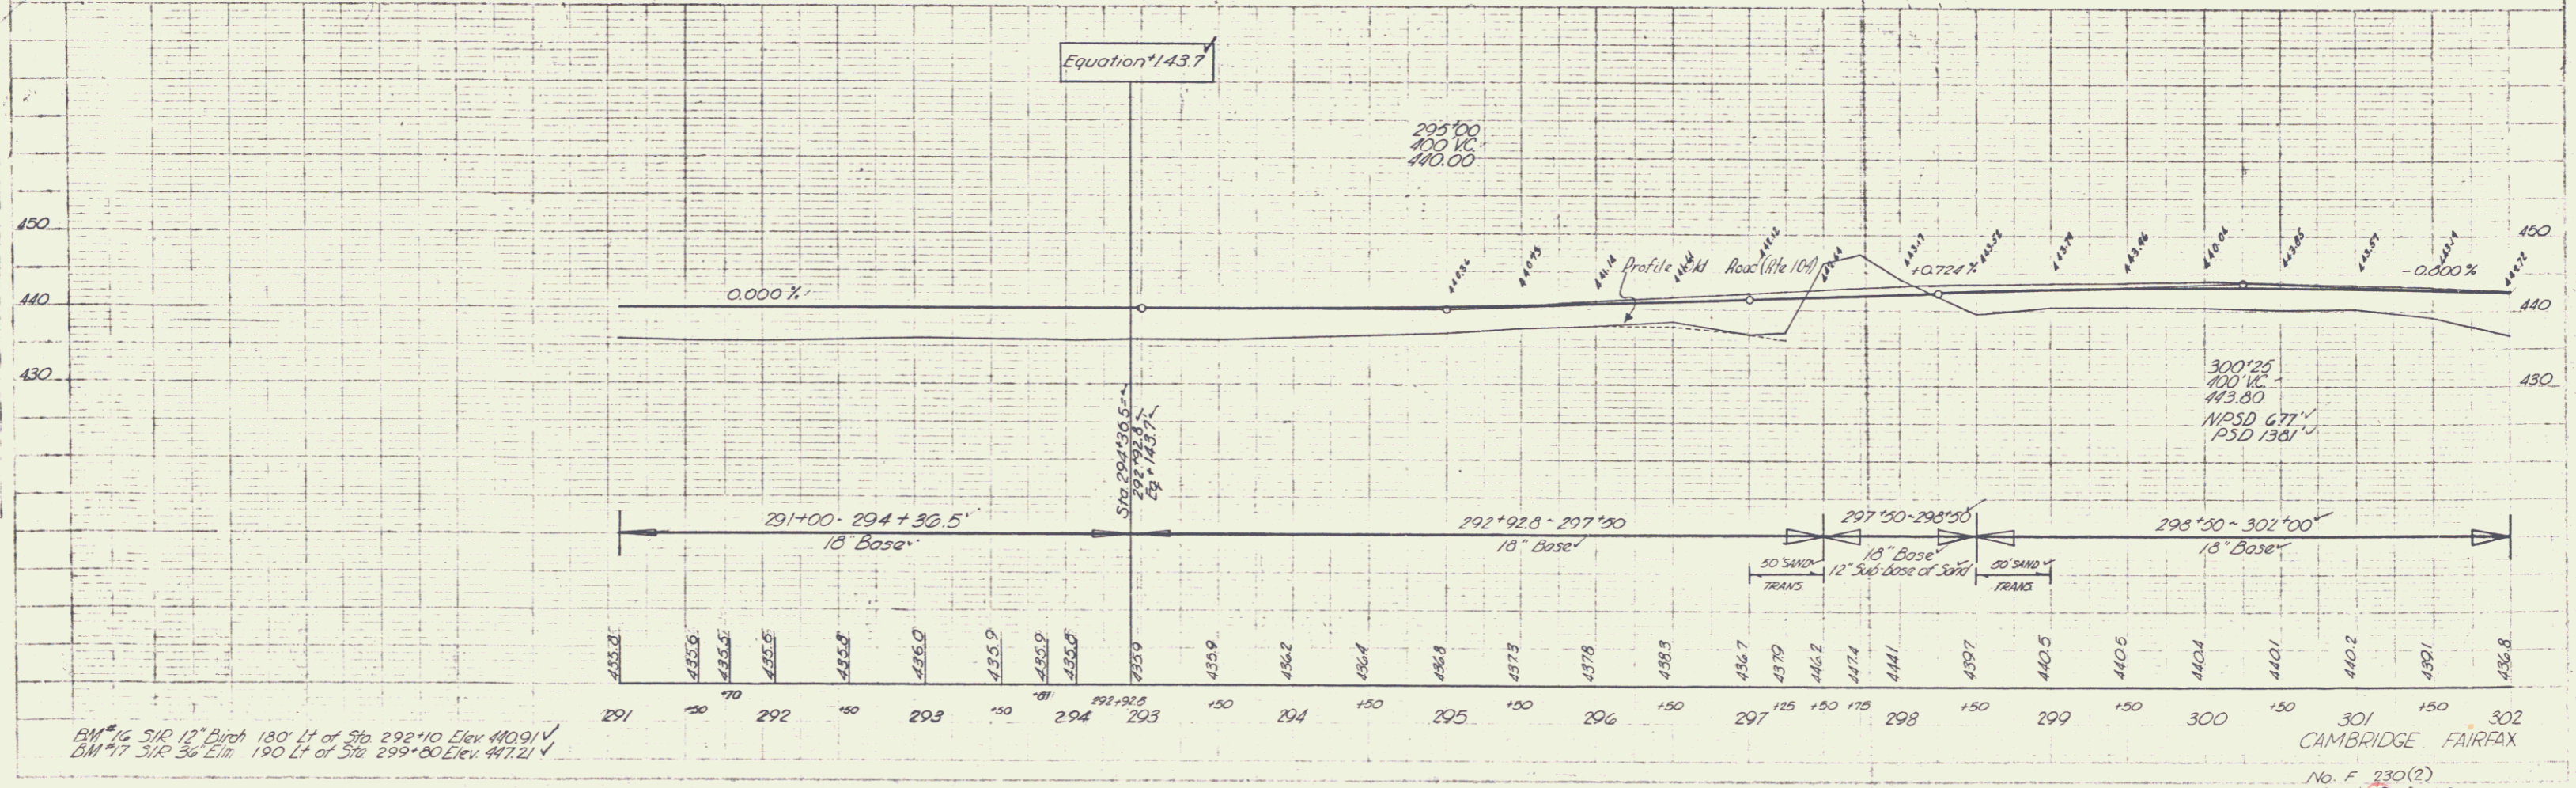


PLAN
Scale 1" = 40'
Date 7/28
Project
Road

PLAN
Scale 1" = 40'
Date 7/28
Project
Road

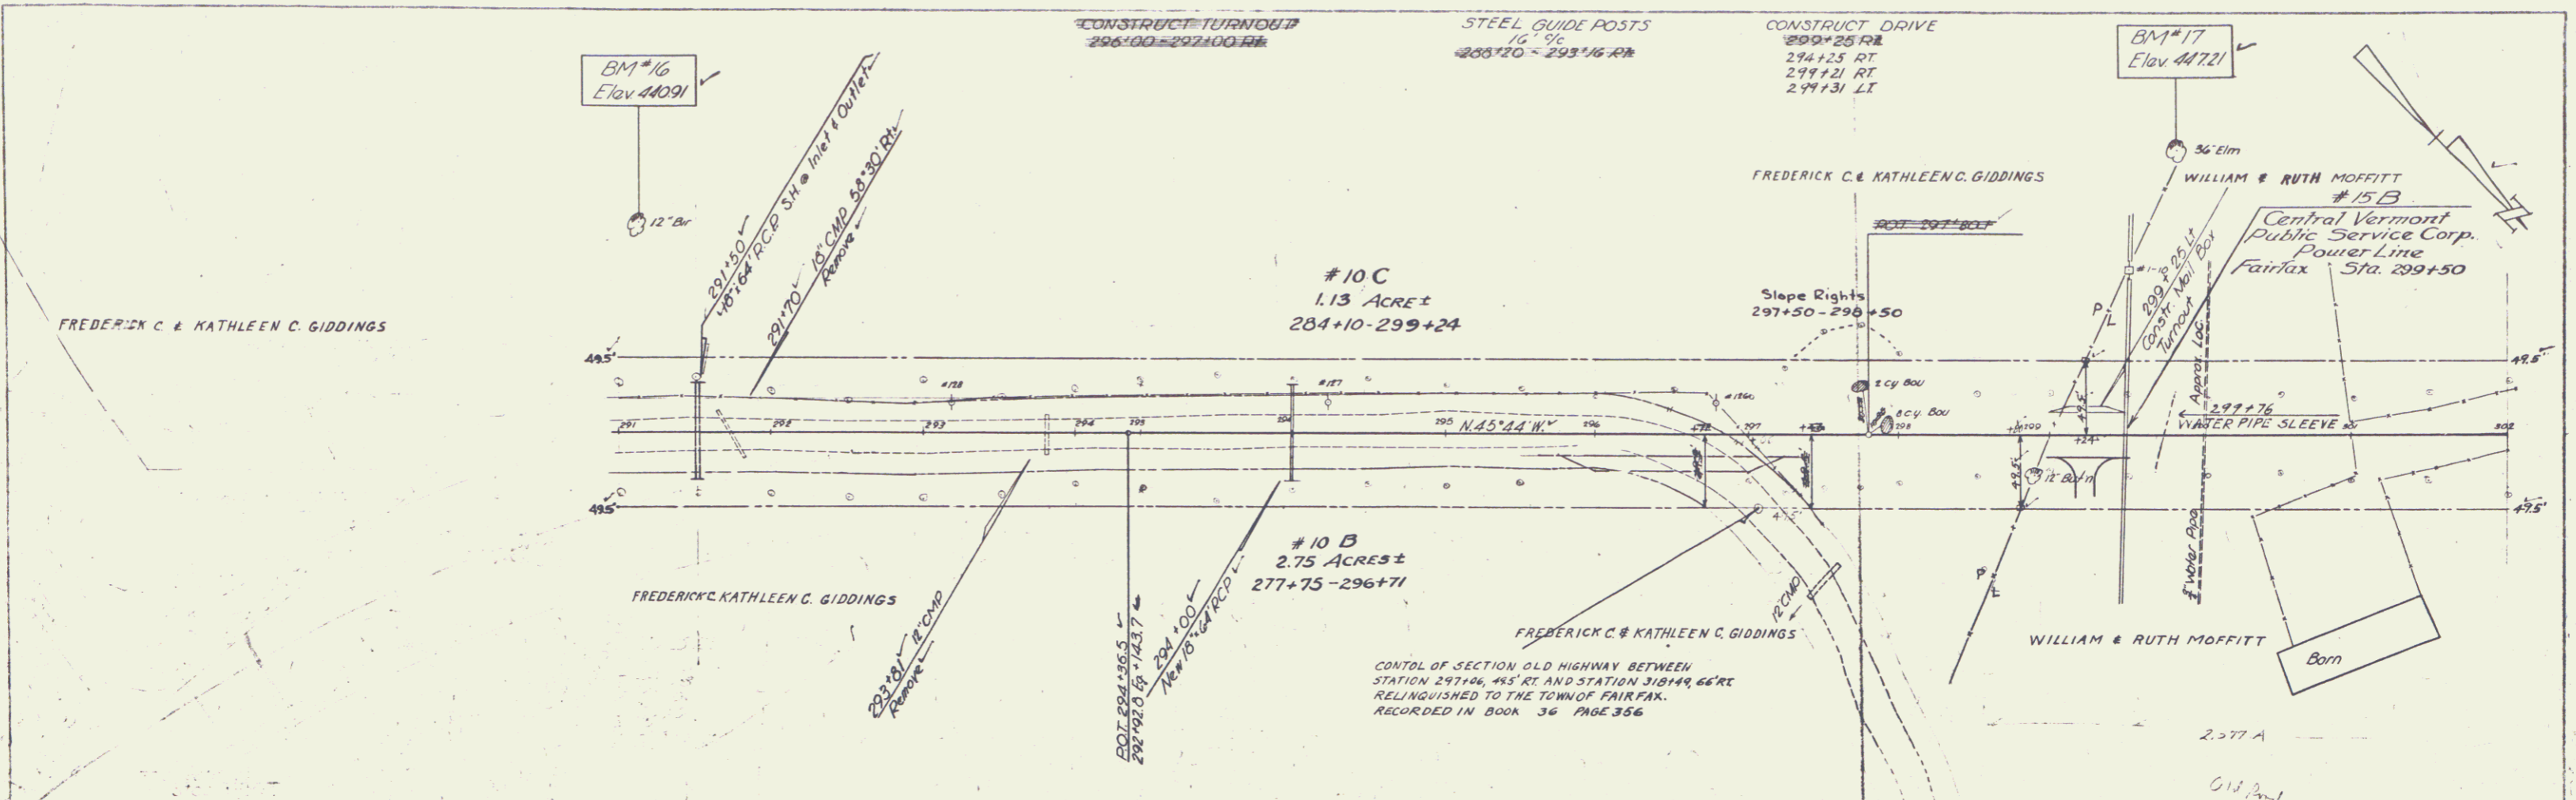

BM#16 5/10 12" Birch 180' Lt of 36 292+10 Elev 44091 ✓
 BM#17 3/18 36 Elm 190' Lt of 36 299+00 Elev 44721 ✓

No. F 230(2)
 sheet 30 of 180