


PLANK 3-ARD RAIL
303+93 - 304+12 RT
303+90 - 304+14 LI


PARCEL	INSTR.	DATE	GRANTOR	GRANTEE	RECORDED	BOOK	PAGE	DATE	REMARKS
11	W.D.E.	12-22-54	WILLIAM & RUTH MOFFITT	ST. OF VT.	FAIRFAX	36	272	12-9-55	SEE ALSO SHEETS 30#32

#11
5.39 ACRES±
STA. 298+80 - 318+65

PLAN
DATE 7/23/55
BY L.P.H.

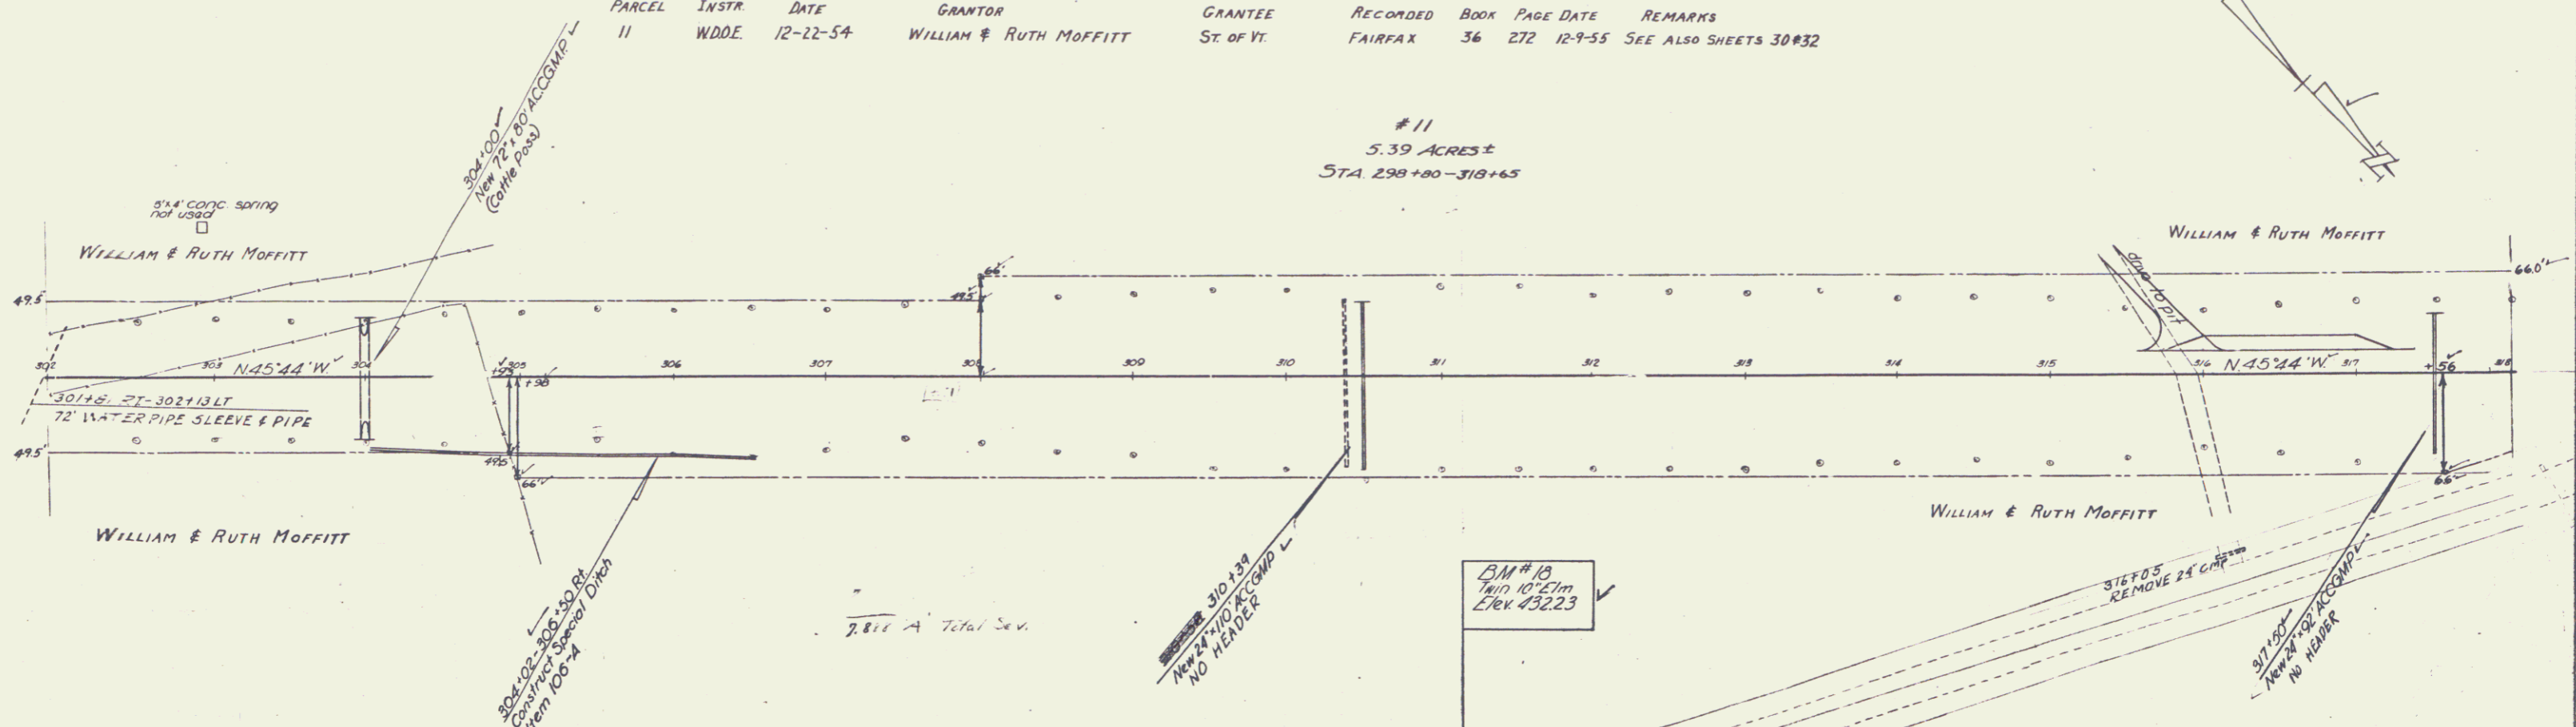

PLAN
DATE 7/23/55
BY L.P.H.

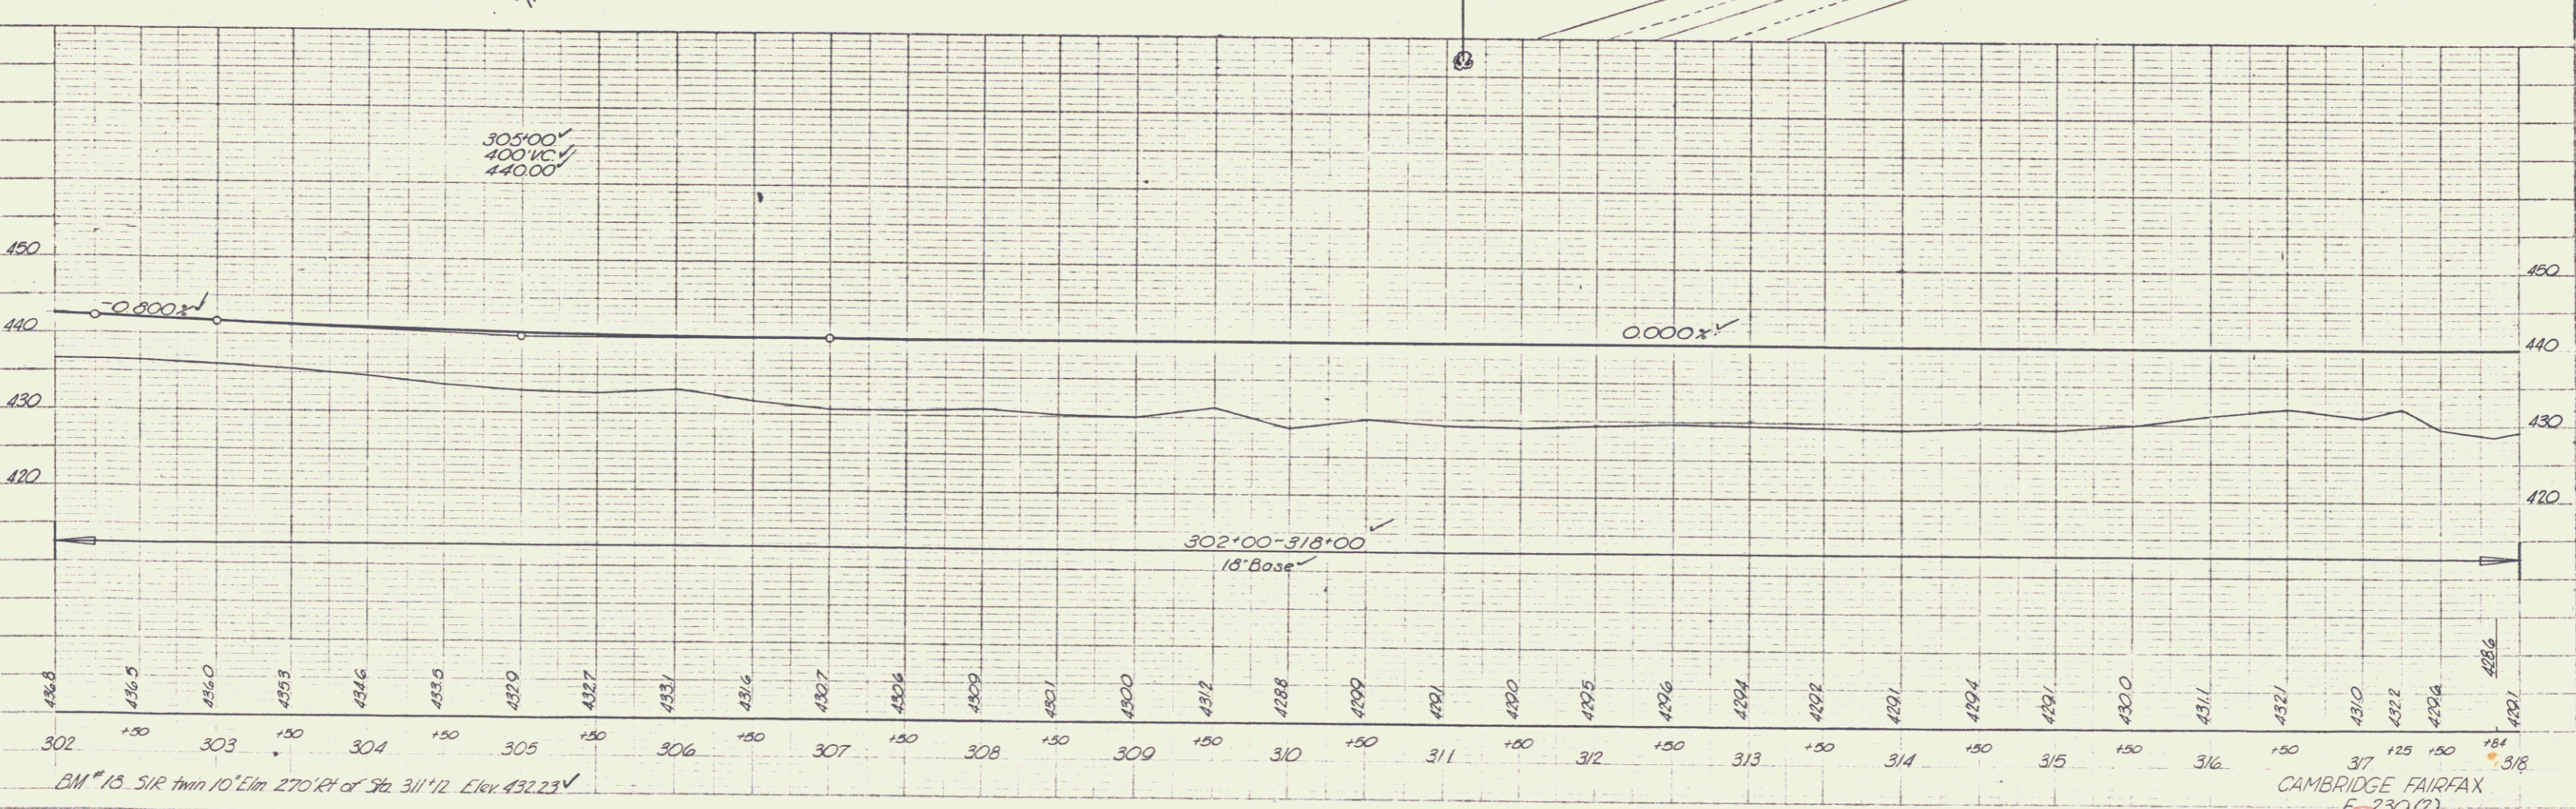

BM #13. S.I.R. thru 10' Elm 270' RT of Sta. 311+12. Elev. 432.23 ✓

CAMBRIDGE FAIRFAX
F-230(2)
sheet 31 of 180