
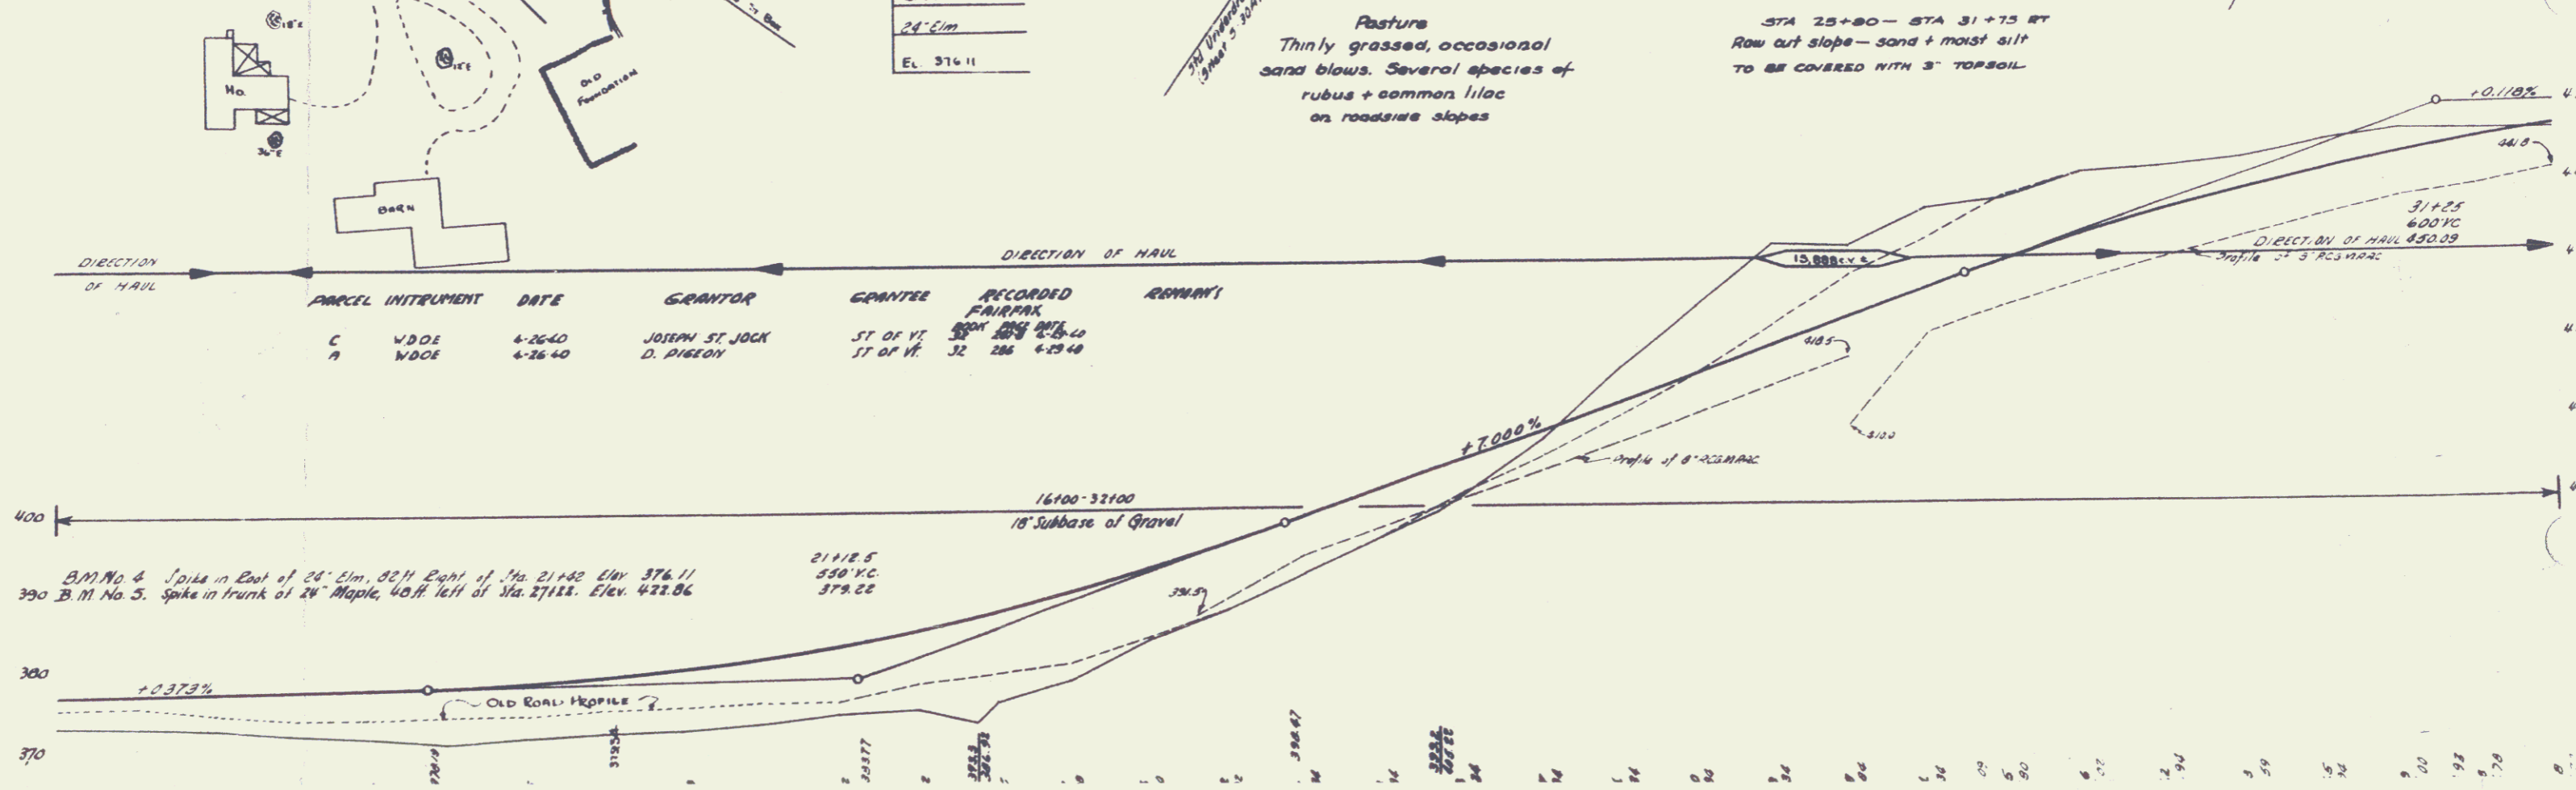


NOTE
 FLOOR FOUNDATION MATERIAL TAKEN FROM STA 17+00 - 20+00 SHALL BE USED ON THE OUTSIDE OF THE SLOPES AS INDICATED BY THE SHADED PARTS OF THE CROSS SECTIONS NEAR THIS AREA.

NOTE
 BRICKSILL NECESSITATED BY ELEVATION OF PEEK FOUNDATION MATERIAL STA 17+00 - 20+00 SHALL BE MADE OF MATERIAL TAKEN FROM VILLAGE STREET, STA 0+00 - 8+00.

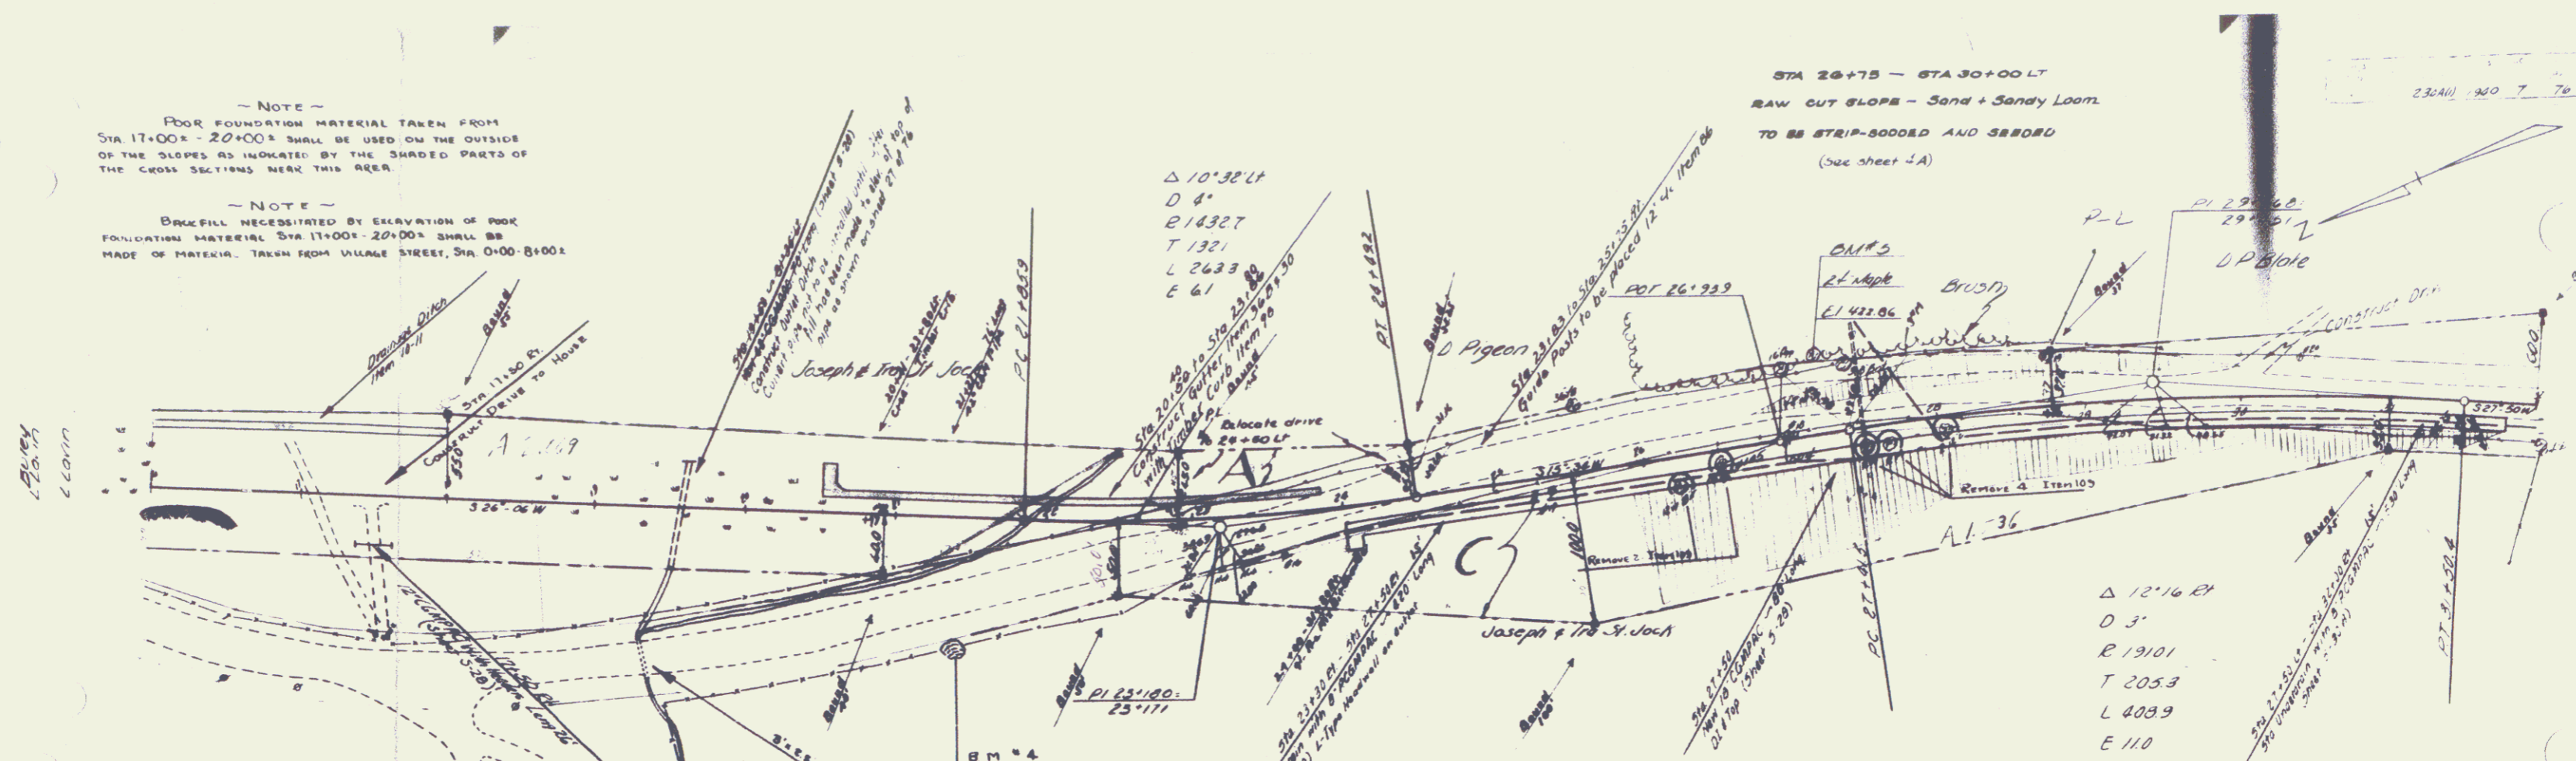

PARCEL	INSTRUMENT	DATE	GRANTOR	GRANTEE	RECORDED	REMARKS
C	W.D.E.	4-26-40	JOSEPH ST. JOCK	ST OF VT	55	286 4-26-40
A	W.D.E.	4-26-40	D. PIGEON	ST OF VT	32	286 4-26-40

B.M. No. 4 Spike in East of 24' Elm, 80' N. East of Sta. 21+42 Elev. 376.11
 390 B.M. No. 5. Spike in trunk of 24' Maple, 40' N. West of Sta. 27+12. Elev. 422.86