


INSTRUMENT	DATE	GRANTOR	GRANTEE	RECORDED FAIRFAX	BOOK	ANGLE	DATE	REMARKS
A	COND.	TOWN OF FAIRFAX	HEIRY OF BOWEN WARREN	ST OF VT	32	251-53	4-27-40	
A'	W.DOE	4-26-40	R.B. L. G.M. FONTON	ST OF VT	32	251	4-28-40	

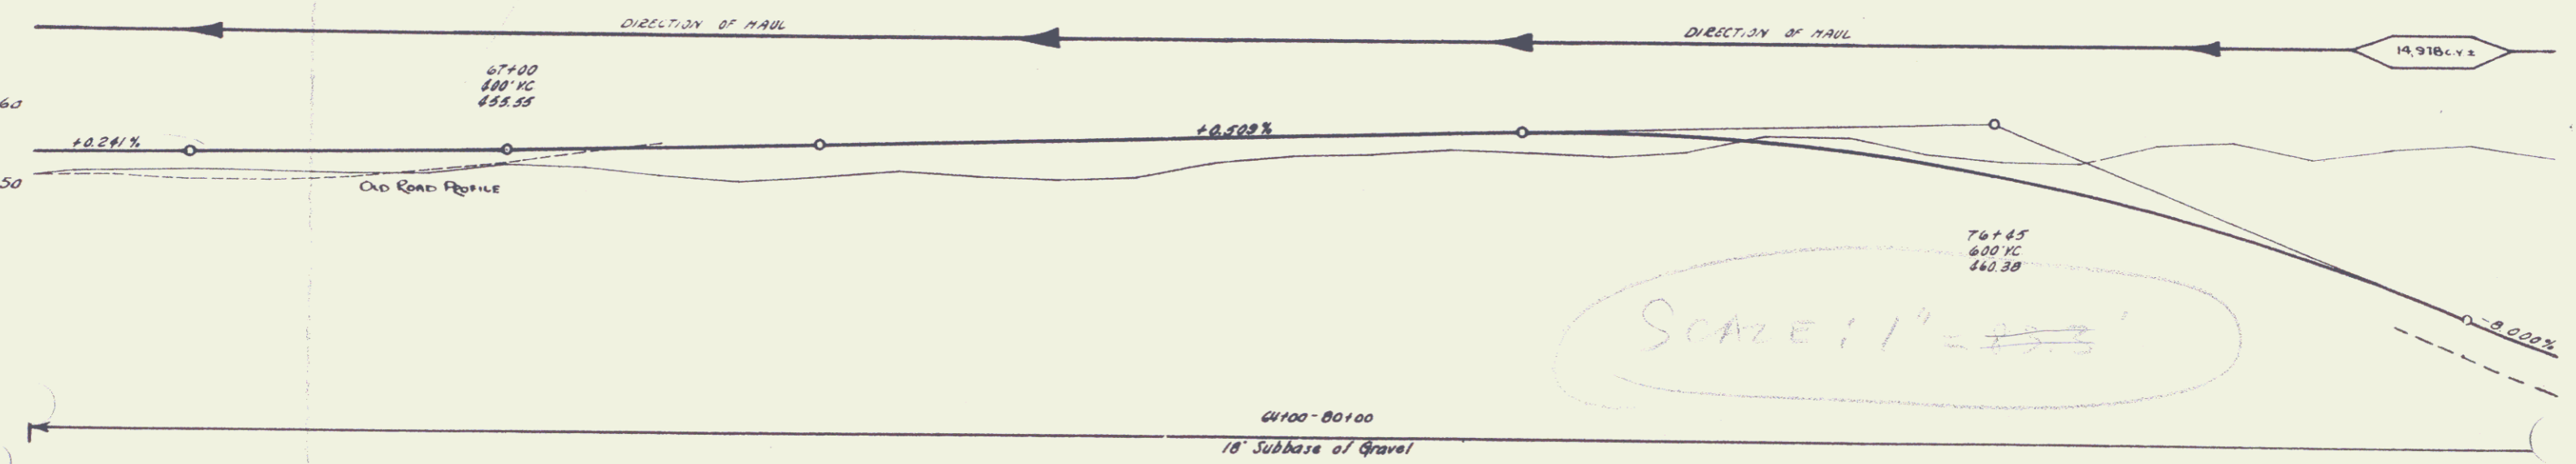

STATION	ELEVATION
65+00	455.83
65+10	456.07
65+20	456.25
65+30	456.40
65+40	456.55
65+50	456.70
65+60	456.85
65+70	457.00
65+80	457.15
65+90	457.30
66+00	457.45
66+10	457.60
66+20	457.75
66+30	457.90
66+40	458.05
66+50	458.20
66+60	458.35
66+70	458.50
66+80	458.65
66+90	458.80
67+00	458.95
67+10	459.10
67+20	459.25
67+30	459.40
67+40	459.55
67+50	459.70
67+60	459.85
67+70	459.95
67+80	460.05
67+90	460.15
68+00	460.25
68+10	460.35
68+20	460.45
68+30	460.55
68+40	460.65
68+50	460.75
68+60	460.85
68+70	460.95
68+80	461.05
68+90	461.15
69+00	461.25
69+10	461.35
69+20	461.45
69+30	461.55
69+40	461.65
69+50	461.75
69+60	461.85
69+70	461.95
69+80	462.05
69+90	462.15
70+00	462.25
70+10	462.35
70+20	462.45
70+30	462.55
70+40	462.65
70+50	462.75
70+60	462.85
70+70	462.95
70+80	463.05
70+90	463.15
71+00	463.25
71+10	463.35
71+20	463.45
71+30	463.55
71+40	463.65
71+50	463.75
71+60	463.85
71+70	463.95
71+80	464.05
71+90	464.15
72+00	464.25
72+10	464.35
72+20	464.45
72+30	464.55
72+40	464.65
72+50	464.75
72+60	464.85
72+70	464.95
72+80	465.05
72+90	465.15
73+00	465.25
73+10	465.35
73+20	465.45
73+30	465.55
73+40	465.65
73+50	465.75
73+60	465.85
73+70	465.95
73+80	466.05
73+90	466.15
74+00	466.25
74+10	466.35
74+20	466.45
74+30	466.55
74+40	466.65
74+50	466.75
74+60	466.85
74+70	466.95
74+80	467.05
74+90	467.15
75+00	467.25
75+10	467.35
75+20	467.45
75+30	467.55
75+40	467.65
75+50	467.75
75+60	467.85
75+70	467.95
75+80	468.05
75+90	468.15
76+00	468.25
76+10	468.35
76+20	468.45
76+30	468.55
76+40	468.65
76+50	468.75
76+60	468.85
76+70	468.95
76+80	469.05
76+90	469.15
77+00	469.25
77+10	469.35
77+20	469.45
77+30	469.55
77+40	469.65
77+50	469.75
77+60	469.85
77+70	469.95
77+80	470.05
77+90	470.15
78+00	470.25
78+10	470.35
78+20	470.45
78+30	470.55
78+40	470.65
78+50	470.75
78+60	470.85
78+70	470.95
78+80	471.05
78+90	471.15
79+00	471.25
79+10	471.35
79+20	471.45
79+30	471.55
79+40	471.65
79+50	471.75
79+60	471.85
79+70	471.95
79+80	472.05
79+90	472.15
80+00	472.25

SHEET 11