


4-1933  
J.E.R.

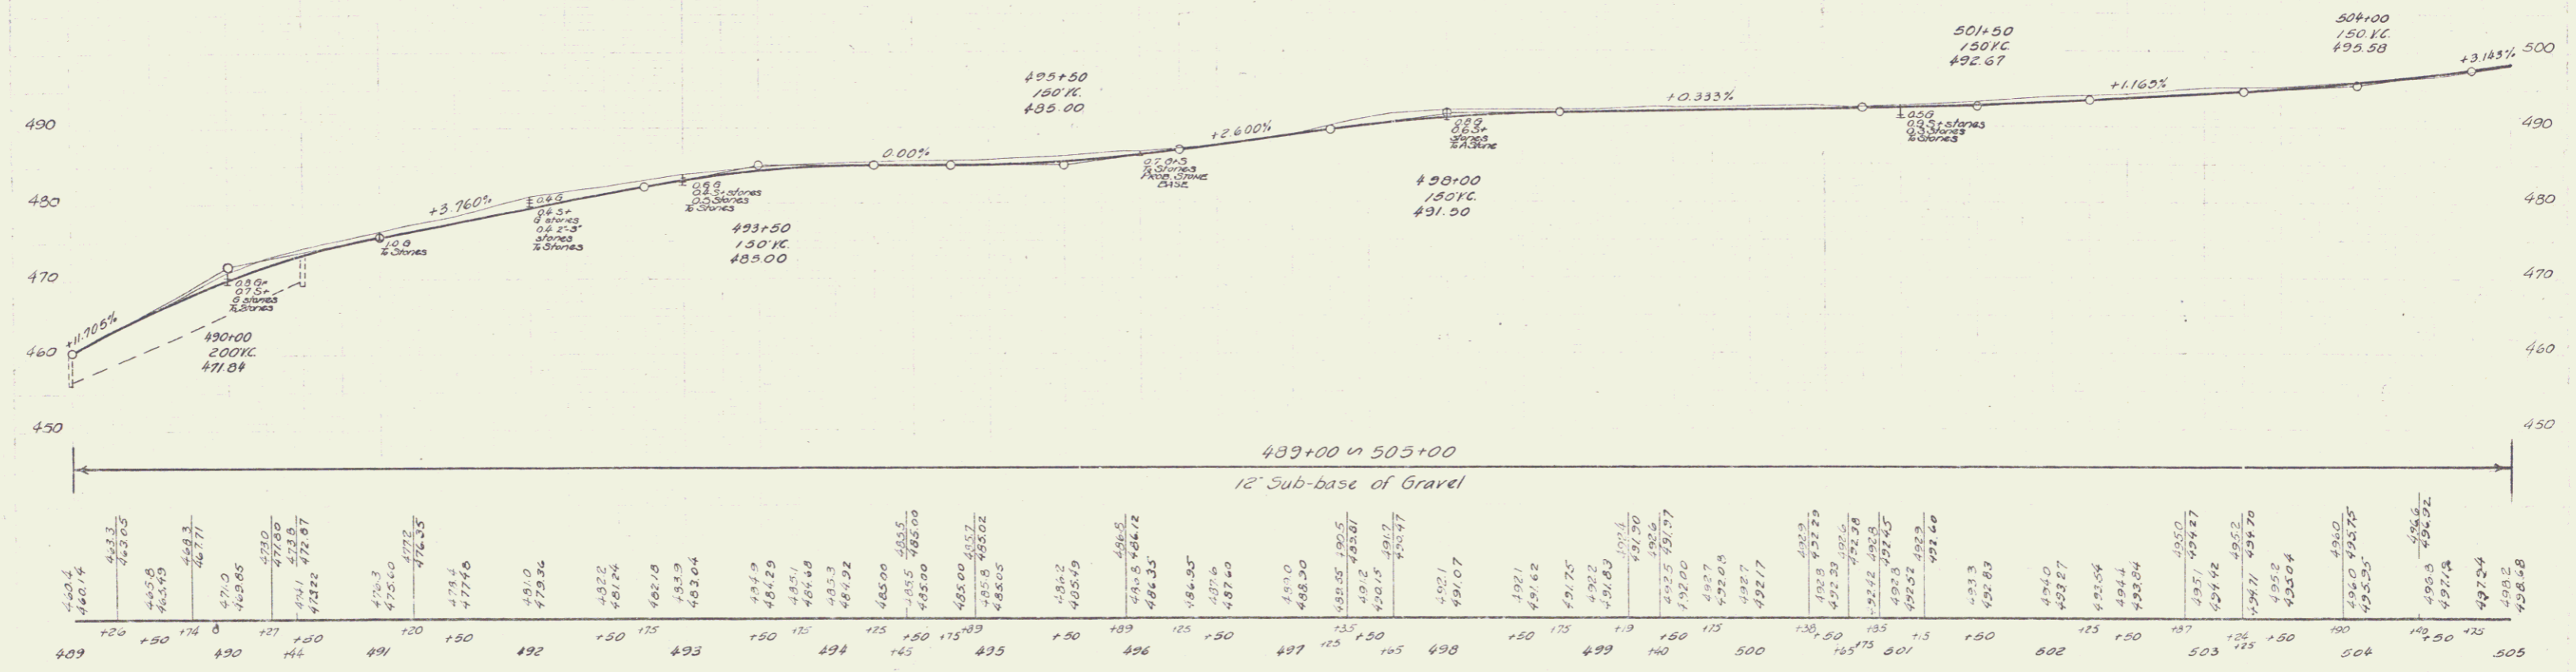

B.M. 44 SPINE IN ROOT OF 36" MAPLE, 29 FT LT. OF STA 496+90, ELEV. 485.73  
 B.M. 45 SPINE IN ROOT OF 24" ELM., 34 FT RT. OF STA 504+00, ELEV. 493.40

SERIES F. No. NRH 136-B  
 SHEET 5 OF 44 SHEETS

3