
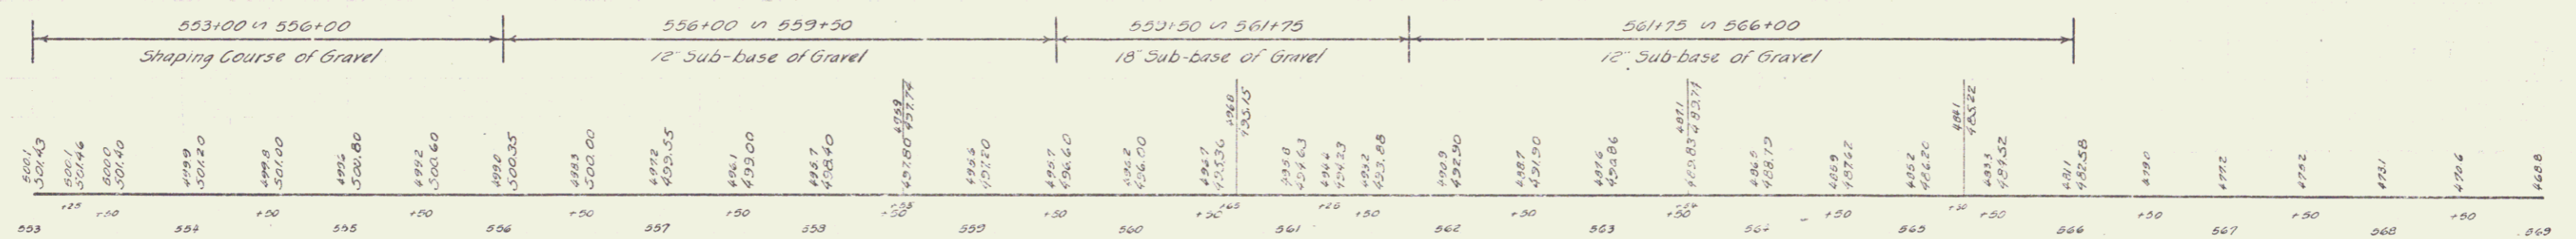
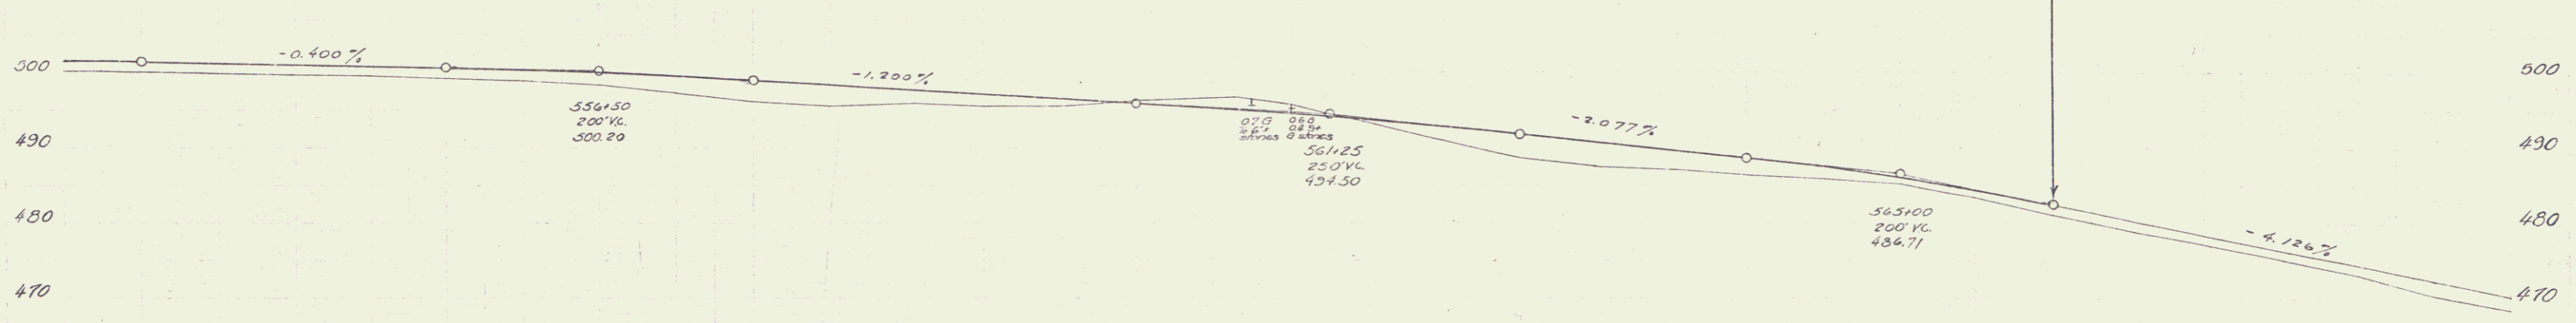


Parcel	Kind of Instrument	Date of Instrument	Grantor	Grantee	Recorded Folio	Remarks
A	G.C.D.	1-17-34	H.B. Bellows	St. of V. 31	229	1-25-34
A'	"	8-14-33	M.E. Shedd	" 31	226	9-15-33

NOV 13 1933 9 44

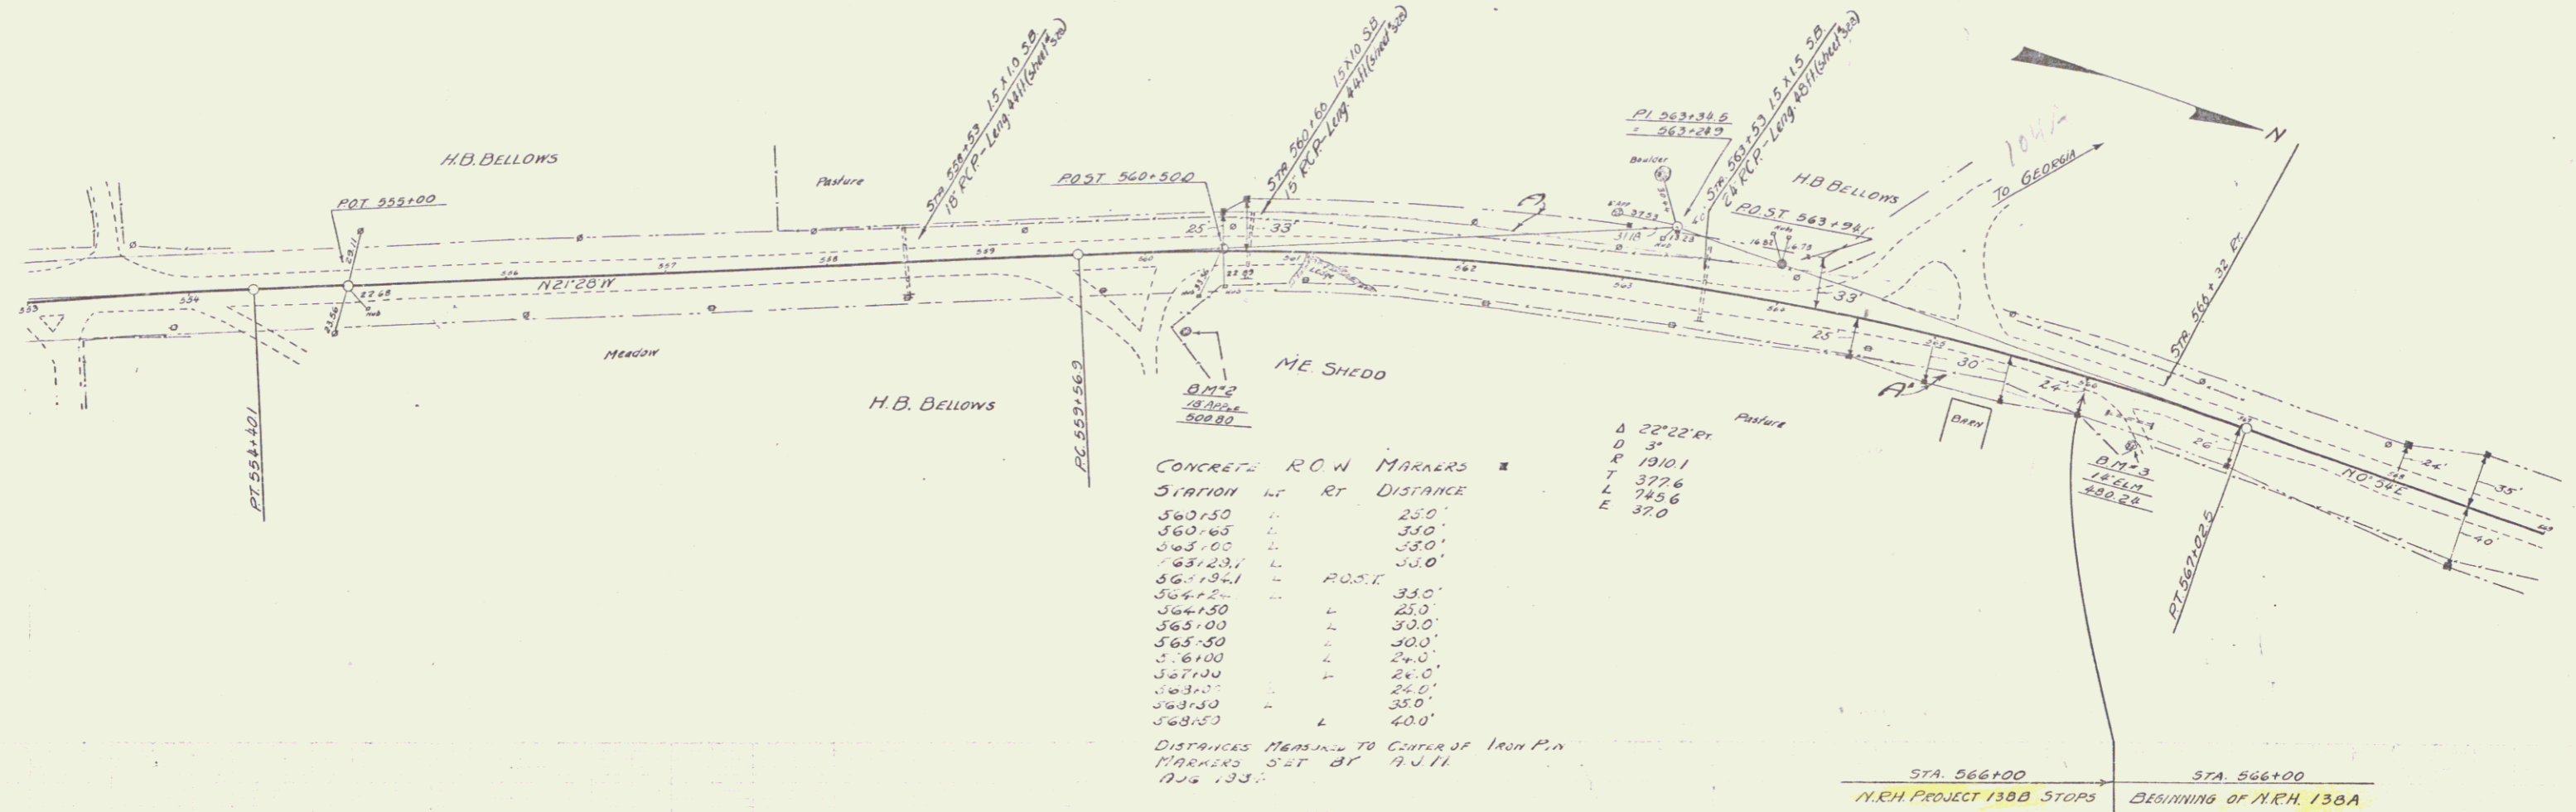

B.M. #2 SPIKE IN TRUNK OF 18" APPLE, 49 FT RT OF STA. 560+25, ELEV. 500.80
 B.M. #3 SPIKE IN ROOT OF 14" ELM, 42 FT RT. OF STA. 566+40, ELEV. 480.24

SERIES No. NCH 138-B
 SHEET 9 of 44 SHEETS