


Record	Kind of Instrument	Date of Grant	Grantor	Grantee	Recorded	Remarks
C.D. 6313	3 1/2"	8-14-33	Lamarche et al	Staff	31 134	3 1/2" Sta 6313, 6314, 6315


NOV 28 1933 12 49

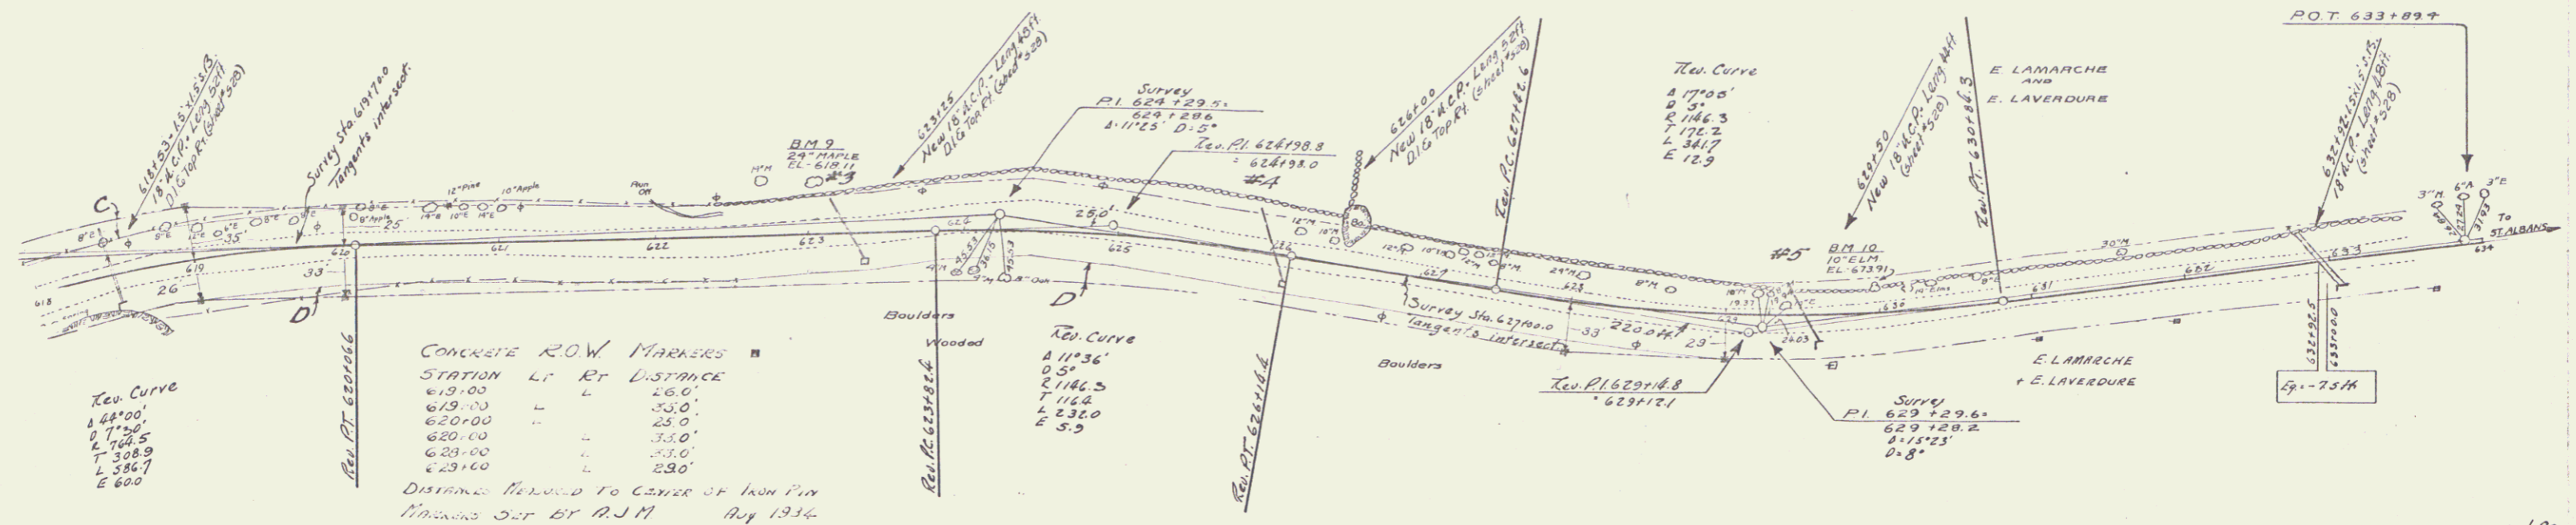

CONCRETE ROW MARKERS

STATION	LT	RT	DISTANCE
619+00	L	L	20.0'
620+00	L	L	33.0'
620+00	L	L	33.0'
DISTANCE MEASURED TO CENTER OF IRON PIN MARKERS SET BY R.J.M. Aug 1934

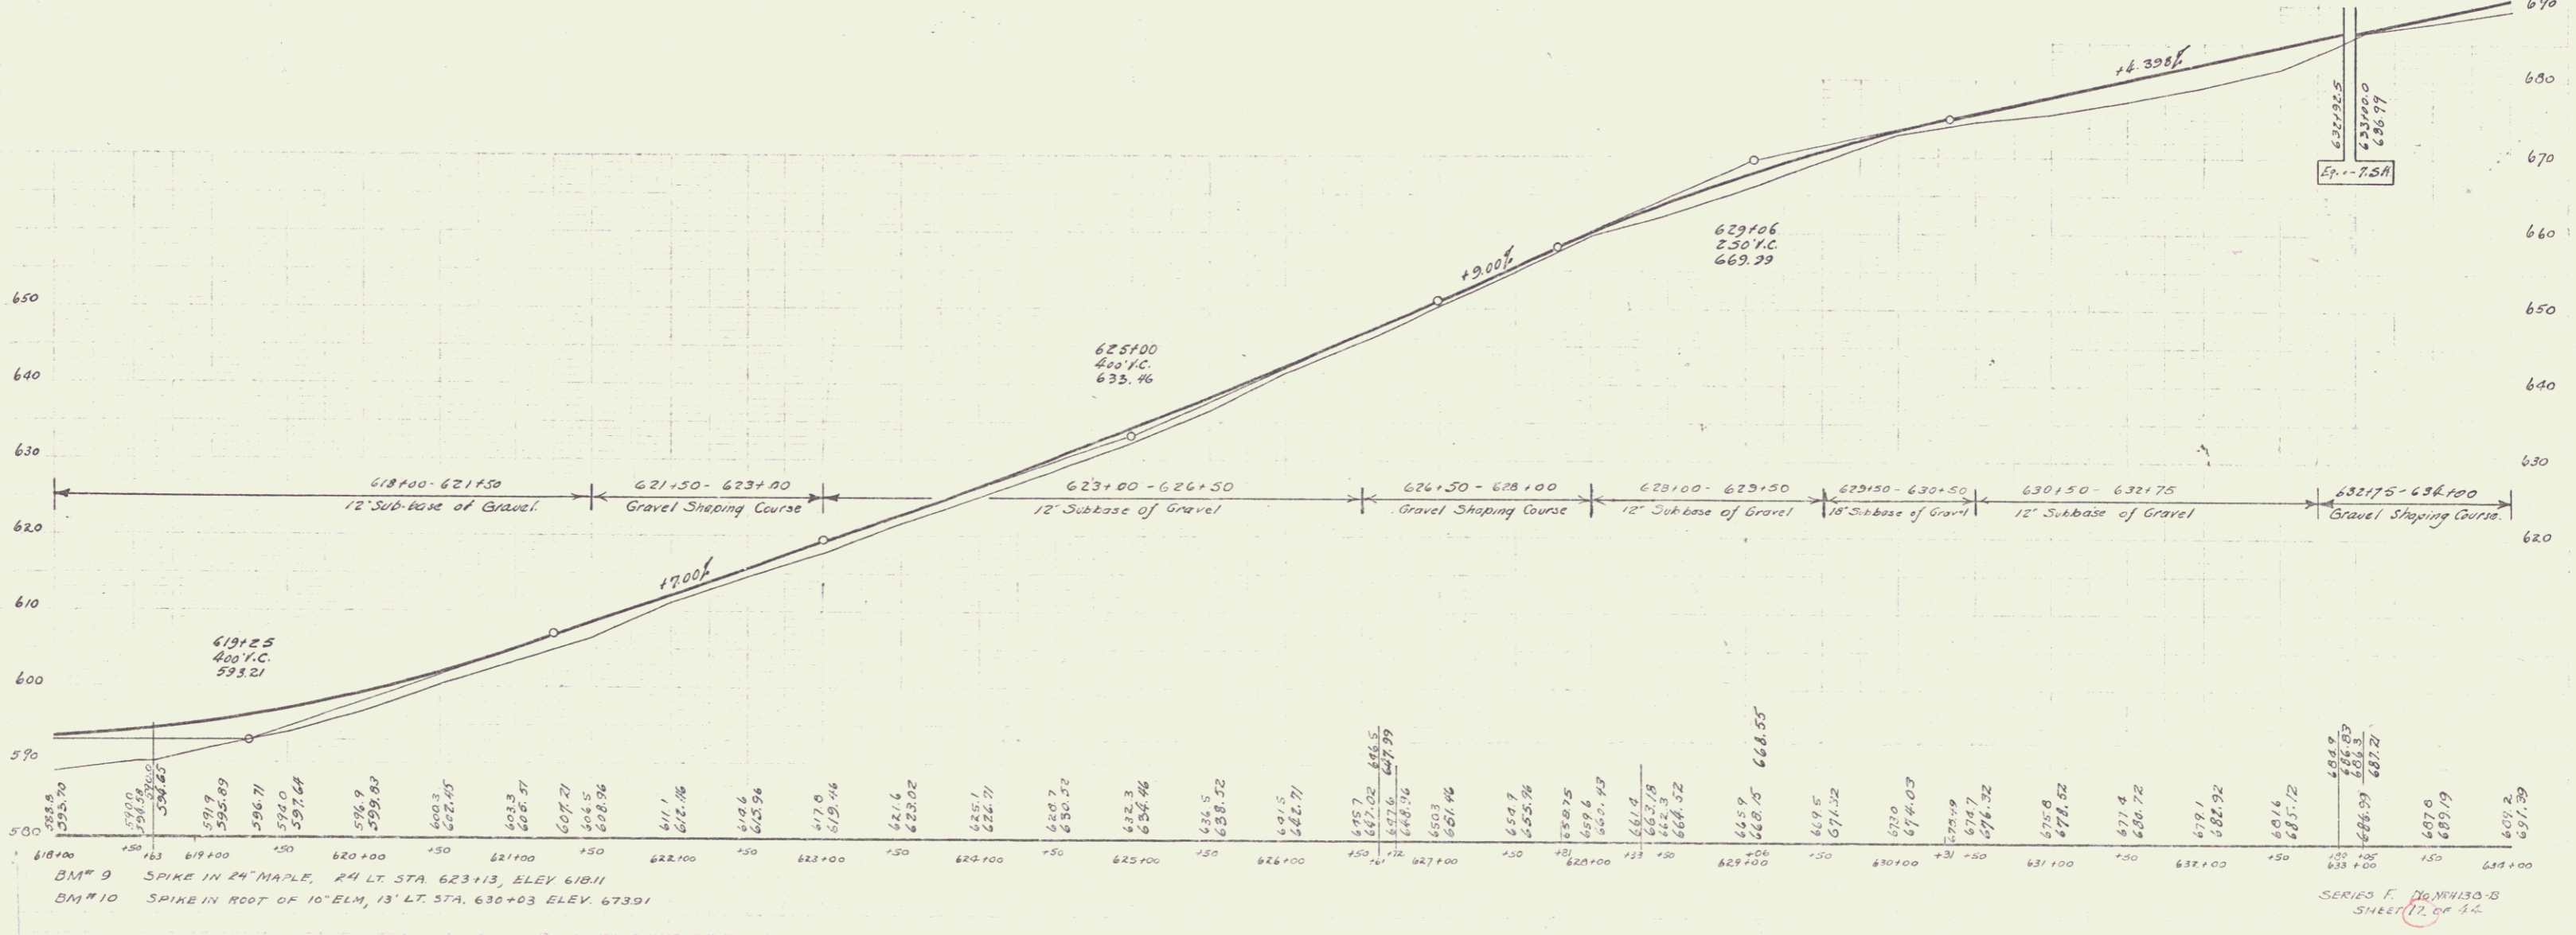

BM# 9 SPIKE IN 24 MAPLE, 24' LT. STA 623+13, ELEV 618.11
 BM# 10 SPIKE IN ROOT OF 10' ELM, 13' LT. STA. 630+03, ELEV 673.91

SERIES F. De M4130-B
 SHEET 12 OF 14