



D. BRUNSON  
D. MACCHI 6/34

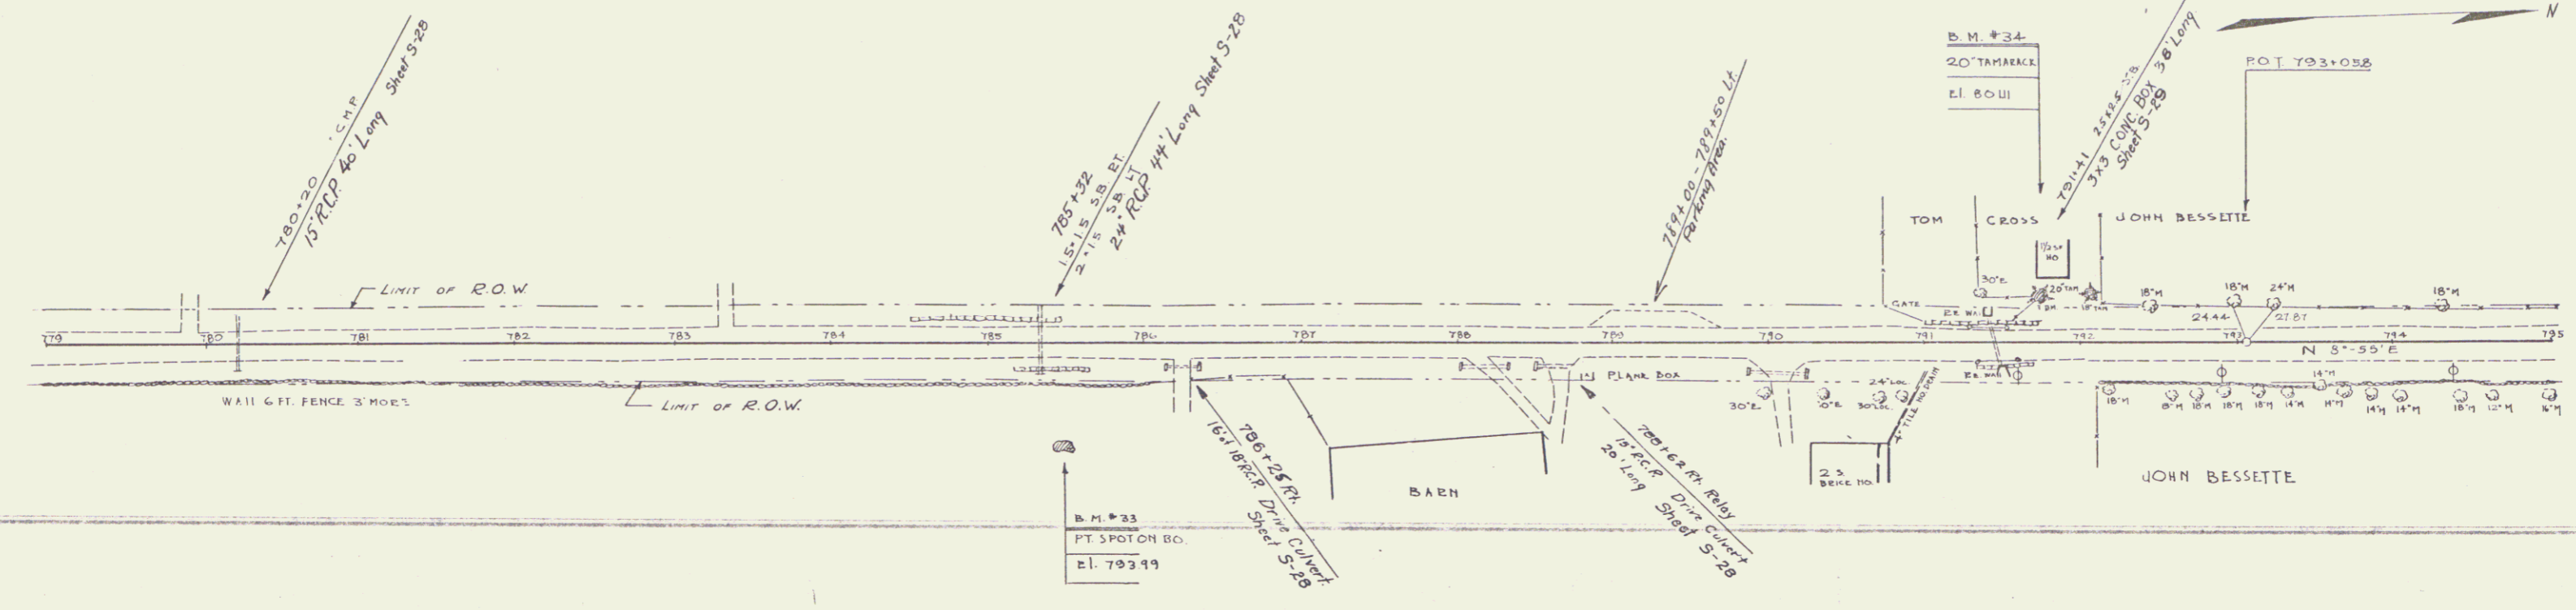

D. BRUNSON

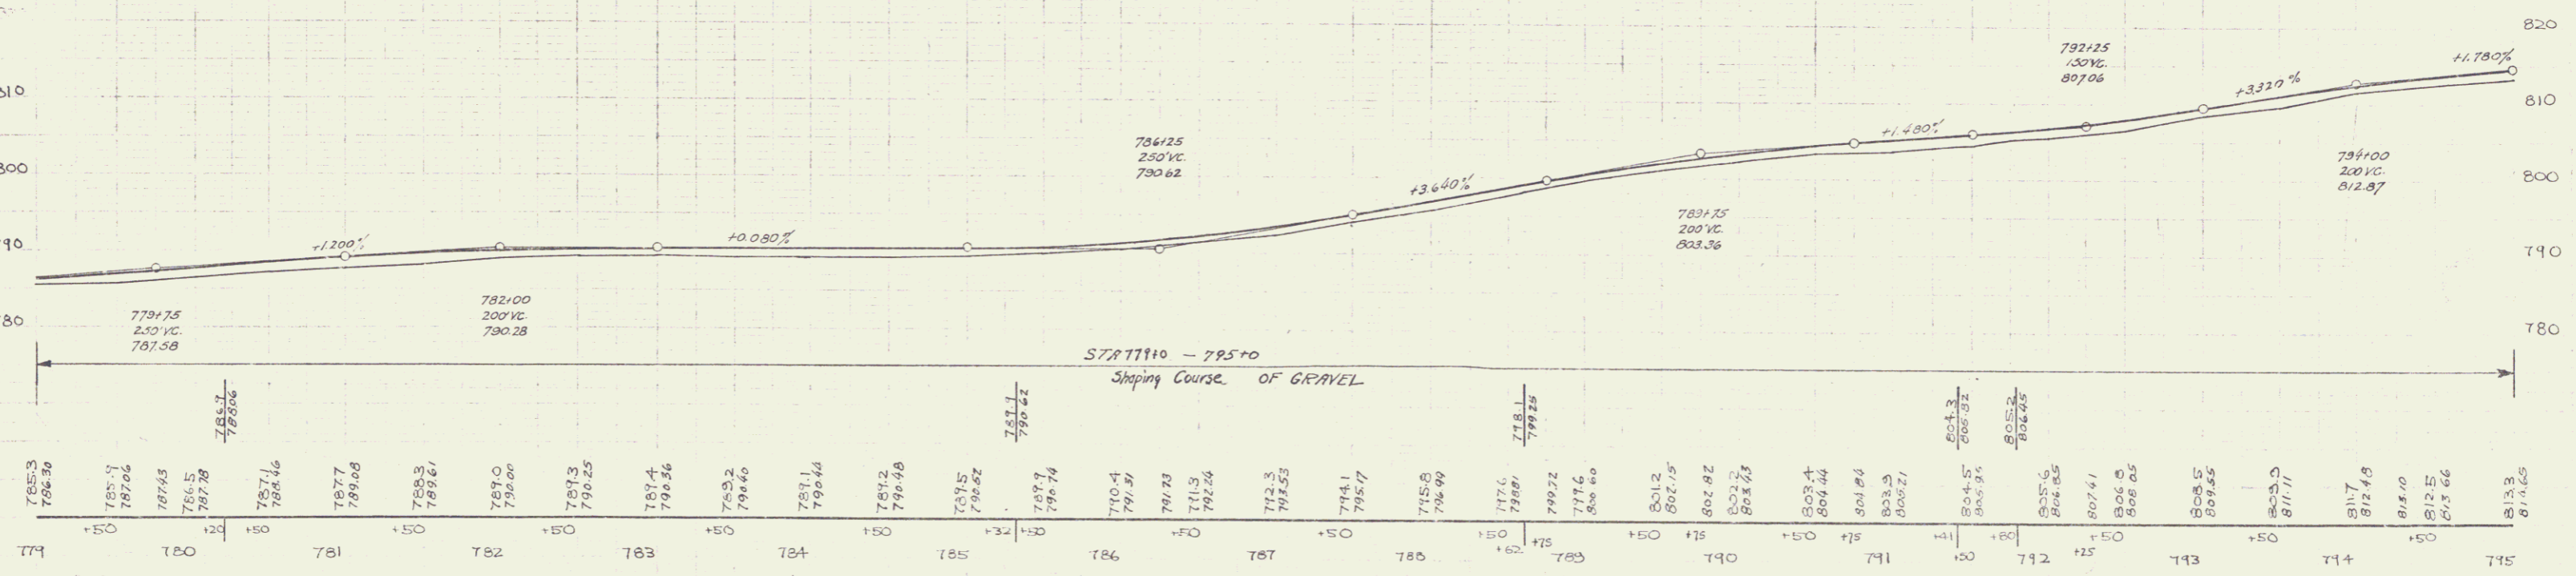

B.M. #33 PAINT SPOT ON BOULDER IN PASTURE 63' RT STA 785+47 EL. 793.99  
 B.M. #34 SPIKE IN ROOT OF 20' TAMARACK, ON LT. STA. 791+69 EL. 80.11

SERIES NO. F.A.P. 138-D  
 SHEET NO. 7 OF 48