



FARRINGTON S/4  
D. MACCHI  
TRAFFIC

FARRINGTON S/4  
D. MACCHI

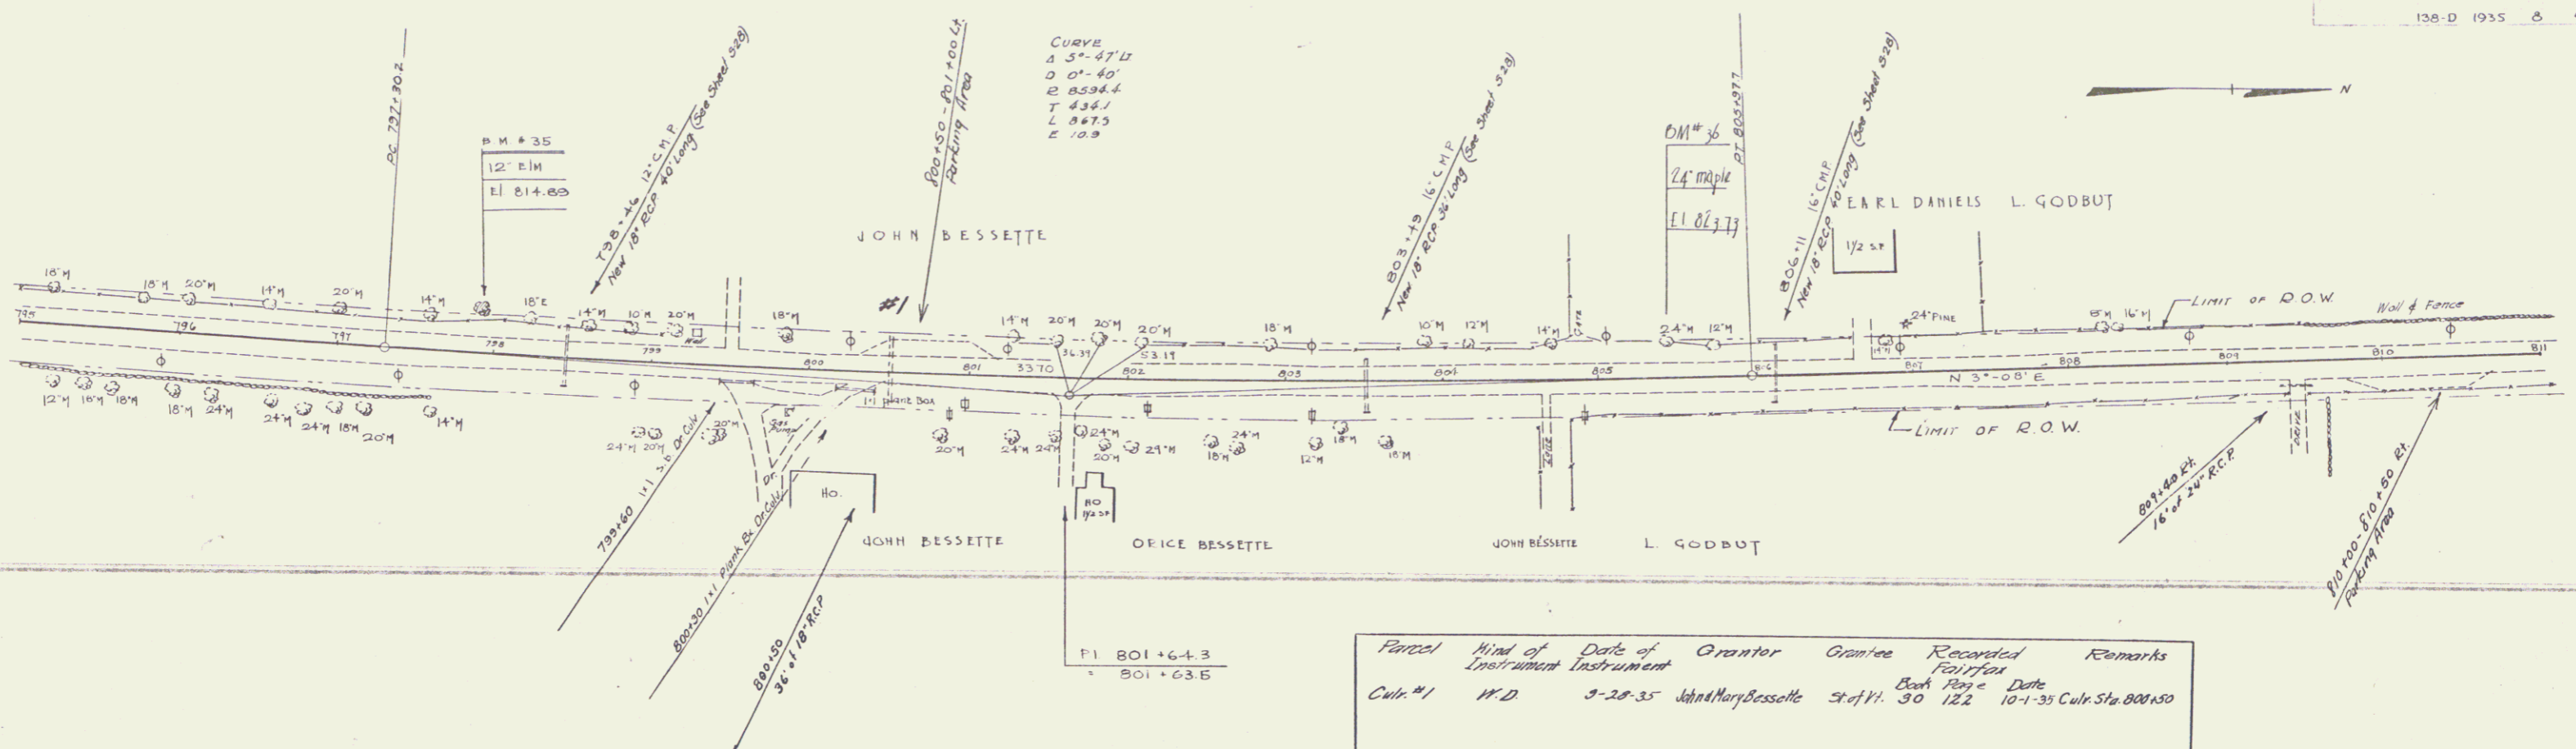

Parcel	Kind of Instrument	Date of Instrument	Grantor	Grantee	Recorded Folio	Remarks
Cul. #1	W.D.	3-28-35	John Mary Bessette	Earl H. Godbut	Book 1891 Page 122	10-1-35 Cul. Sta. 800+50

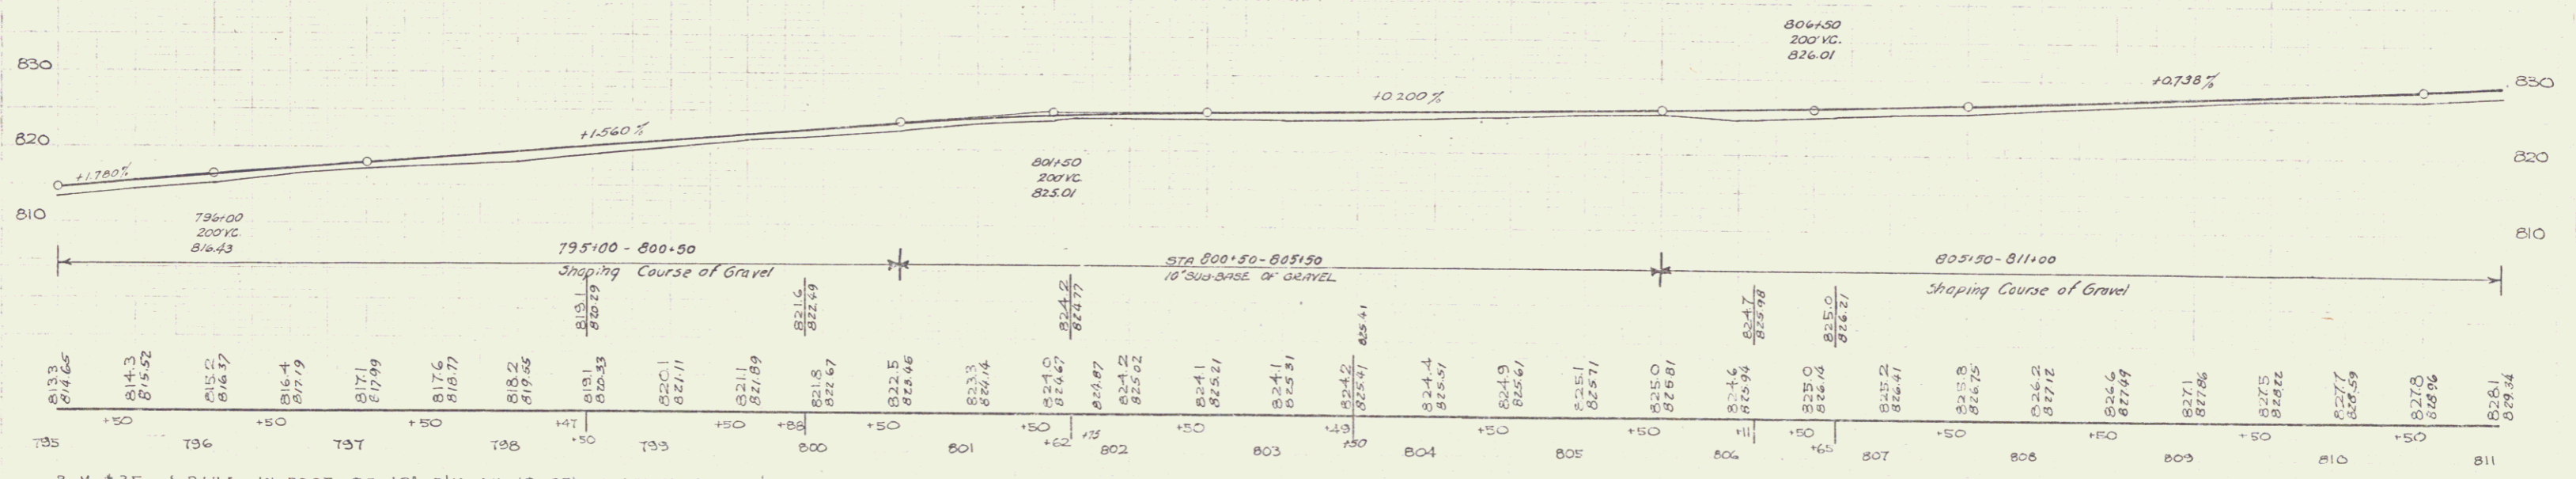

B.M. #35 SPIKE IN ROOT OF 12' ELM ON LT 25' OF STA 797+00 E 814.89  
B.M. #36 SPIKE IN ROOT OF 24' MAPLE ON LT 18' OF STA 805+42 E 823.73

SERIES FAP No 138-D  
SHEET NO 8 OF 48