



WASHINGTON 2/24
D. MACCHI 6/34
TRACED

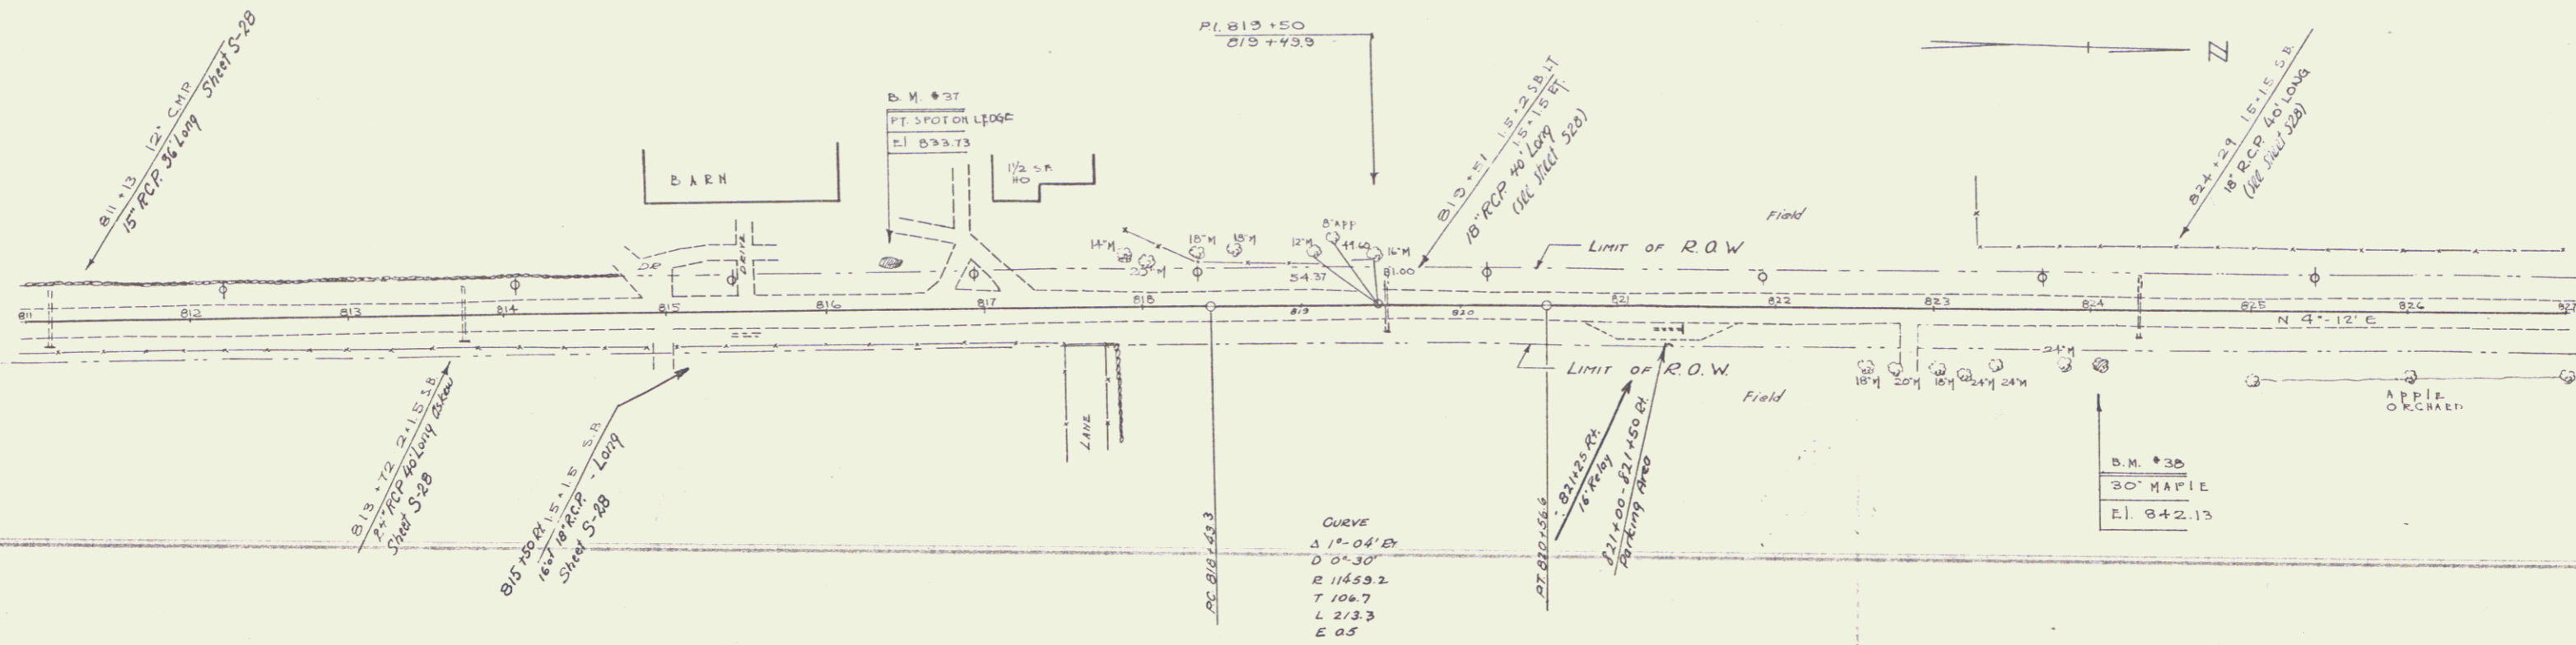

CURVE
 Δ 17° 04' 00"
 D 57.30'
 E 114.53.2
 T 106.7
 L 2/3.3
 E 0.5

D.M. #38
 30' MAPLE
 E. 842.13

WASHINGTON

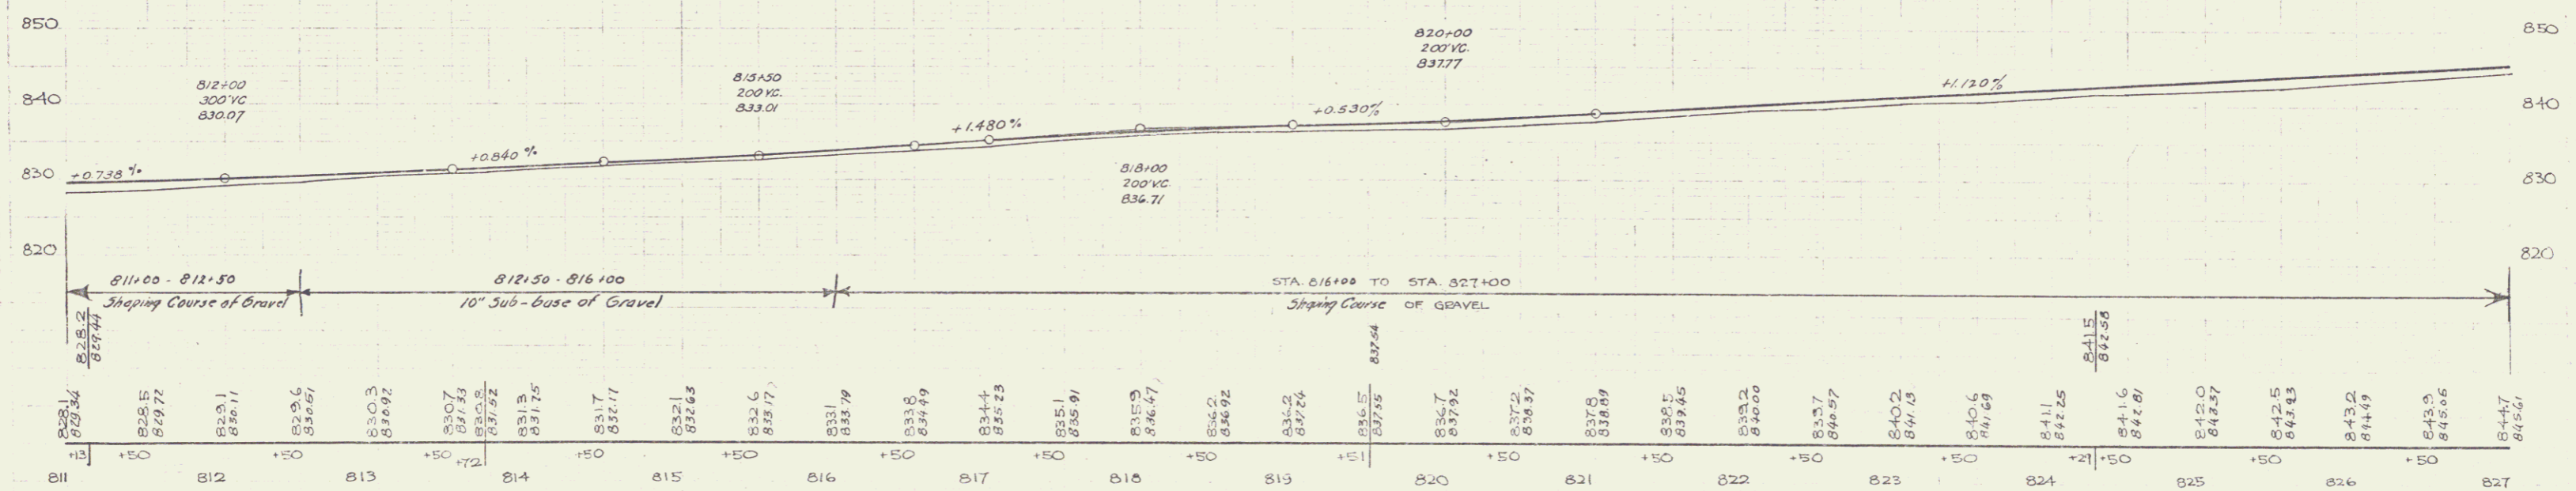

B.M. #37 PAINT SPOT ON LEDGE 27' LT STA 816+40 E. 833.73
 B.M. #38 SPIKE IN ROOT OF 30' MAPLE 31' RT STA 824+04 E. 842.13

SERIES RAR No. 138 D
 SHEET 9 OF 48

7