

CURVE
 Δ 79°-23'1"
 R 0'
 T 716.0
 L 122.4
 L 242.3
 L 70.4

091+11 LT Stone Fill is to be made from boulders encountered on the project


8 1/2" x 4" x 4" Good Cond. Redwood Extend 8 FT 4 1/2" LT with 18" CG MAPLE D.I. @ Top RT (Sheet 328)

8 M[#] 47
 18" Maple
 Elev. 676.17

Sta 899+00.15
 Const. Parking Area on Old Road

ORG. SURV.
 P.I. 891+58.2
 S.D. 148.3
 Δ 0°-0'47"
 D 2°-50'
 REL. SURV. I.R.A. HIBBARD
 207 201+00.9

PARCEL	INSTRUMENT	DATE	GRANTOR	GRANTEE	RECORDED
A	Q.C.D.	9-1-36	CHAS & JOSEPH SHORE	ST. OF VT.	31 430 5-8-30
A	Q.C.D.	9-1-36	J.L. HIBBARD	"	31 432 9-9-30

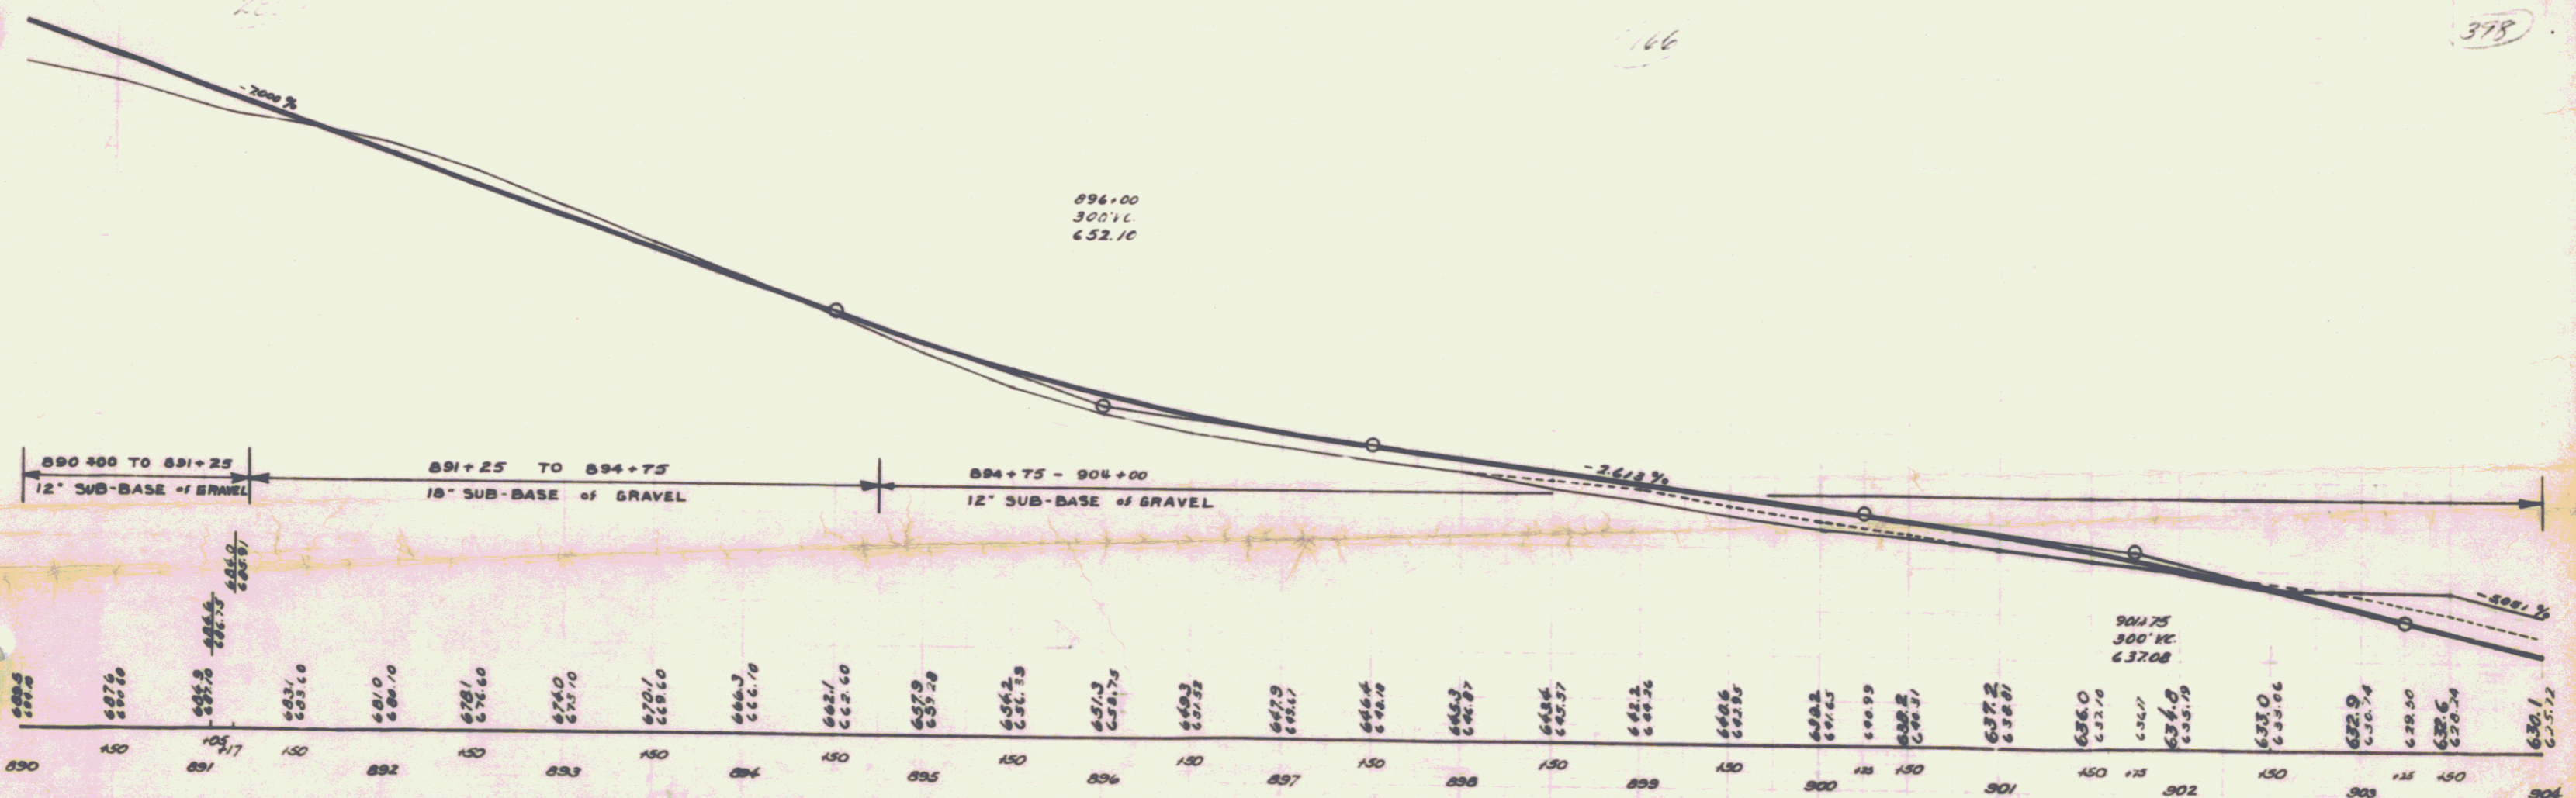

8 M[#] 47 SPIKE IN ROOT OF 18" MAPLE 18' FT LT OF STA. 892+09 ELEV. 676.17
 8 M[#] 48 SPIKE IN ROOT OF 30" MAPLE 17.5 FT RT OF STA. 900+95 ELEV. 637.93