


PARCEL	INSTRUMENT	DATE	GRANTOR	GRANTEE	RECORDED SPRINGFIELD	REMARKS
					BOOK PAGE DATE	
A	WDOE	8-2-41	G. K. GRIGGS	ST. OF VT.	4 69-70 9-5-41	
A'	WDOE	8-9-41	HAZEL EATON	ST. OF VT.	4 73-74 9-16-41	
A''	WDOE	8-8-41	JOHN SHEEHAN	ST. OF VT.	4 71-72 9-15-41	

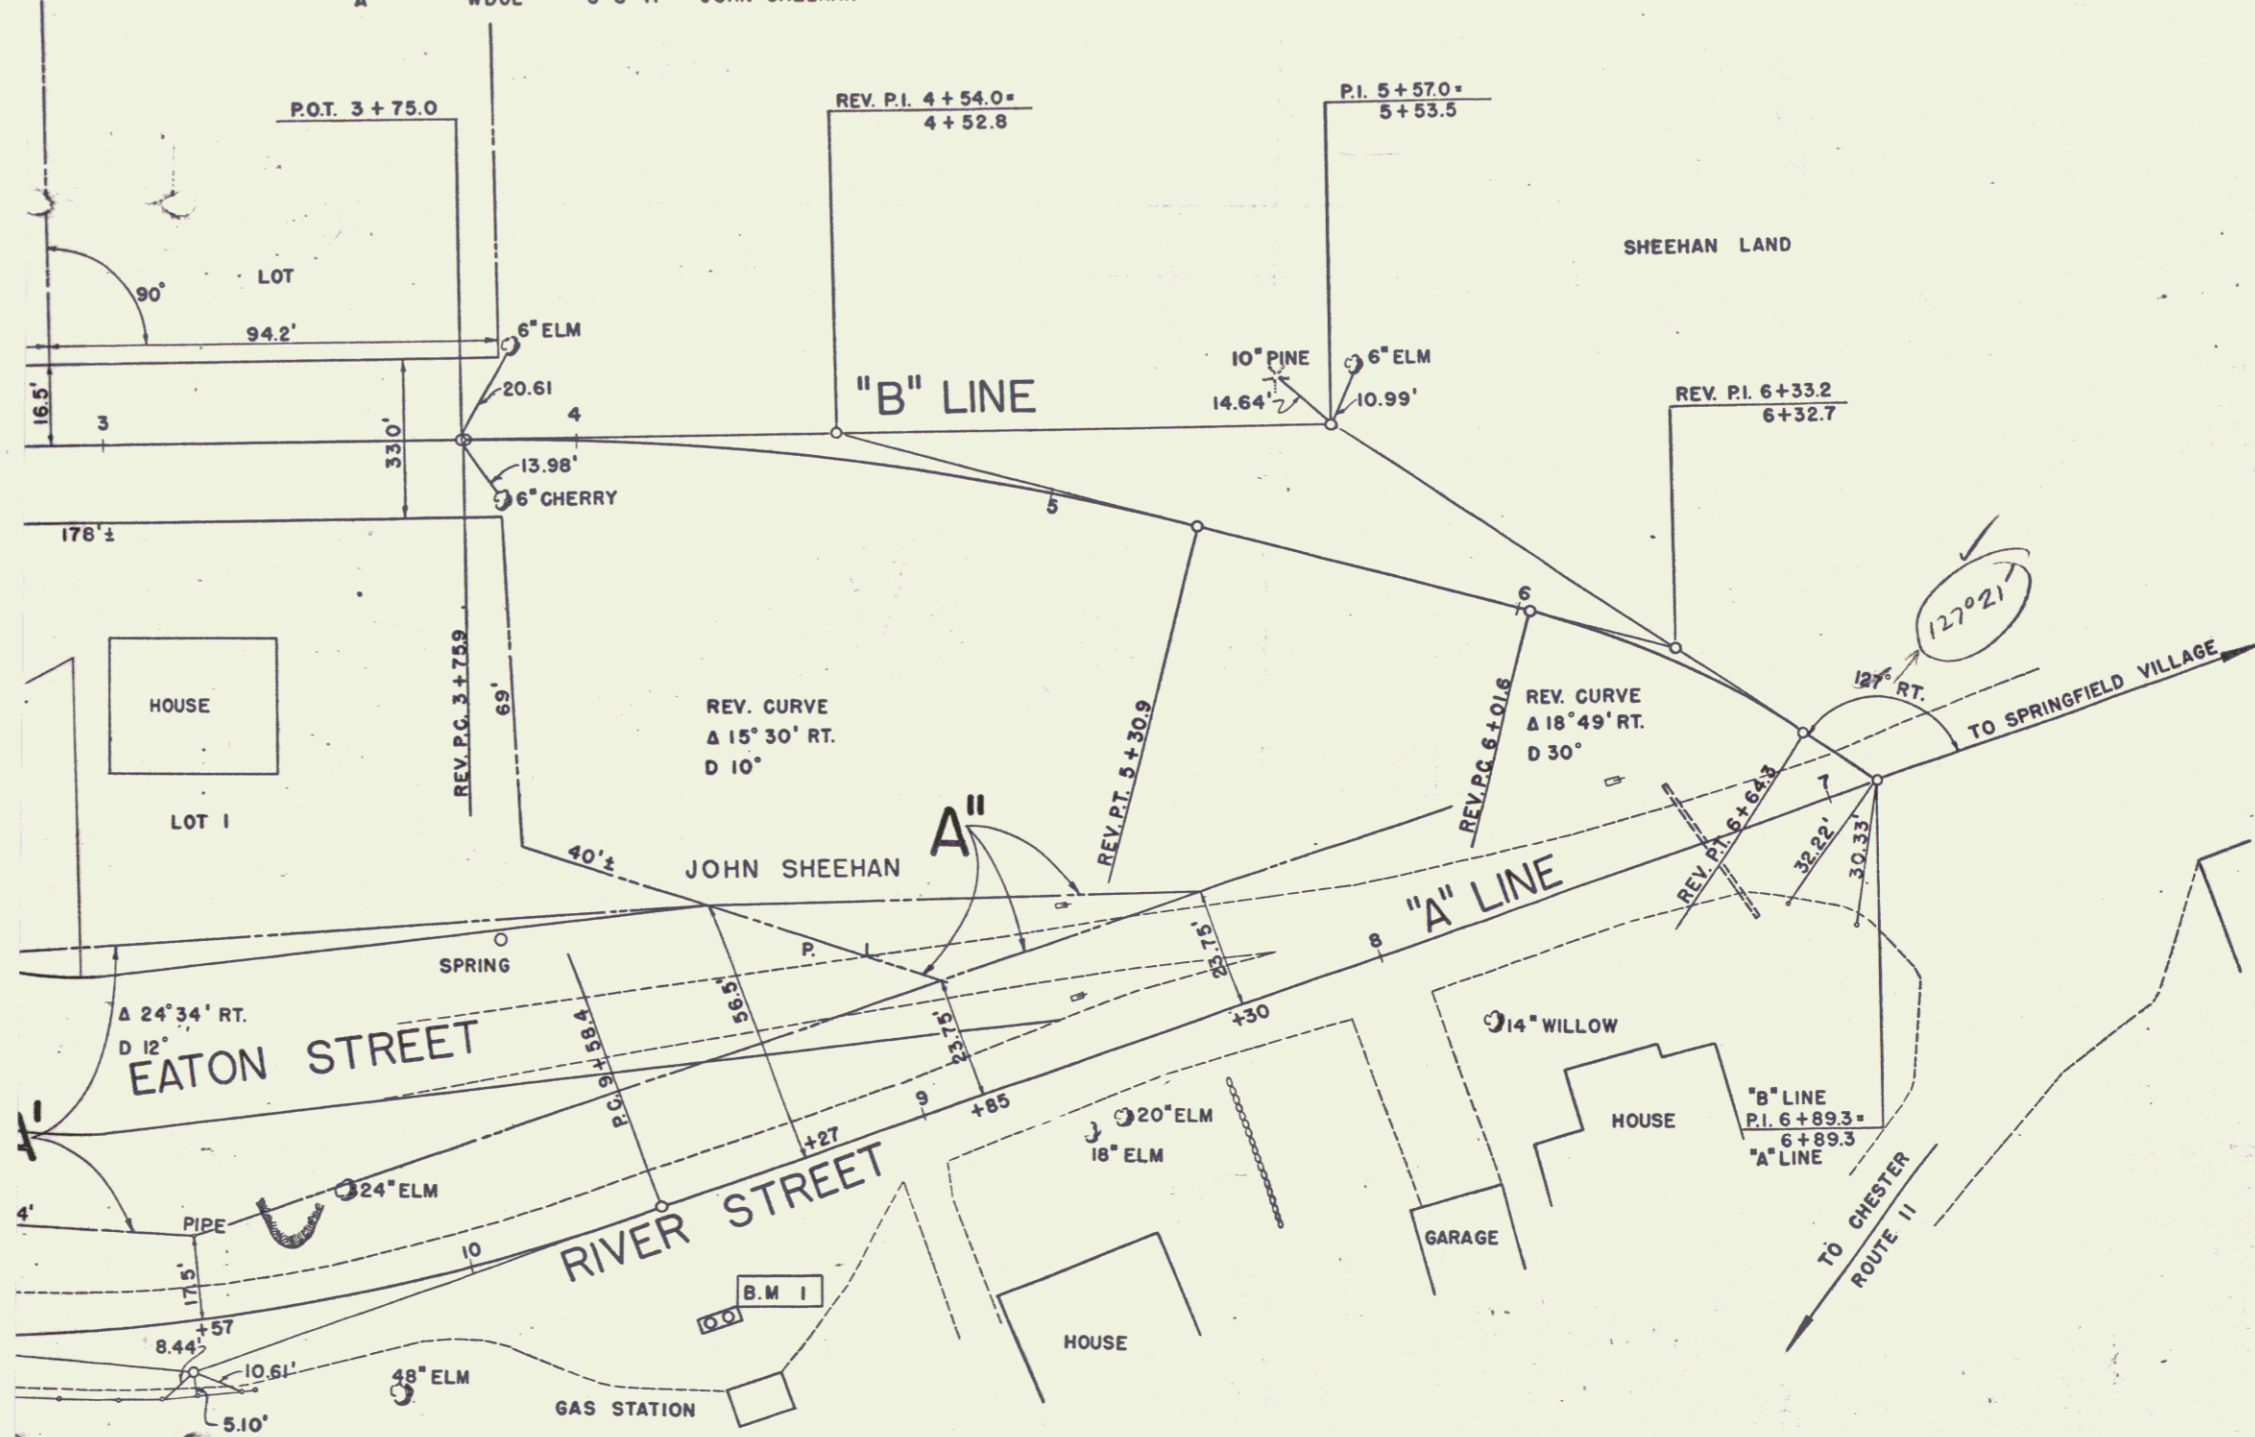

ALIGNMENT OF EATON ST. IN SPRINGFIELD, VERMONT
SCALE: 1" = 20'