

LIMITS OF CLEARING AND GRUBBING ITEM 104
STA. 86+00 TO STA. 87+50 RT. ✓

CONSTRUCT DRIVE
STA. 88+30 LT.
STA. 88+50 RT. ✓
STA. 90+70 RT. ✓
STA. 97+80 RT. ✓

CONSTRUCT APPROACH
STA. 91+40 RT. ✓


THREE-CABLE GUARD-RAIL WITH STEEL POSTS
ITEM 543
STA. 77+25 TO STA. 88+29 LT.
STA. 88+41 TO STA. 91+45 LT.

C. & R. TREE
ITEM 110 ✓

STEEL GUIDE POSTS
ITEM 548 B
STA. 80+00 - 90+90 LT.

GRANITE CURB
86+00 - 88+14.4 LT.
88+204 - 89+04 LT.
89+34 - 90+02 LT.
90+30 - 90+50 LT.
90+54.8 - 92+03.3 LT.
92+33.3 - 94+22.9 LT.
94+53.6 - 95+47.6 LT.
95+77.1 - 96+48.9 LT.
96+71.3 - 98+00 LT.
86+00 - 88+20.4 RT.
88+24.4 - 88+31.0 RT.
88+61 - 90+50 RT.
90+54 - 90+61.8 RT.
91+01.8 - 91+24.8 RT.

PLAN
DATE
SCALE
BY
CHECKED
APPROVED
TRACES

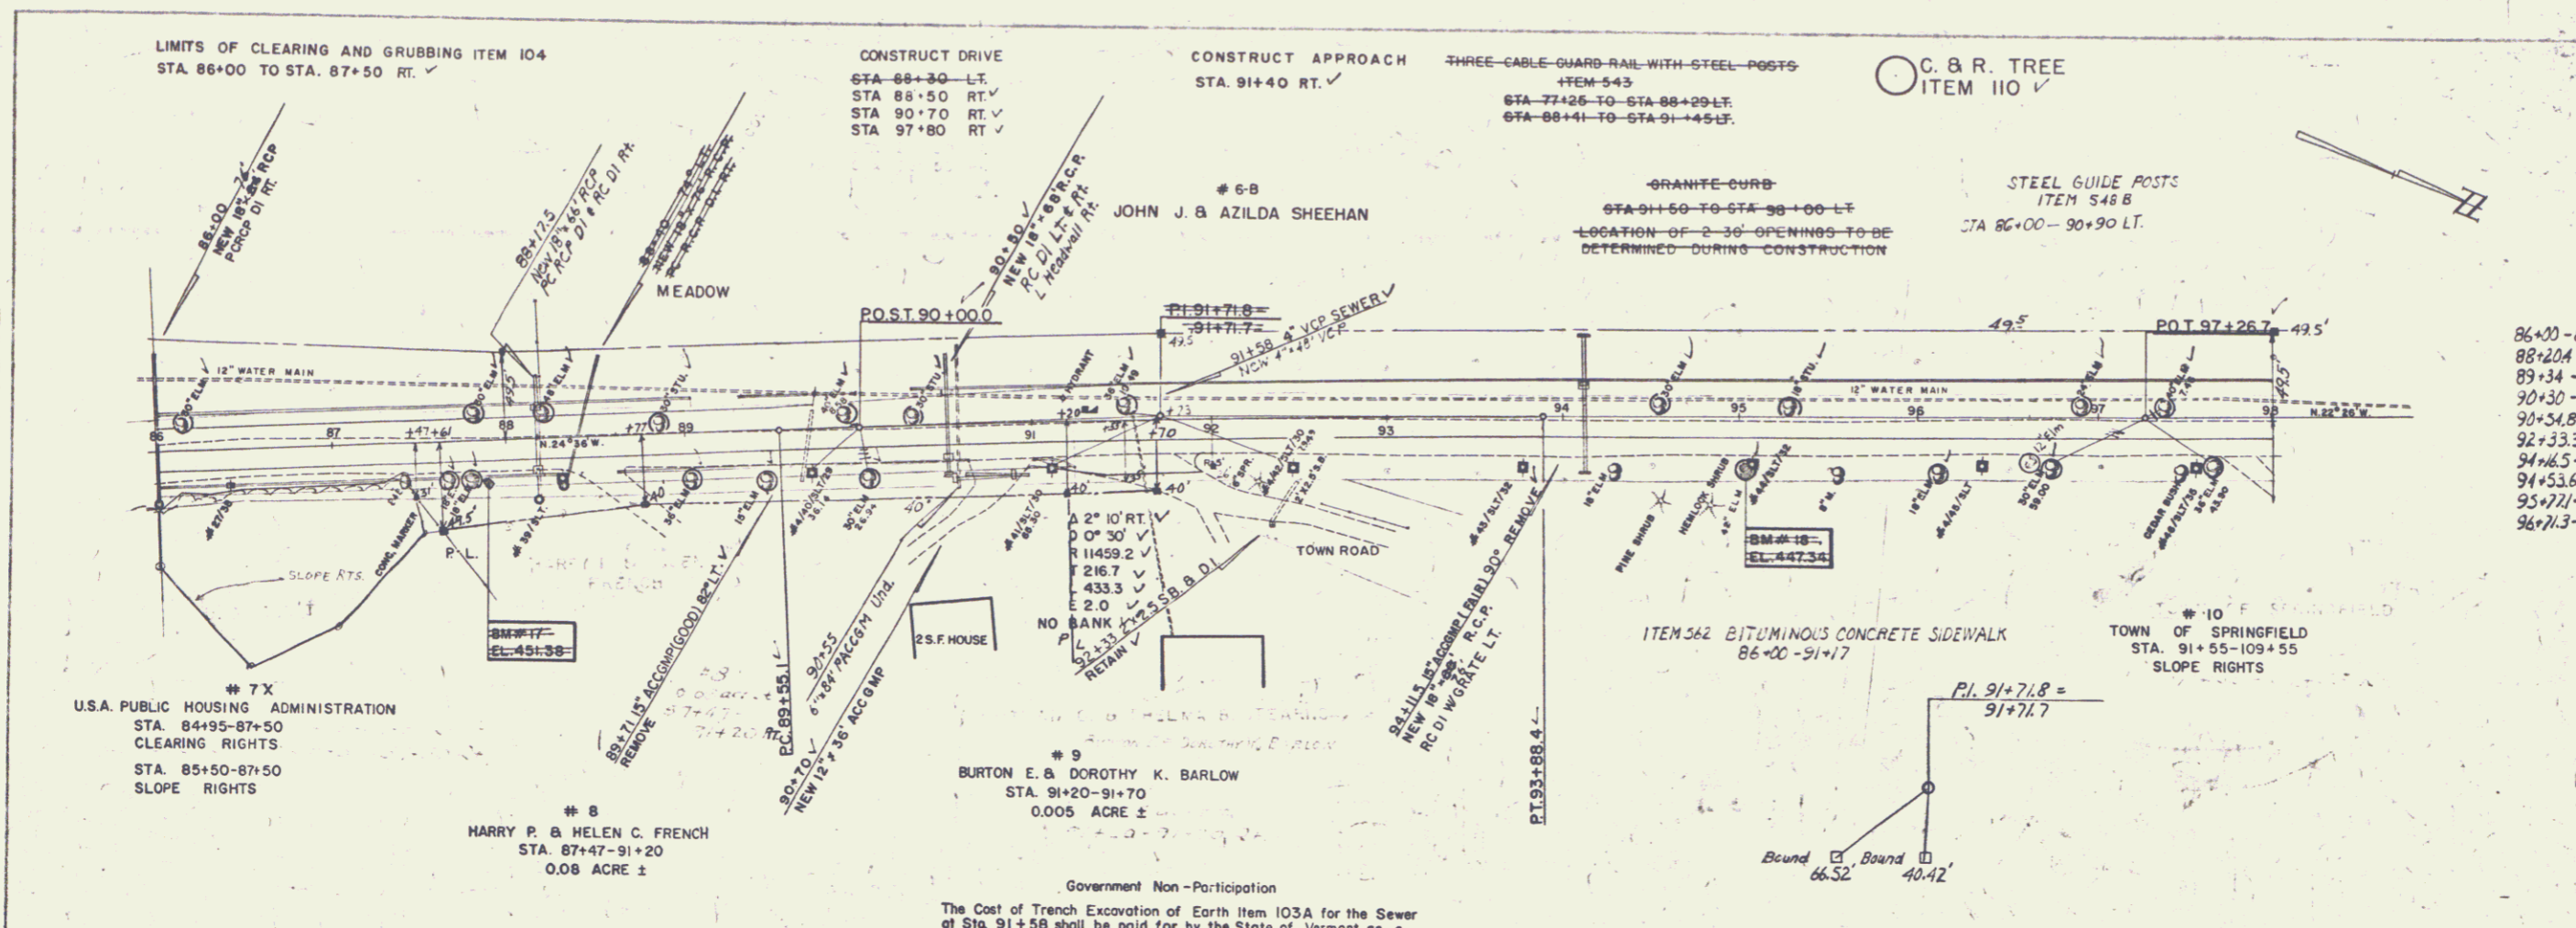

** 7X
U.S.A. PUBLIC HOUSING ADMINISTRATION
STA. 84+95-87+50
CLEARING RIGHTS
STA. 85+50-87+50
SLOPE RIGHTS


** 8
HARRY P. & HELEN C. FRENCH
STA. 87+47-91+20
0.008 ACRE ±

** 9
BURTON E. & DOROTHY K. BARLOW
STA. 91+20-91+70
0.005 ACRE ±

** 10
TOWN OF SPRINGFIELD
STA. 91+55-109+55
SLOPE RIGHTS

Government Non-Participation
The Cost of Trench Excavation of Earth Item 103A for the Sewer at Sta. 91+58 shall be paid for by the State of Vermont as a Government Non-Participating Item.

PARCEL	GRANTOR	NATURE OF TITLE	DATE	TOWN	RECORDING VOL.	DATA PAGE	DATE	
1-A,B,C	ALBINA YAROSEVICH-OTTEN BIRSKY							
D,E	ALPHONSE BIRSKY-BOLESLOF BIRSKY	COND.	10-13-55	SPRINGFIELD	4	260-264	10-14-55	SEE SPRINGFIELD F 123 (10)
7 X	UNITED STATES OF AMERICA, PUBLIC HOUSING ADMINISTRATION							
8	HARRY P. & HELEN C. FRENCH	COND.	10-13-55	SPRINGFIELD	4	260-264	10-14-55	SEE SPRINGFIELD F 123 (10)
9	BURTON E. & DOROTHY K. BARLOW	W.D.O.E.	2-28-56	SPRINGFIELD	5	10-11	3-19-56	
10	TOWN OF SPRINGFIELD	W.D.O.E.	2-28-56	SPRINGFIELD	5	11	3-19-56	
		C.C.D.O.E.	2-29-56	SPRINGFIELD	5	12	3-19-56	SLOPE RIGHTS SEE SHEET 12

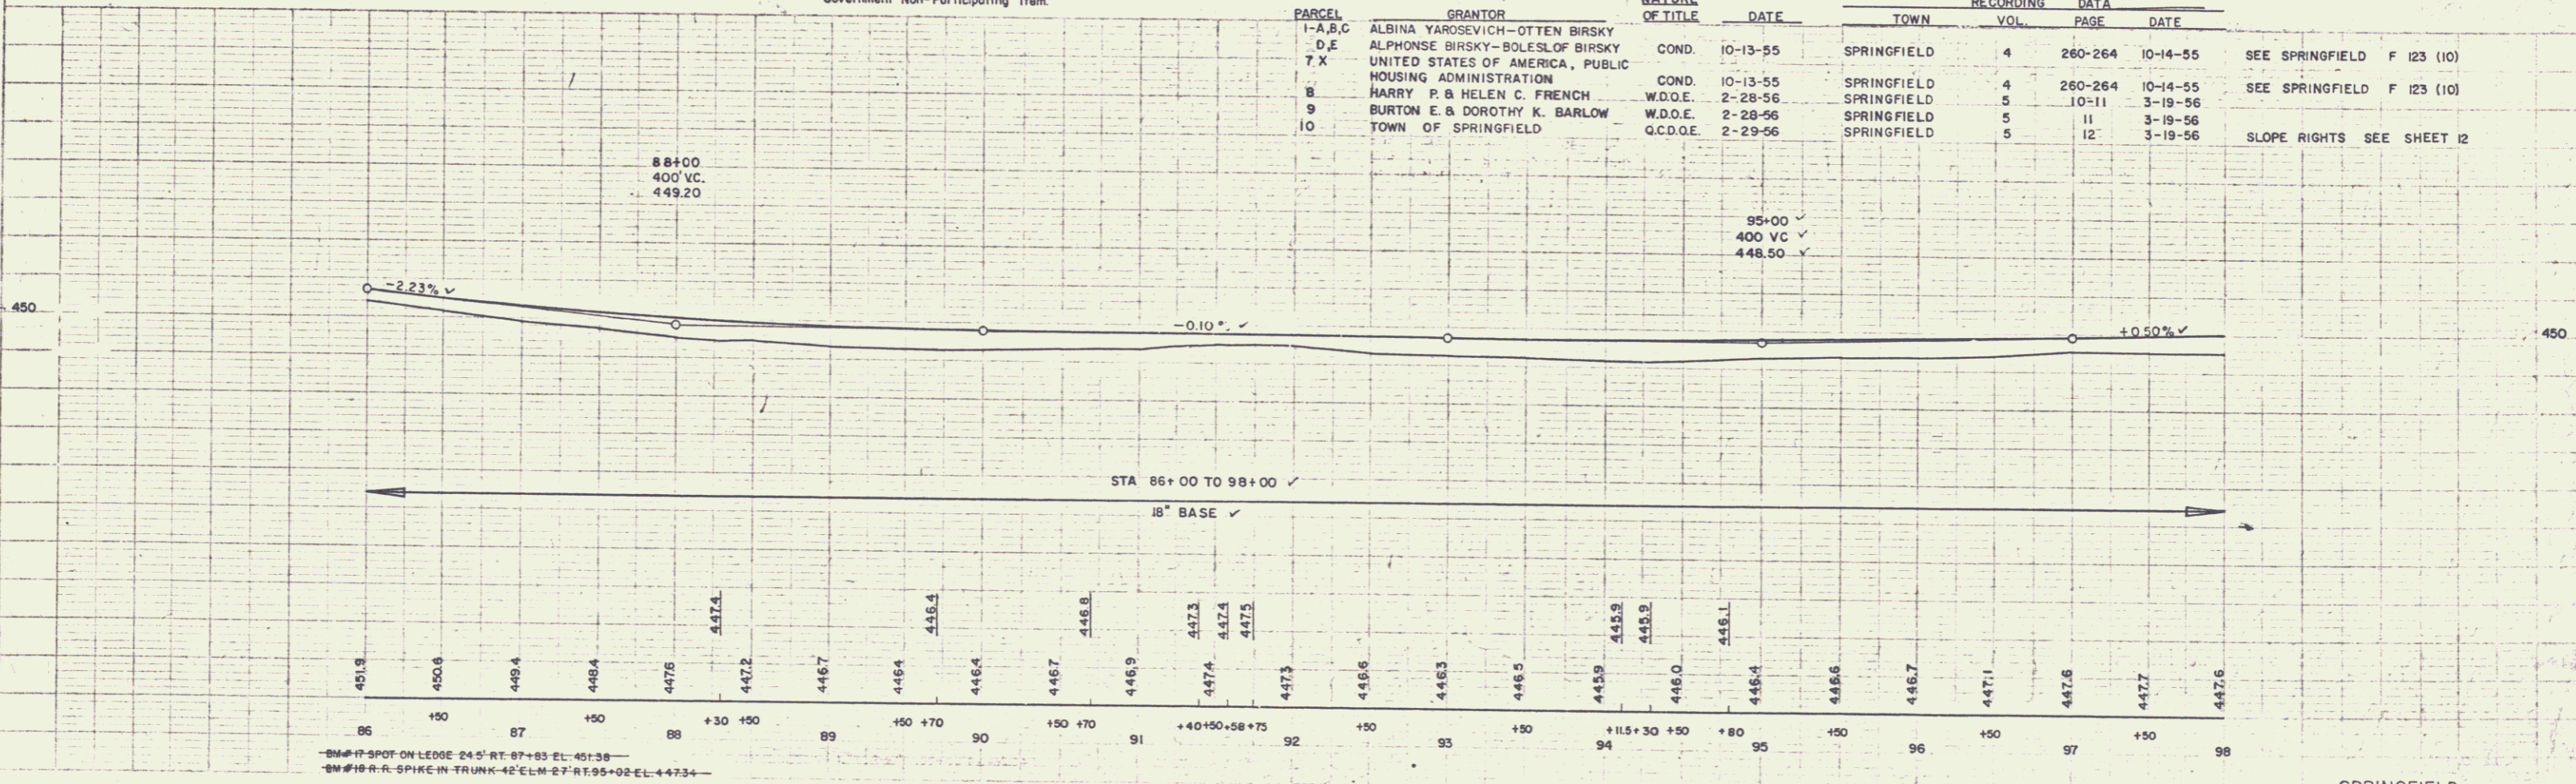

BM#17 SPOT ON LEDGE 24.5' RT. 87+83 EL. 451.38
BM#10 R-R SPIKE IN TRUNK 42' ELM 27' RT. 95+02 EL. 447.34

SPRINGFIELD
THE CLARKESON ENGINEERING CO., INC.
CONSULTING ENGINEERS
BOSTON MASSACHUSETTS
SHEET 11 OF 114

6