


PARCEL	GRANTOR	NATURE OF TITLE	DATE	TOWN	VOL.	PAGES	DATE	RECORDING DATA
13	ETHEL L. DAY	COND.	10-13-55	SPRINGFIELD	4	260-264	10-14-55	CHANNEL RIGHTS
20 A, B	FRANK D. & ESSIE L. CHITTENDEN	W. D.	10-2-53	SPRINGFIELD	53	388-399	10-9-53	CULVERT RIGHTS - SEE SHEET 13, 15
C, D	ALFRED A. & MILDRED M. PELKEY	W.D.O.E.	9-21-56	SPRINGFIELD	56	203-204	10-11-56	GRADE CHANGE - SEE SHEET 15

NOTE: STATE OF VT. TO JOSEPH CERNIGLIA
 BY Q.C.D. DATED 4/9/80 AND RECORDED
 ON JUNE 5, 1980 IN BOOK 77 PG. 584 IN
 THE SPRINGFIELD LAND RECORDS.

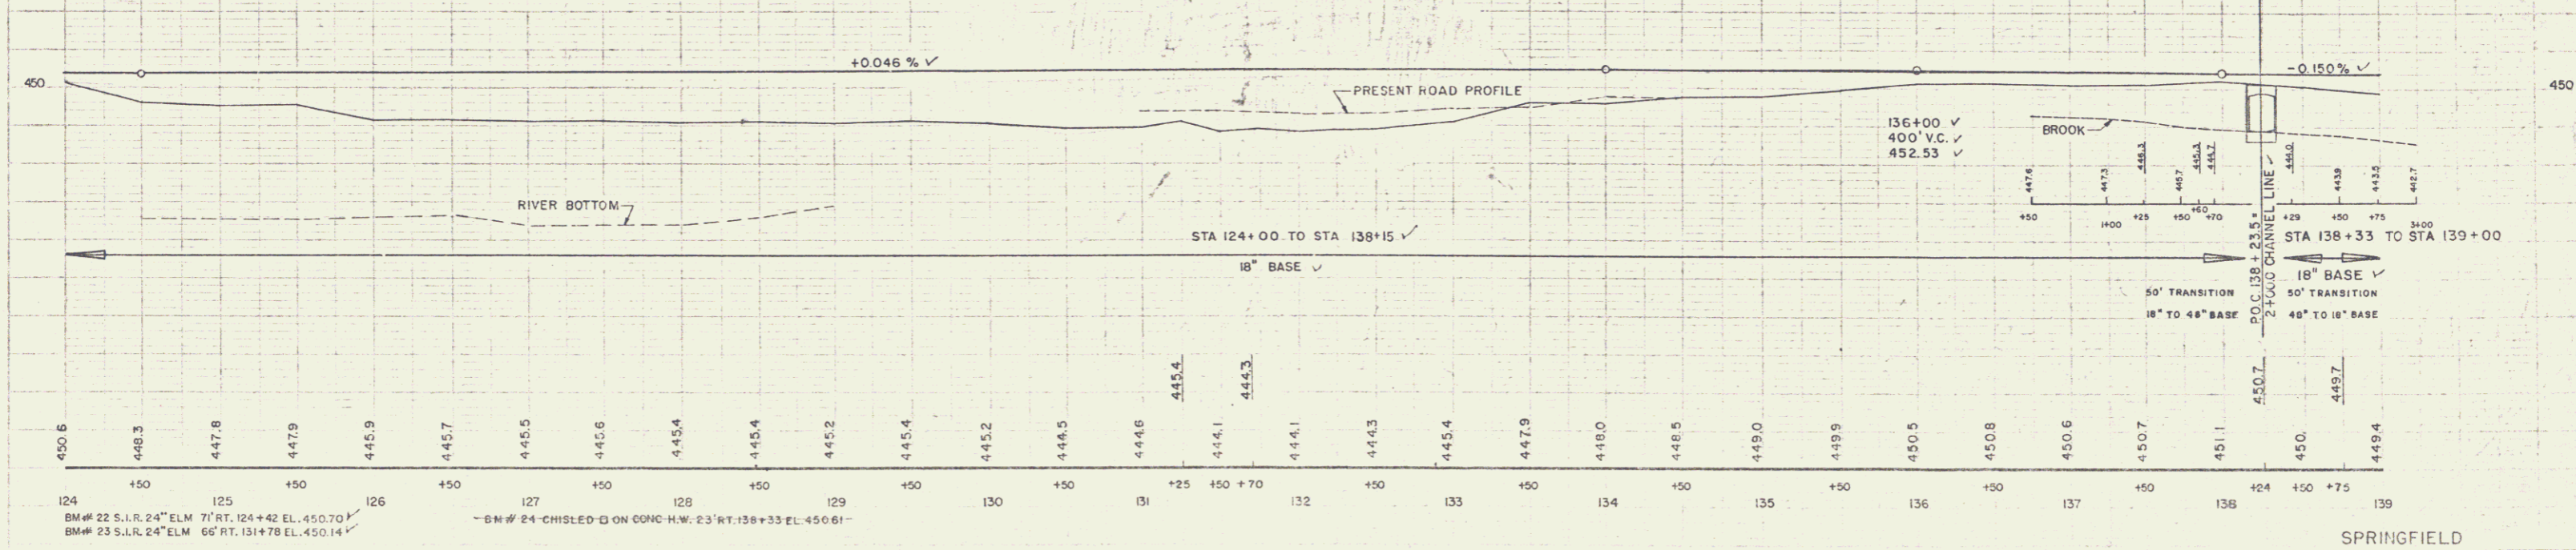

BM# 22 S.I.R. 24" ELM 7' RT. 124+42 EL. 450.70
 BM# 23 S.I.R. 24" ELM 66' RT. 131+78 EL. 450.14
 BM# 24 CHISEL D ON CONC. H.W. 23' RT. 138+33 EL. 450.61